

HARPER PERKINS ARCHITECTS, INC.

4724 Old Jacksboro Highway
Telephone 940.767.1421

Wichita Falls, Texas 76302-3599
Facsimile Number 940.397.0273

ADDENDUM NO. 2

To the Drawings and Project Manual dated 16 June 2017

for

**TAS/ADA FIRE MARSHAL
DEFERRED MAINTENANCE PROJECTS
MIDWESTERN STATE
UNIVERSITY**

3410 Taft Boulevard
Wichita Falls, Texas



EXP. DATE: 25 AUGUST
DATE SIGNED: 10 August 2017

Addendum Date: 10 August 2017

NOTICE TO PROPOSERS:

This Addendum will be considered a part of the Contract Documents for the above referenced project as though it had been issued at the same time and incorporated integrally therewith. Where provisions of the following supplementary data differ from those in the original Contract Documents, this Addendum shall govern and take precedence.

Proposers are hereby notified that they shall make any necessary adjustments in their estimates on account of this Addendum. It will be construed that such Proposer's Competitive Sealed Proposal is submitted with full knowledge of all modifications and supplementary data specified herein.

ITEM 1 - AD#2: To the Project Manual and Drawings.

ADD: A Pre-Bid Conference was held in Room C-111 of the Fain Fine Arts Building on August 7, 2017 at 10:00 a.m. – the Conference also included a walk-through of the Bolin Science Hall, Fain Fine Arts Building, Ferguson Building, Hardin Administration Building, and associated Sites. A “pdf” file of the Sign-In Sheets from the Conference are available for download from the MSU Website at <https://mwsu.edu/purchasing/>.

ITEM 2 - AD#2: To the Drawings, Sheets “B-A303”, “FF-A304”, and “FF-A305”.

ADD: As clarification, the steel mesh infill for the handrailing shall 2 x 2 x 12 gauge mesh.

ITEM 3 - AD#2: To the Drawings, Sheet “B-AD101”, “Building Plan – Bolin Science Hall – First Floor – Demolition” and Sheet “B-A101”, “Building Plan – Bolin Science Hall – First Floor – New”; and the Project Manual, Section 099990, **FINISH SCHEDULE**.

ADD: As clarification, the existing ceiling is being removed in its entirety in the “Corridor 1CORR4” space. A new 2x2 suspended acoustical ceiling (new tiles and grid above) is being installed (refer to the Reflected Ceiling Plan on Sheet “B-A703”) and existing light fixtures and HVAC diffusers/grilles being reused and installed in the new ceiling (refer to the MEP drawings).

ADD: The existing ceiling in “Computer Lab 133” shall be removed completely – salvage and maintain all existing

light fixtures, HVAC diffusers/grilles, and devices in the ceiling for reinstallation. Provide a new 2x2 suspended acoustical ceiling (new tiles & grid) in the space.

ADD: As clarification, new 2x2 suspended ceilings shall be provided in “**Vestibule 1VEST1**”, “**West Corridor 1CORR1**”, and “**Vestibule 1VEST4**” (refer to the Reflected Ceiling Plans on Sheets “**B-A702**” and “**B-A703**”) and shall include new ceiling tiles and a new suspended grid system.

ITEM 4 - AD#1: To the Drawings, Sheet “**H-AD103**”, “**Floor Plan – First Floor – Hardin Administration Building – Area “H-1A” – Demolition**”

ADD: As clarification, the existing suspended “cloud” ceiling above the Stage area shall be lowered to accommodate the installation of the new Fire Sprinkler System piping. Also disconnect the existing light fixtures. Protect the ceiling and fixtures from damage during the new work. After installation of the new lines is complete, raise the ceiling to its original position and reconnect the light fixtures and restore to their original working condition.

ADD: Protect the existing wood flooring at the Stage area during the installation of the new Fire Sprinkler System piping. Any damage to the flooring during the installation work shall be repaired or replaced as necessary with matching materials and finish.

ADD: No mechanical lift of any kind shall be used on the Stage to perform this work – only scaffolding will be allowed.

ITEM 5 - AD#1: To the Drawings, Sheet “**H-FP101**”, “**Hardin Admin Building – First Floor – Area 1A Fire Protection Plan**”

ADD: As clarification, a new 4” Fire Sprinkler line is being extended and connected to the Main Water Service Line located west of the Building. Any existing asphalt paving that is disturbed and removed as part of this line installation shall be patched as necessary with matching materials upon completion of the work.

ITEM 6 - AD#1: To the Project Manual, Section **012100, ALLOWANCES**.

ADD: An allowance of \$10,000 shall be included for the provision of new ceilings that must be removed for the installation of new Fire Sprinkler System lines. The provision of several new ceiling areas have already been identified in the Drawings or Project Manual. The funds from this allowance can be used when approved in writing by the Owner after consultation with the Architect and Owner. Any unused funds in this allowance will be returned to the Owner at the end of the project.

ITEM 7 - AD#1: To the Project Manual, Section **012300, ALTERNATES**.

ADD: An **Alternate #2**, adding a Fire Sprinkler System below the existing Stage area in Akin Auditorium in the Hardin Administration Building. Refer to the MEP Drawings from Campos Engineers attached with this Addendum for more information.

ITEM 8 - AD#1: To the Project Manual, Section **012300, ALTERNATES**; and the Drawings, Sheets “**FF-AD105**”, “**FF-A105**”, “**A501**”, and “**A502**”.

ADD: An **Alternate #3** which shall be all work associated with the removal of the existing sloped glazing system (existing steel tube joists and steel tube/pipe framing are to remain in place) and the provision of the new sloped glazing system (Opening **#FF21**) as indicated.

DELETE: On Sheet “**A502**”, the opening details “**A502-18**” as indicated.

ADD: Opening details “**A502-18**” as indicated on Supplemental Drawings “**AD#2-01**” through “**AD#2-05**” attached with this Addendum.

ITEM 9 - AD#1: To the Drawings, Sheet “**A501**”, “**Opening Schedules**”.

DELETE: On the “**Opening Schedule – Bolin Science Hall**” under Openings **#B3**, **#B4**, **#B12**, **#B14**, **#B16**, and **#B17**, the indication of glazing type “**3**”.

ADD: These openings shall have glazing type “**4**”.

DELETE: On the “**Opening Schedule – Fain Fine Arts**” under Opening **#FF19**, the indication of glazing type “**3**”.

ADD: This opening shall have glazing type “**4**”.

ITEM 10 - AD#1: To the Drawings, **Mechanical Drawings**; and the Project Manual, Section **099100, PAINTING**.

ADD: Exposed mechanical piping and conduit in equipment and occupied spaces shall be painted as specified on page **099100-7**, part **3.3(F) & (G)**.

ITEM 11 - AD#2: To the Project Manual, Section **099990**, **FINISH SCHEDULE KEY**.

DELETE: On page **099990-1** under floor finish “**1B**”, the word “**Polished**”.

ADD: As clarification, the floor finish “**1B**” shall be “**Exposed Stained Concrete – Sealed**”.

ITEM 12 - AD#2: To the Project Manual, Section **012300**, **ALTERNATES**, and Drawings, Sheet “**B-A105**”, “**Enlarged Floor Plan – Bolin Science Hall – Third Floor – Area “B-3B” – New**”; and Sheet “**B-A106**”, “**Enlarged Floor Plan – Bolin Science Hall – First Floor – Area “B-1C” – New**”; and “**Floor Plan – Keynotes**”.

DELETE: In keynote **#17**, the indication of a wood handrailing.

ADD: As clarification and as part of the **Base Bid**, provide aluminum handrailing as specified in Section **055200**, **ALUMINUM HANDRAILS AND RAILINGS**. All wall mounted handrailing shall turn 90 degrees and return to the wall on each end.

ADD: **Alternate #4** which shall provide painted 1¼” diameter steel pipe handrailing is (1.66” O.D.). At locations in which the Stairs have “open sides”, provide 2 x 2 x 12 gauge mesh infill with a 1”x1”x1/8” perimeter steel frame. The bottom railing shall be located 2” above the stair treads. All wall mounted handrailing shall turn 90 degrees and return to the wall on each end.


ITEM 13 - AD#2: To the Mechanical/Electrical/Plumbing (MEP) Drawings.

ADD: The attached Addendum and associated revised drawings from Campos Engineering.

ITEM 14 - AD#2: To the Drawings, Sheet “**B-AD106**”, “**Enlarged Floor Plan – Bolin Science Hall - First Floor – Area “B-1C” – Demolition**”.


ADD: As clarification, the existing wall material associated with the demolition work at “**Vestibule 1VEST3**” and “**Lecture Hall 127**” is as indicated on the “**Enlarged Floor Plan – Bolin Science Hall - First Floor – Area “B-1C” – New**” on Sheet “**B-A106**”.

END OF ADDENDUM NO. 2

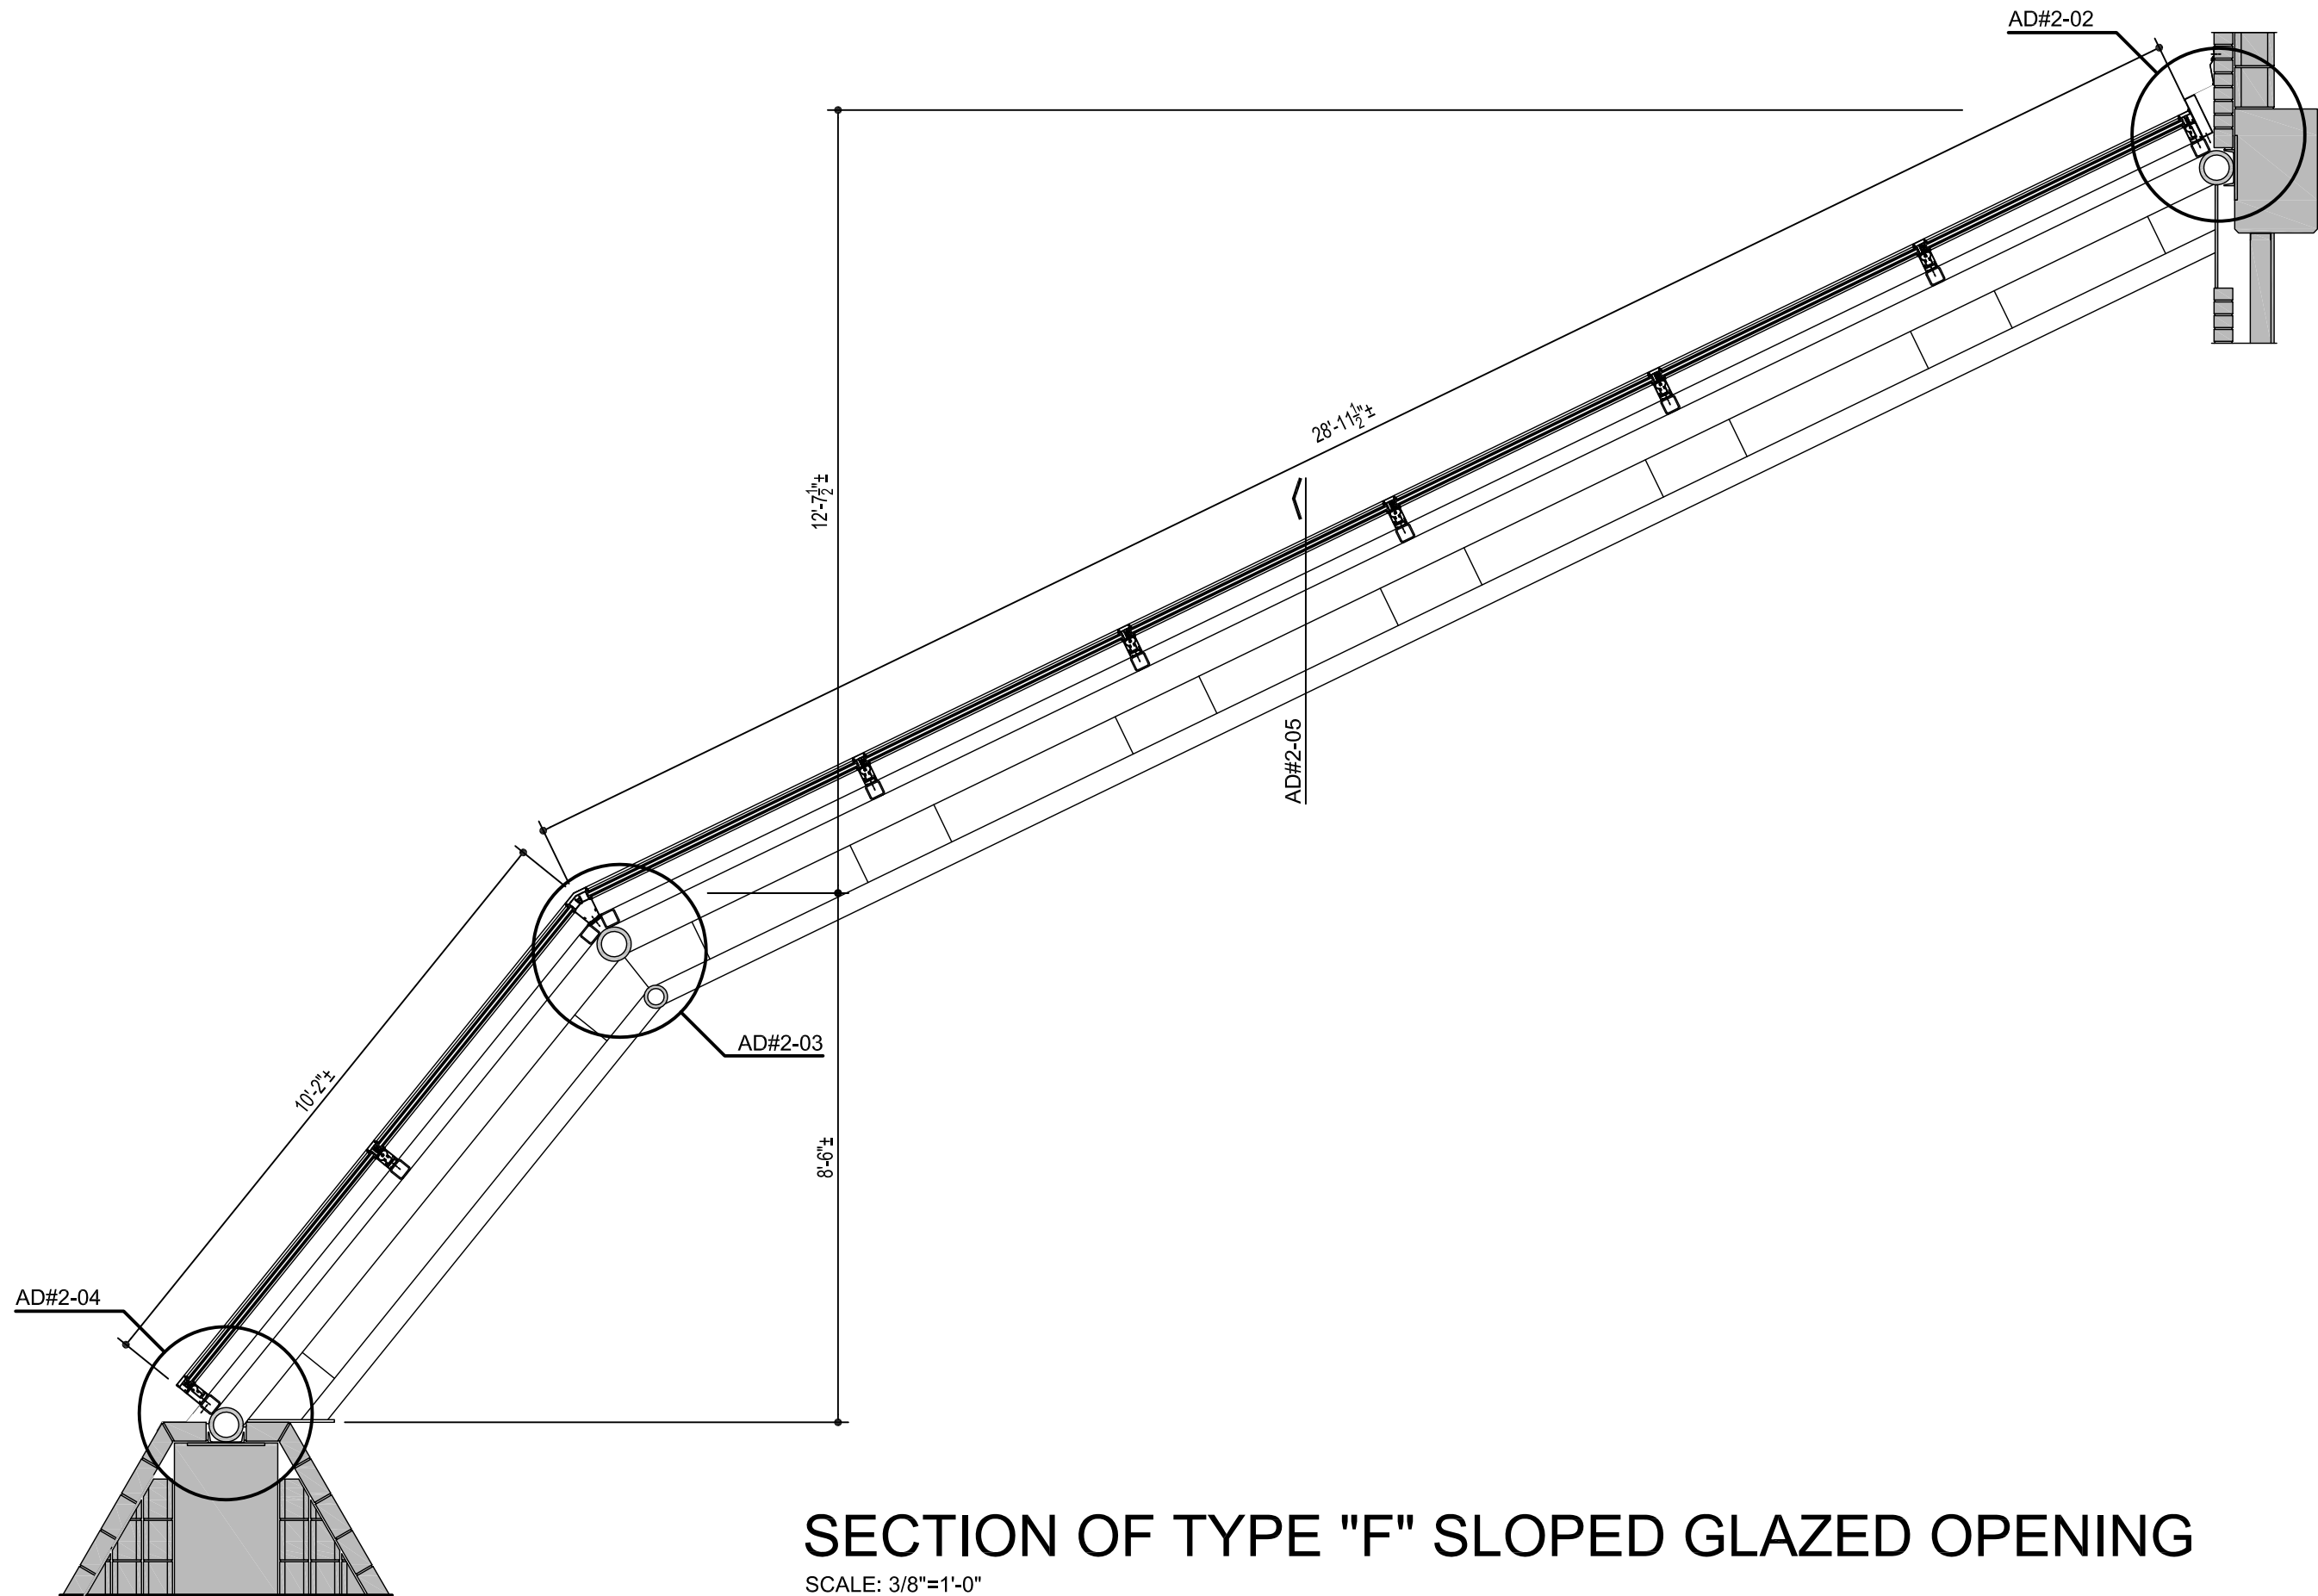


SECTION OF TYPE "F" SLOPED GLAZED OPENING

SCALE: 3/8"=1'-0"

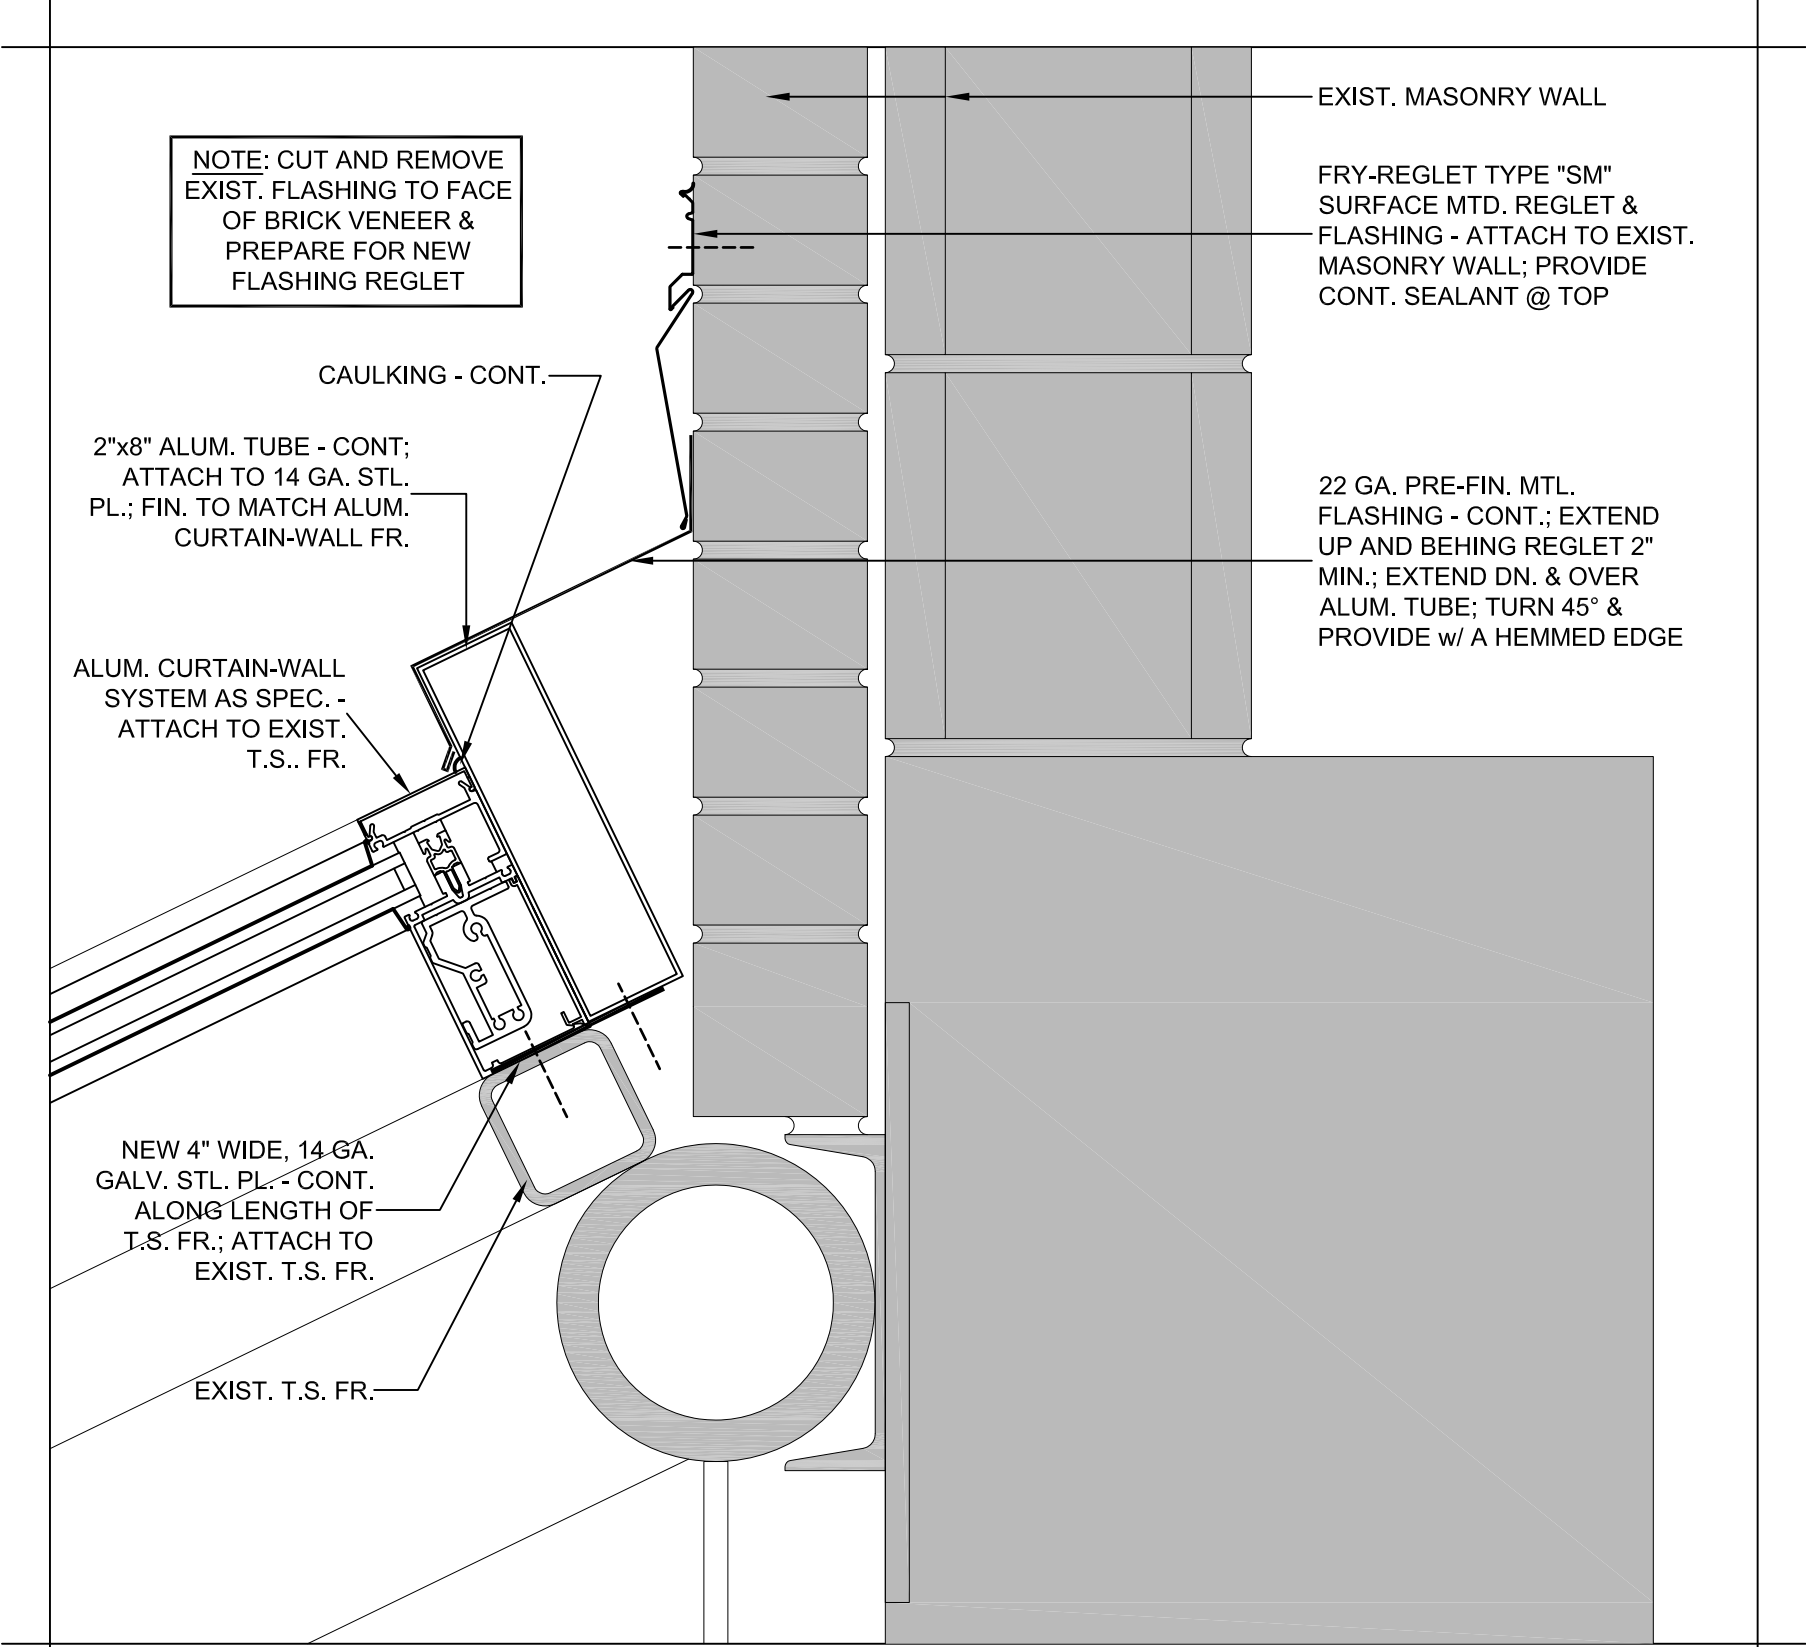


TOP OF TYPE "F" SLOPED GLAZED OPENING

SCALE: 3"=1'-0"

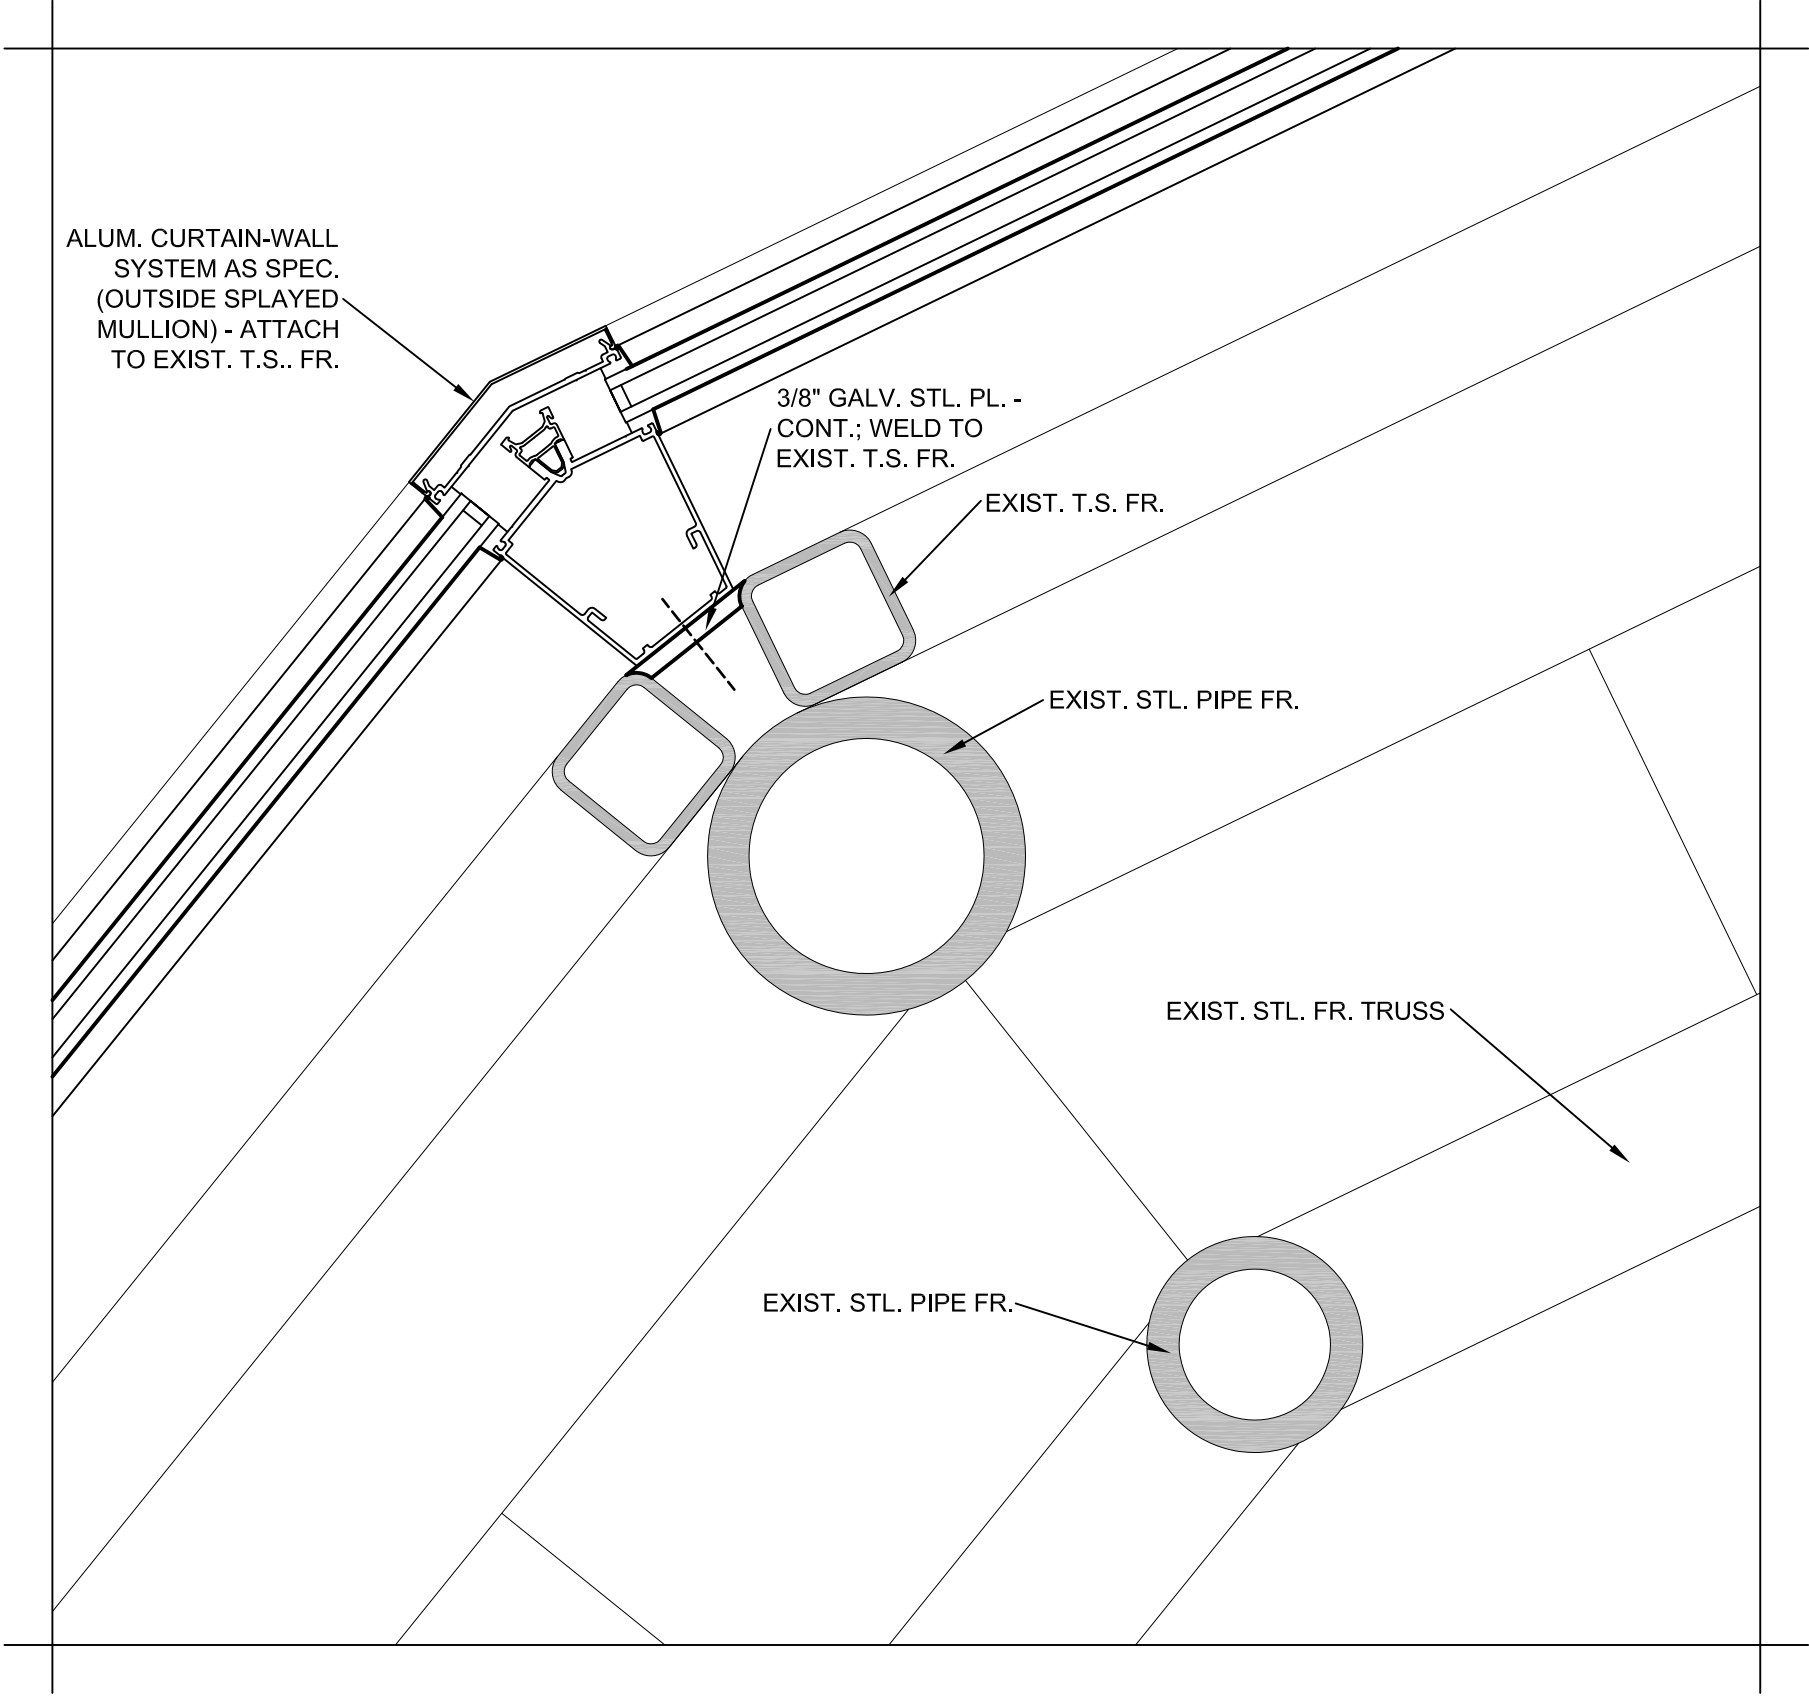


MULLION @ SLOPE CHANGE OF
TYPE "F" SLOPED GLAZED OPENING

SCALE: 3"=1'-0"

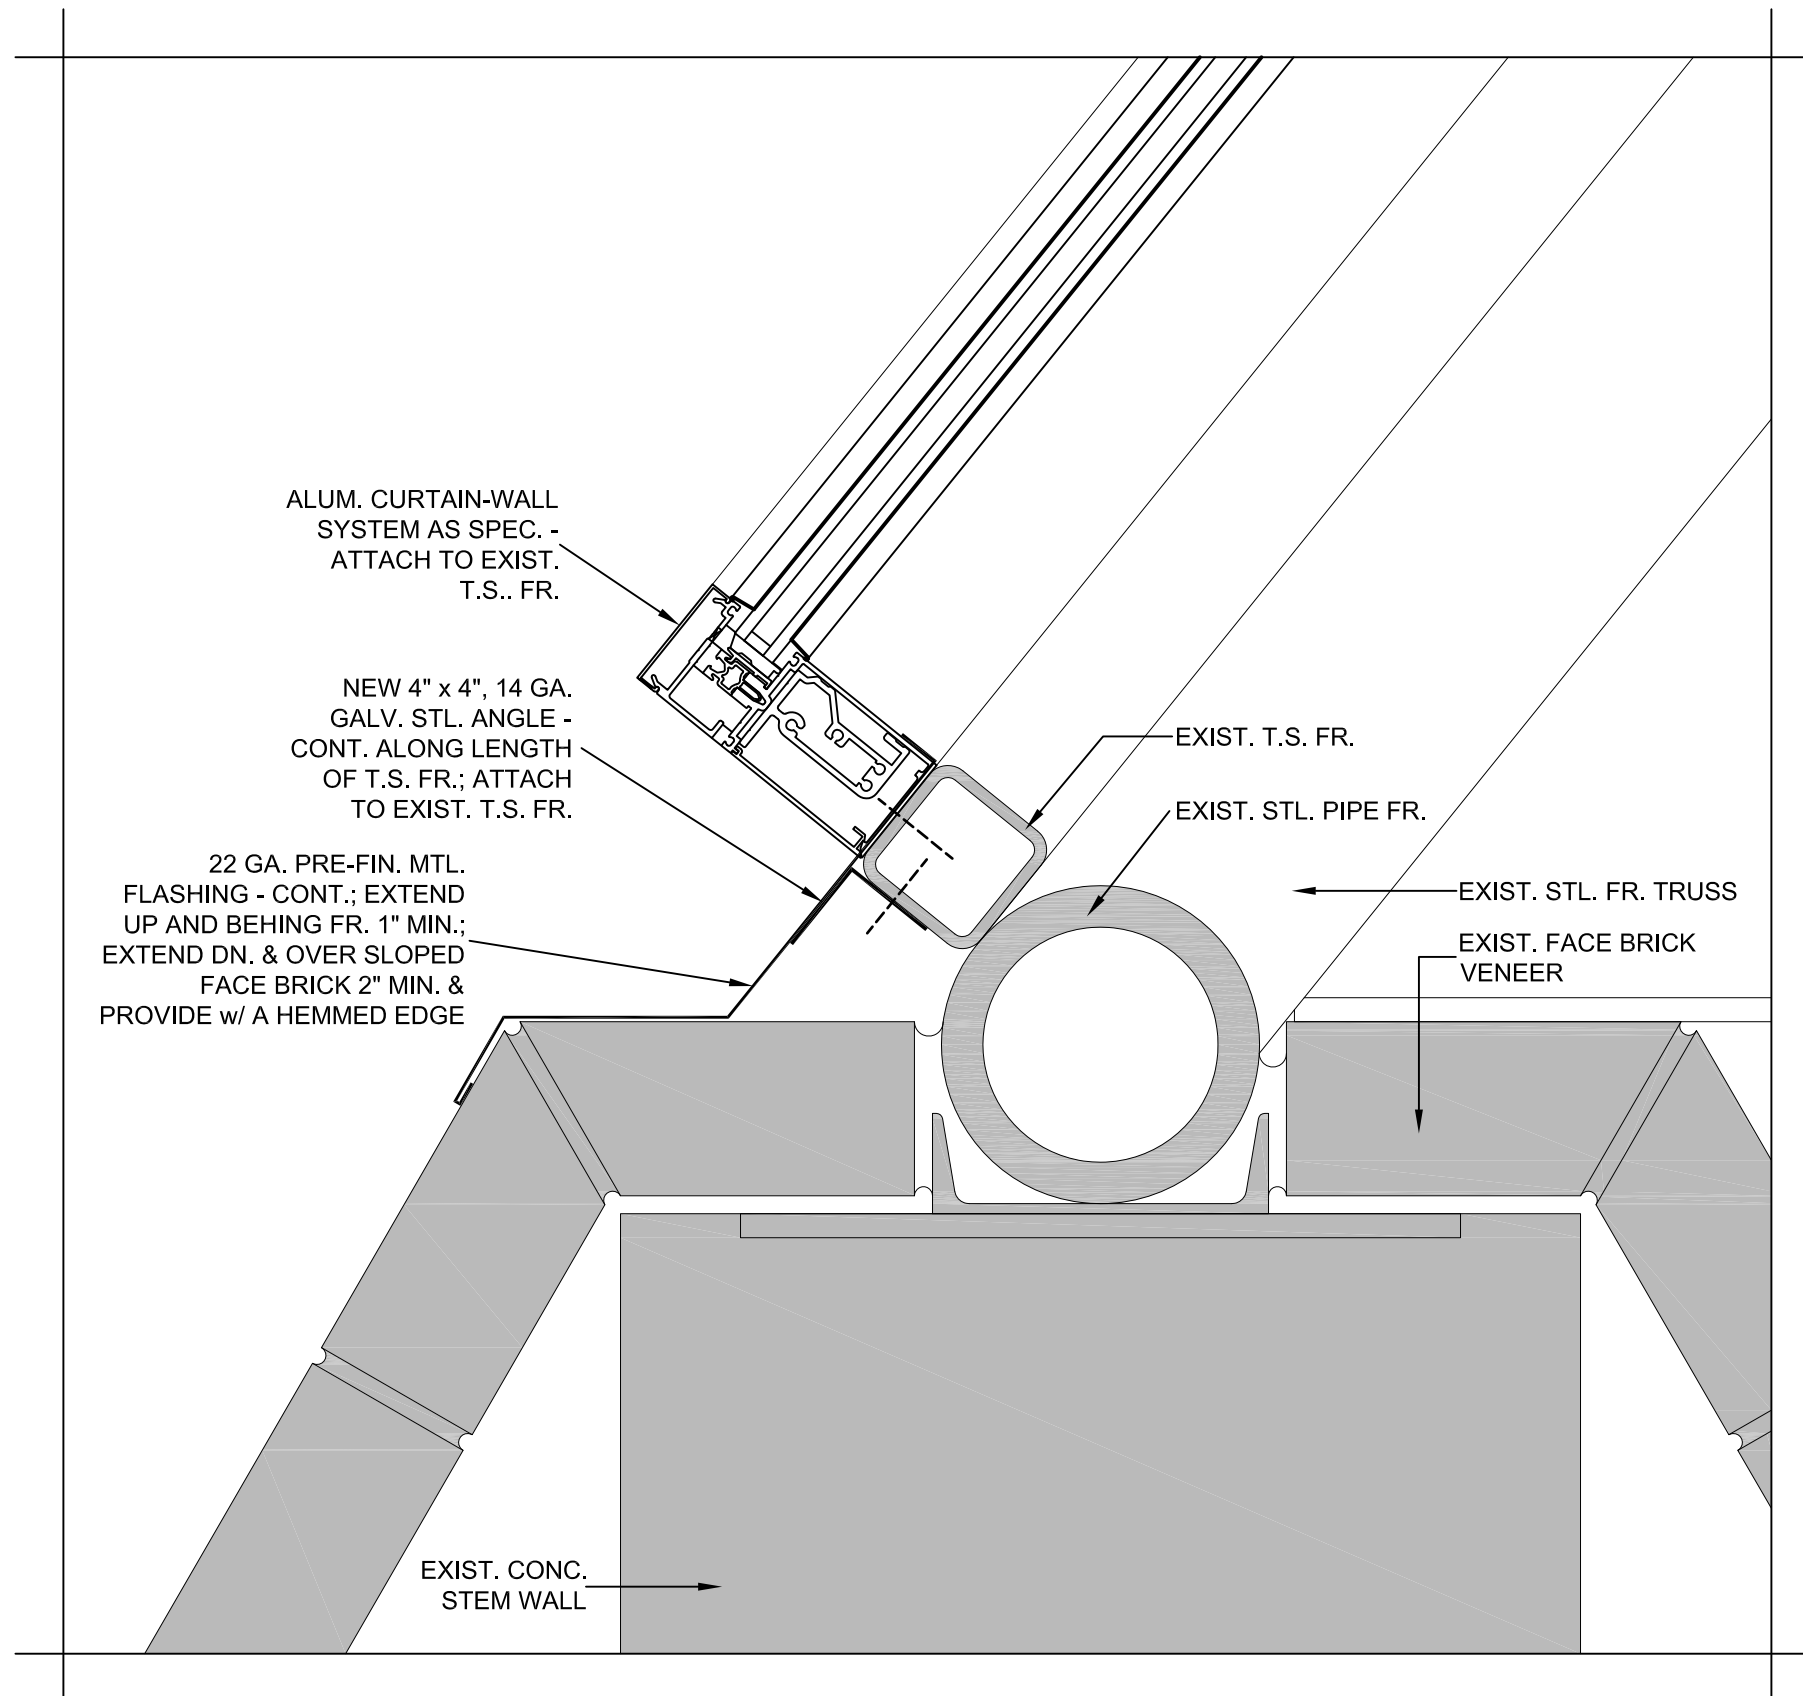

BOTTOM OF TYPE "F" SLOPED GLAZED OPENING

SCALE: 3"=1'-0"

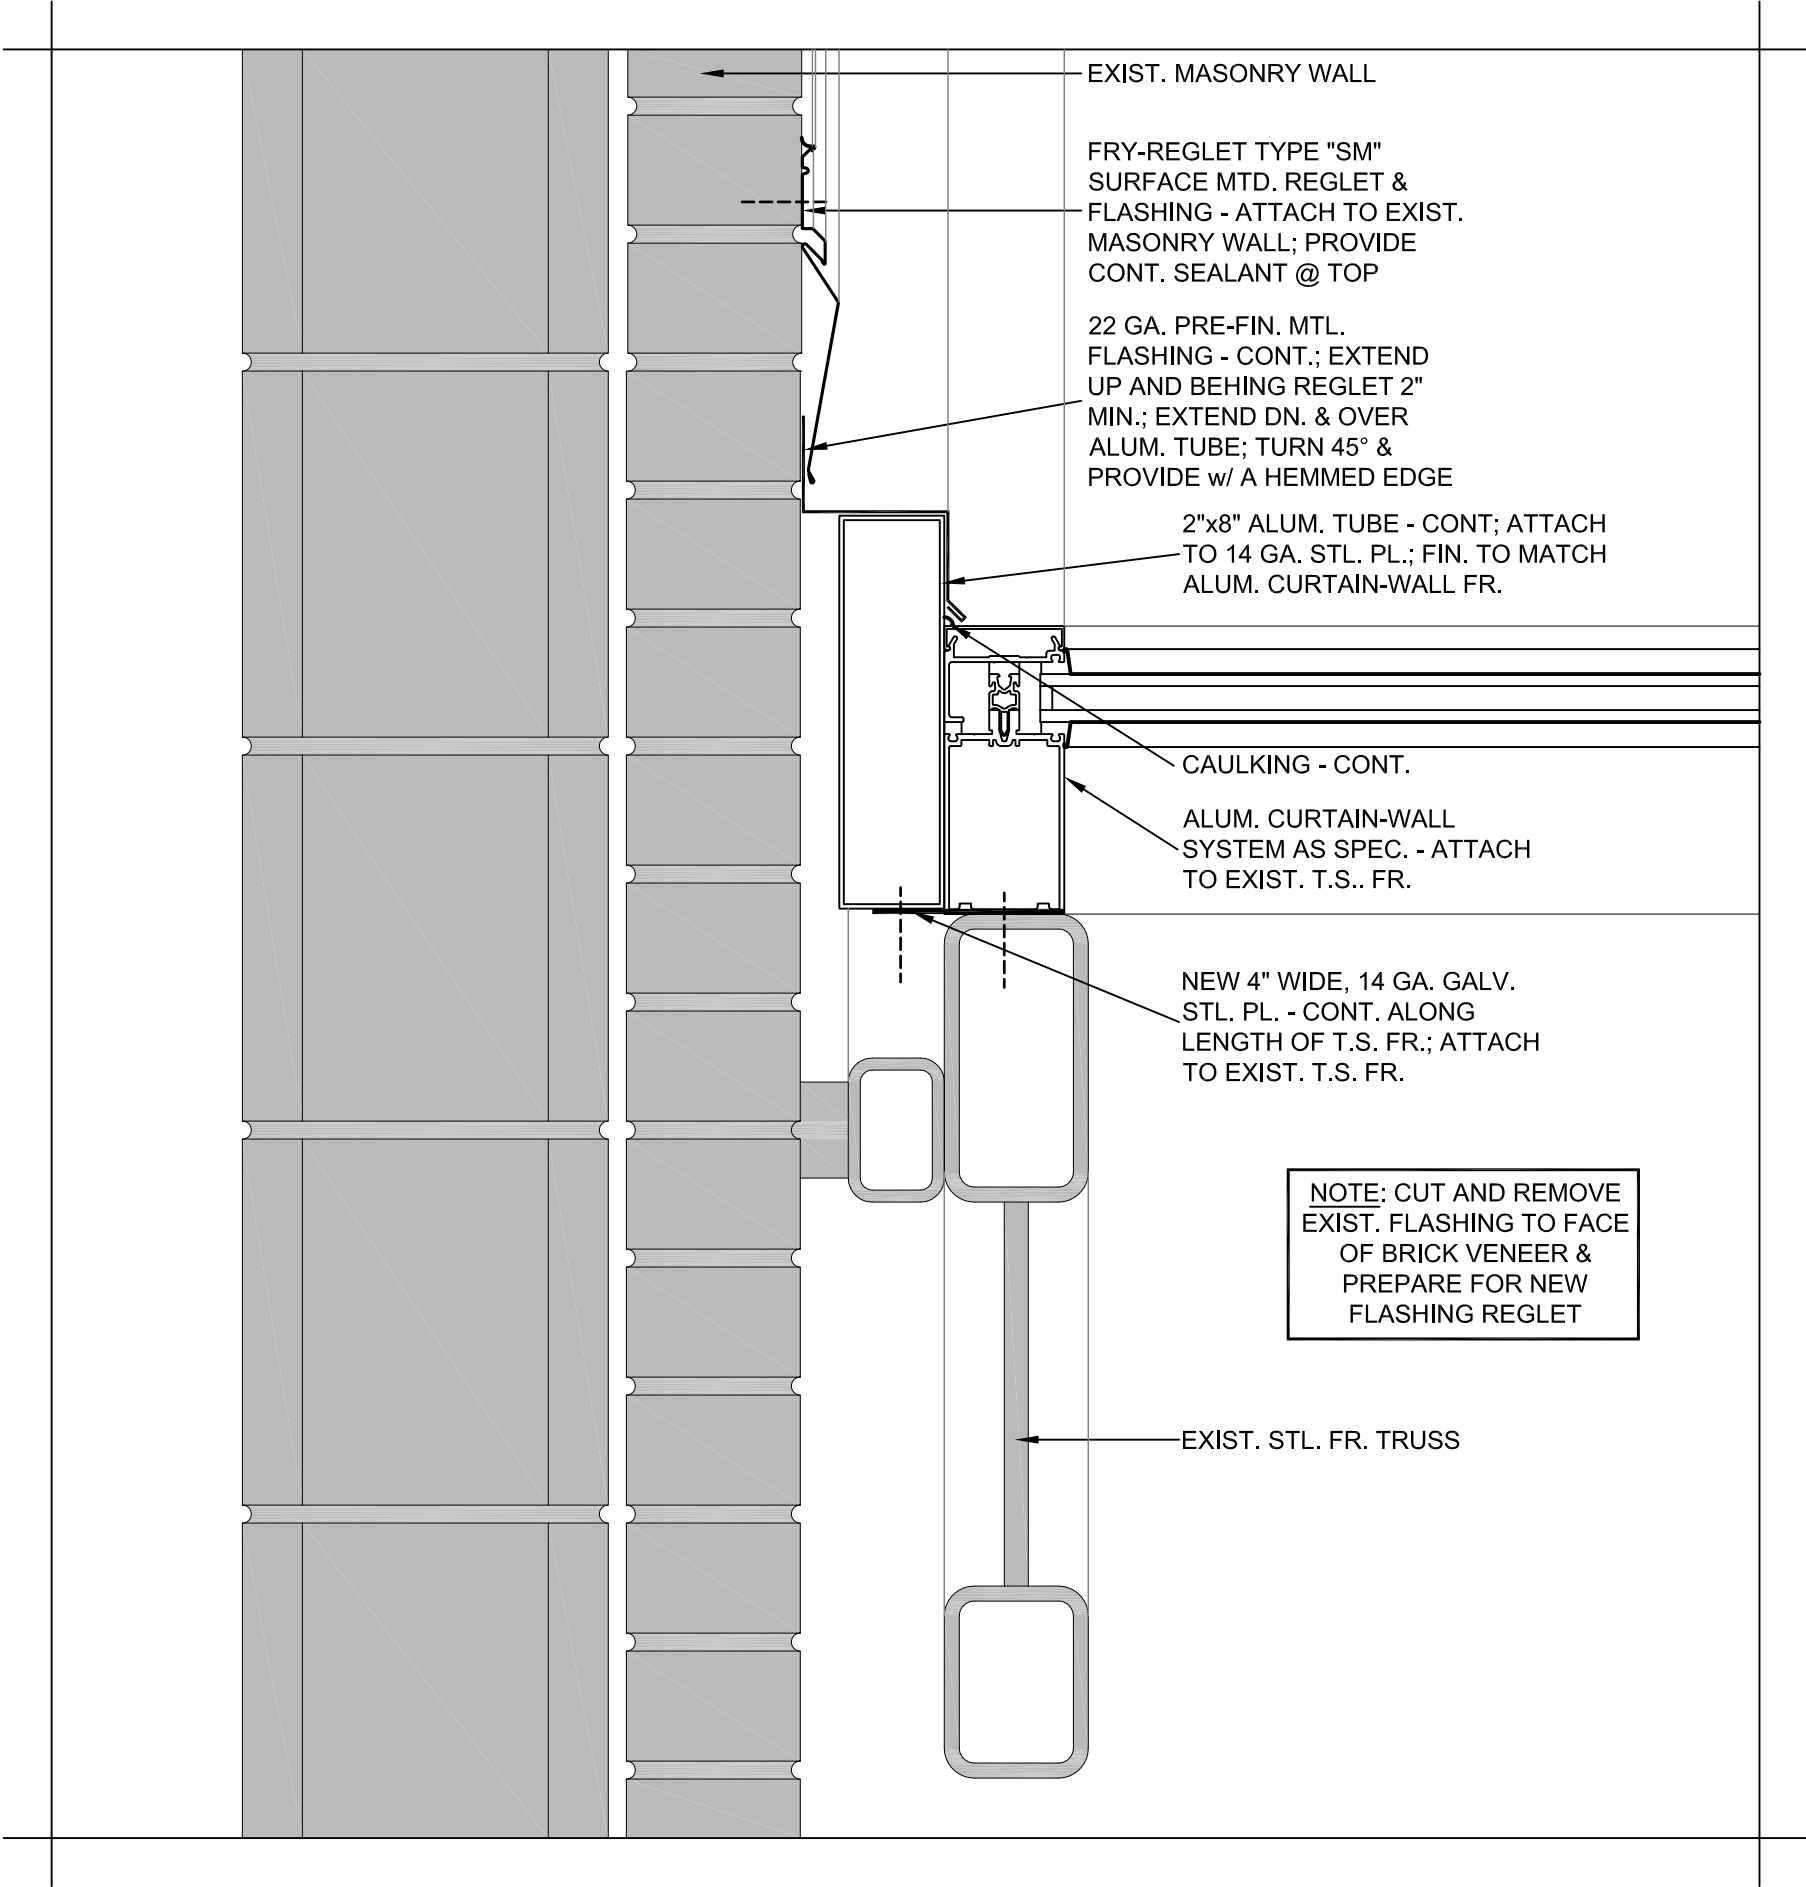

SIDE OF TYPE "F" SLOPED GLAZED OPENING

SCALE: 3"=1'-0"

REVISION NARRATIVE

Project: D17-1263.00 MSU ADA Deferred Maintenance
Subject: Addendum #2 - 08/10/2017
To: Harper Perkins Architects, Inc.: Sam K. Kenshalo, Project Manager

Summarized below are the revisions made to the Contract Documents.

Electrical

1. Sheet B-ED101 – Revised Drawing as follows:
 - a. Added Computer Lab room 133 lighting to be remove and stored as stated in Key Note #4.
2. Sheet B-E101 – Revised Drawing as follows:
 - a. Added Computer Lab room 133 lighting to be re-installed as stated in Key Note #6.
 - b. Removed heat trace from the drawing per owner instruction.
 - c. Key Note #11 changed to “Not Used”, as it pertains to heat trace that was removed.
3. Sheet E001 – Revised Drawing as follows:
 - a. Revised all General Notes.
4. Sheet FF-ED102 – Revised Drawing as follows:
 - a. Added Key Note #3 regarding outlets on renovated walls.
 - b. Enclosed the area in the drawing that is covered by Key Note #3.
5. Sheet FF-E102 – Revised Drawing as follows:
 - a. Added Key Notes #14 and #15 regarding outlets on renovated walls.
 - b. Enclosed the area in the drawing that is covered by Key Notes #14 and #15.
6. Sheet H-E101 – Revised Drawing as follows:
 - a. Added Key Note #6 regarding lighting fixture removal and re-installation on areas affected by fire piping layout.
 - b. Add Note Symbol #6 on areas in the drawing affected by fire protection piping installation.

Mechanical

1. Sheet B-MD101– Revised Drawing as follows:
 - a. Rearrange sheet details to include HVAC demolition work in Area C1. It includes demolition of the supply and return ductwork serving the corridor as preparation for the inclusion of fire dampers.
2. Sheet B-M101– Revised Drawing as follows:
 - a. Rearrange sheet details to include HVAC work in Area C1. It includes new Key Notes #6 and #7 to call for the installation of fire dampers on the supply and return ductwork in the corridor.

Plumbing

1. Sheet P003 – Revised Drawing as follows:
 - a. Modified Plumbing Fixture Schedule to include correct manufacturer and model for the flushometers used by the water closets and urinals. Modified the manufacturer and model for the lavatories to comply with owner preferences.


Fire Protection

1. Sheet FP001 – Revised Drawing as follows:
 - a. Added Key note #27, to direct the contractor to coordinate with the General Contractor the removal of the reflected ceiling along with any electrical, HVAC or any other appurtenance associated with it. It also states to save those materials for reinstallation.
2. Sheet B-FP101 – Revised Drawing as follows:
 - a. Modified Key Notes #1 and #2 to reflect new main size of 6" in lieu of 4". Also, Key Note #1 directs the contractor to insulate the fire piping inside the tunnel and get rid of the heat tracing. It also directs the contractor to coordinate the exact location of tie-ins to water main with MSU Staff.
 - b. Modified main size in plans from 4" to 6".
 - c. Remove post indicator from detail 2/B-FP101.
3. Sheet H-FP101 – Revised Drawing as follows:
 - a. Modified Key Notes #1 and #2 to reflect new main size of 6" in lieu of 4". Also, Key Note #1 directs the contractor to coordinate exact location of tie-ins to water main with MSU Staff.
 - b. Modified main size in plans from 4" to 6".
 - c. Added Key Note # 7 to indicate that the area underneath the stage is to be provided with a fire sprinkler system under Alternate #2.

Please let us know if you have any questions or concerns.


Sincerely,
Campos Engineering, Inc.


Fred Crabtree, PE
Project Manager/Mechanical Engineer

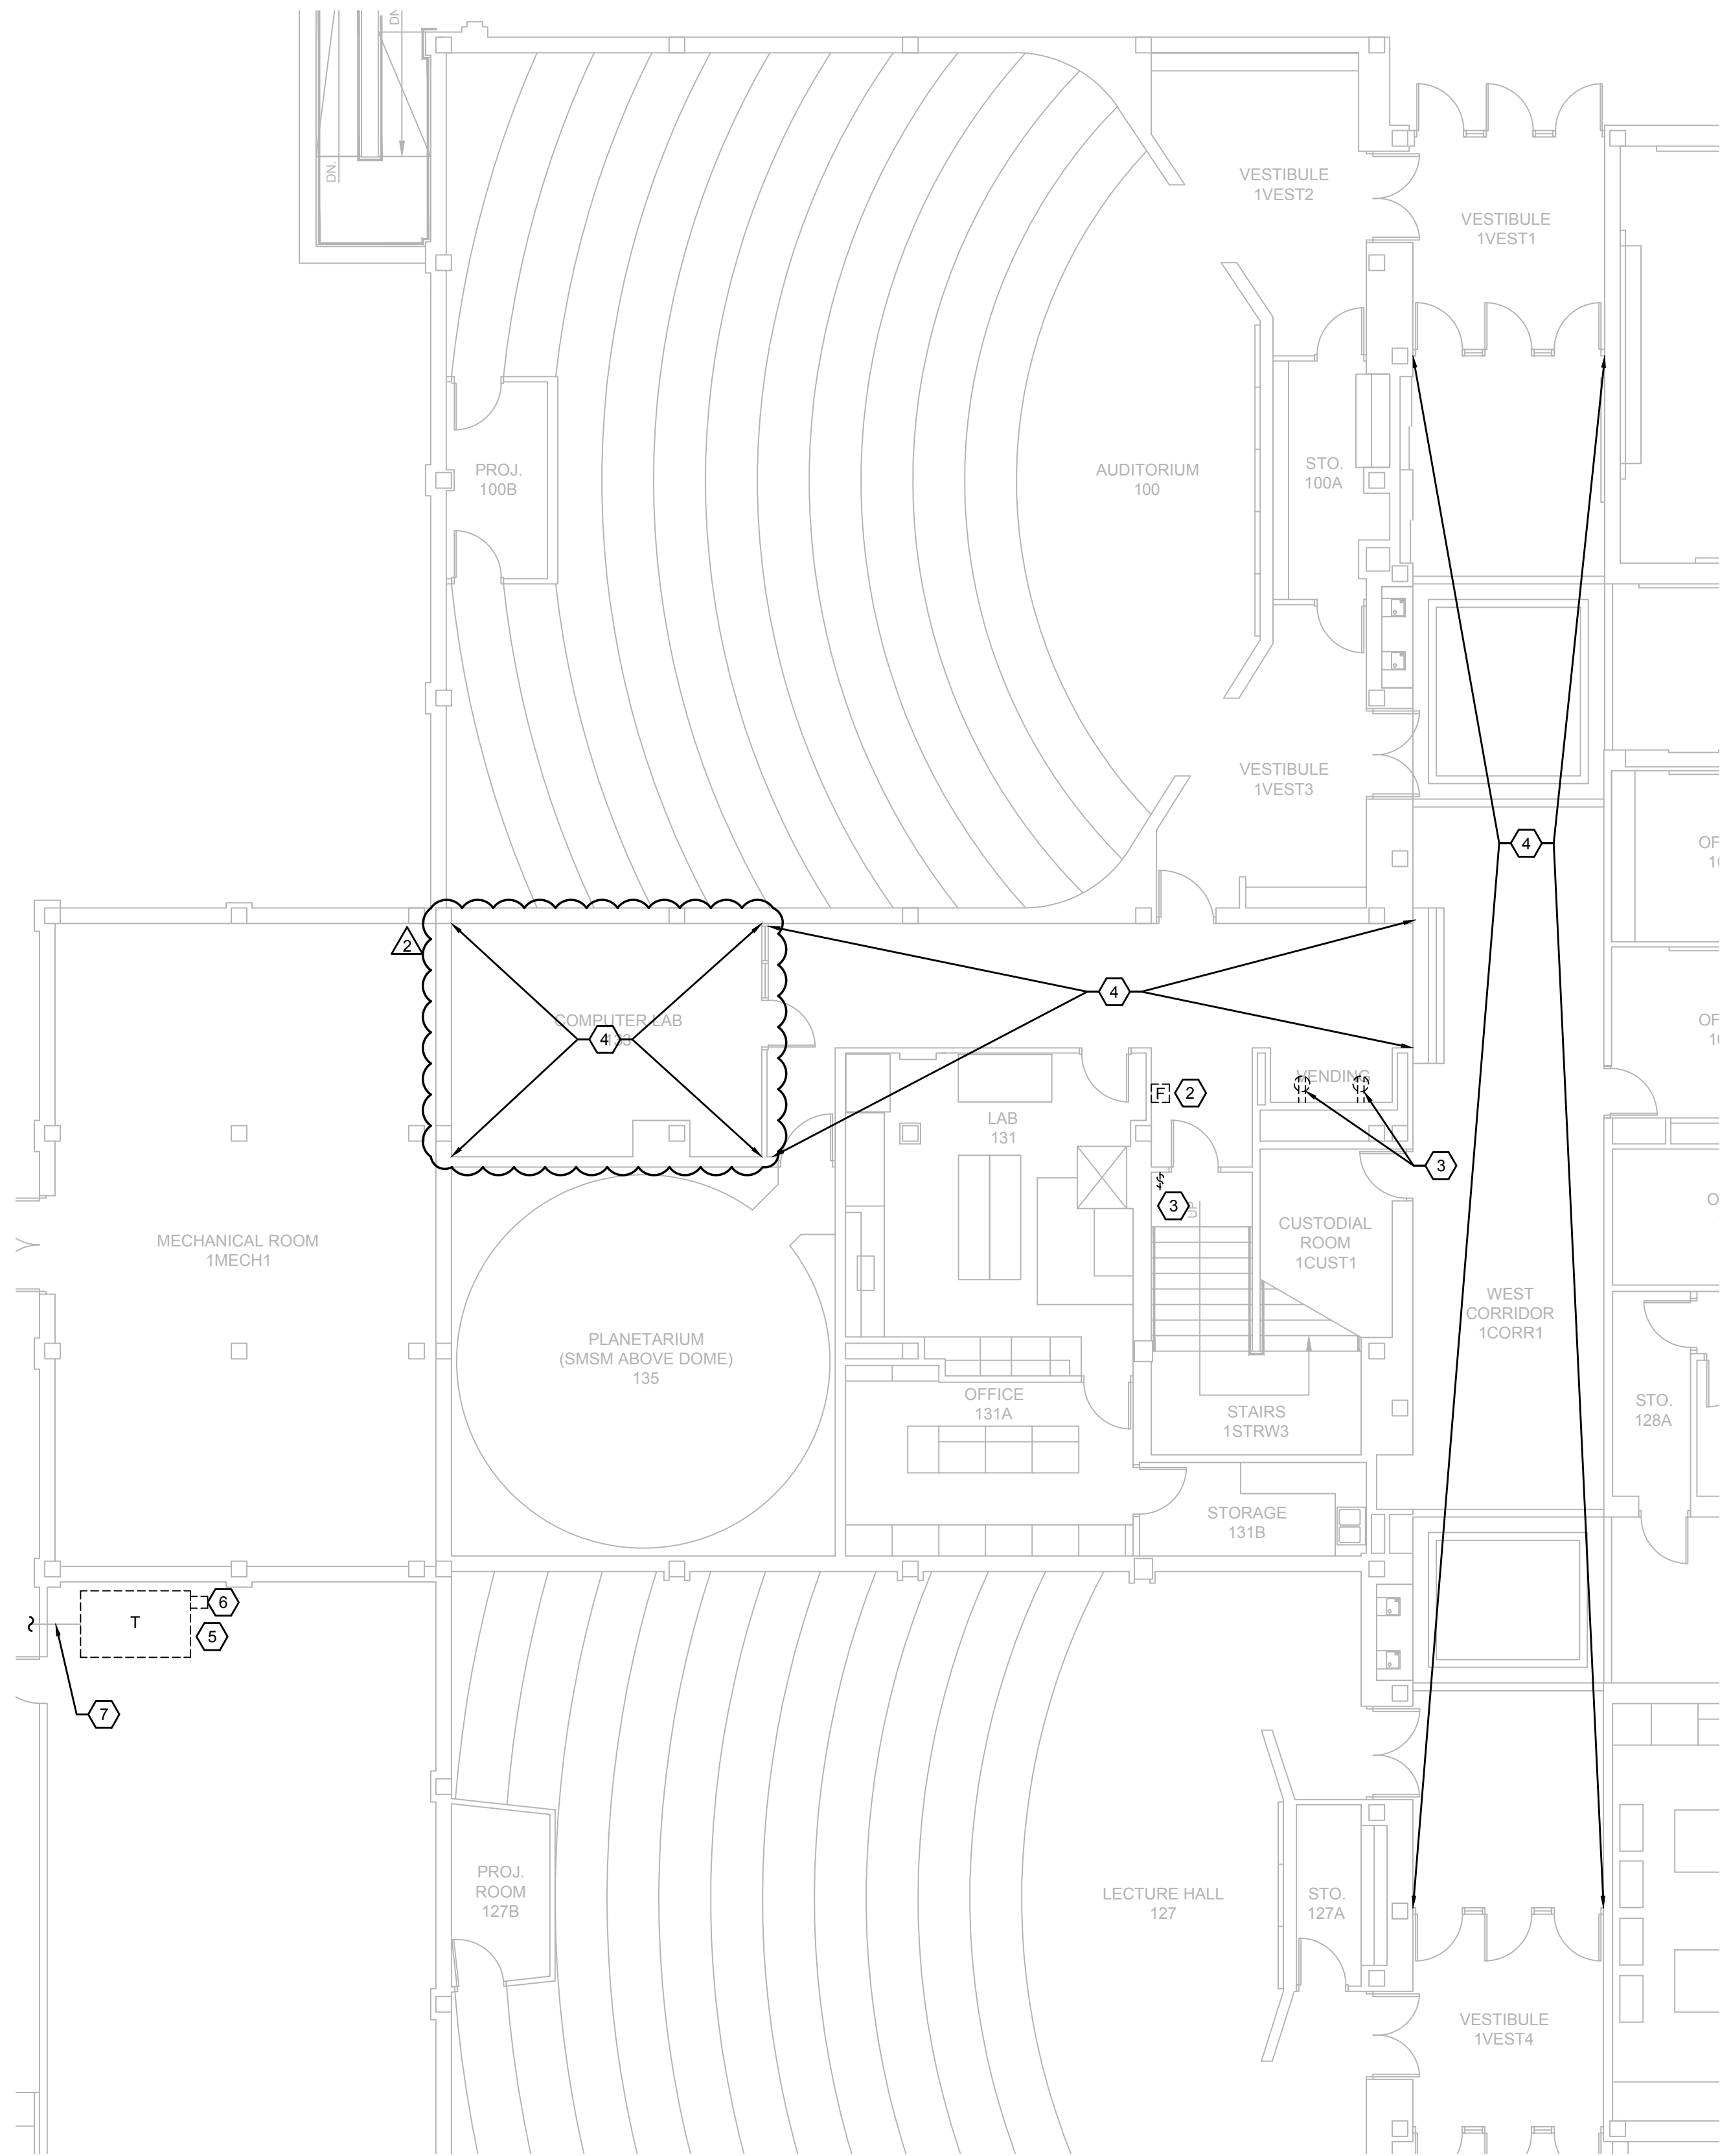


 **3**
B-ED101 SCALE: 1/8" = 1'-0"

**BOLIN SCIENCE HALL - FIRST FLOOR - AREA 1C
ELECTRICAL DEMOLITION PLAN**

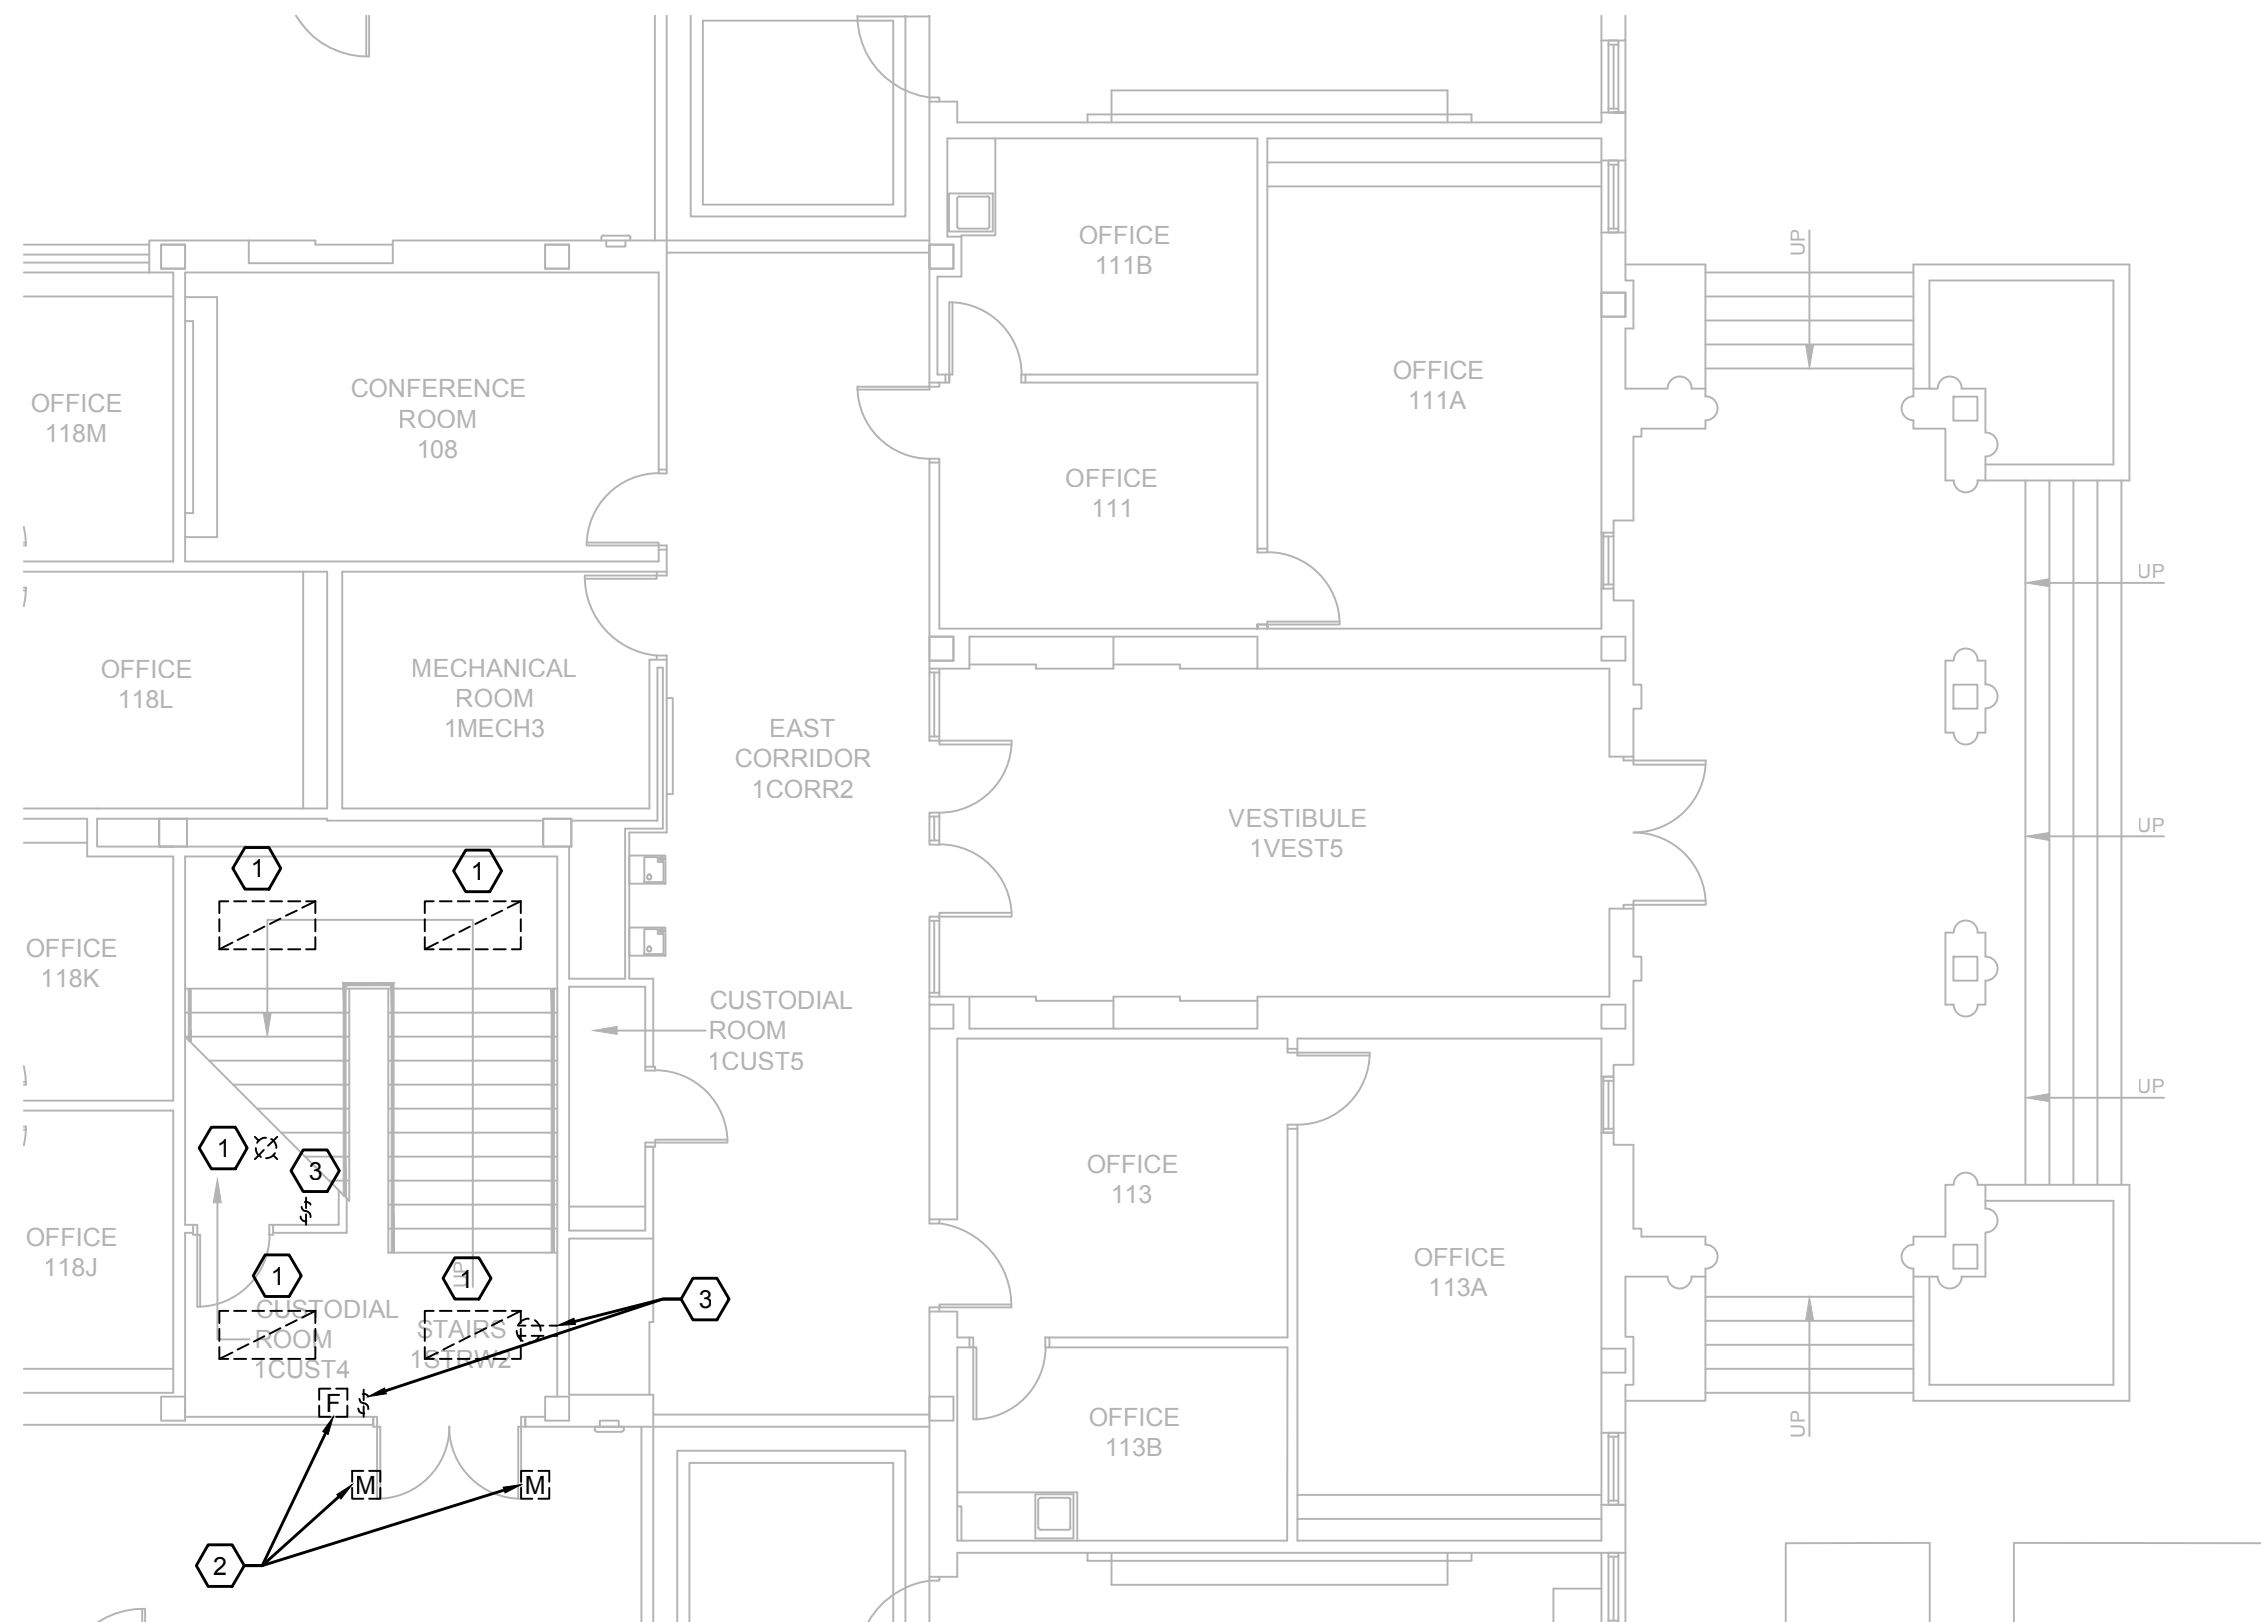

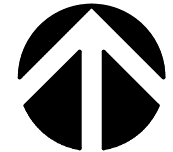 **1**
B-ED101 SCALE: 1/8" = 1'-0"

**BOLIN SCIENCE HALL - FIRST FLOOR - AREA 1B
ELECTRICAL DEMOLITION PLAN**

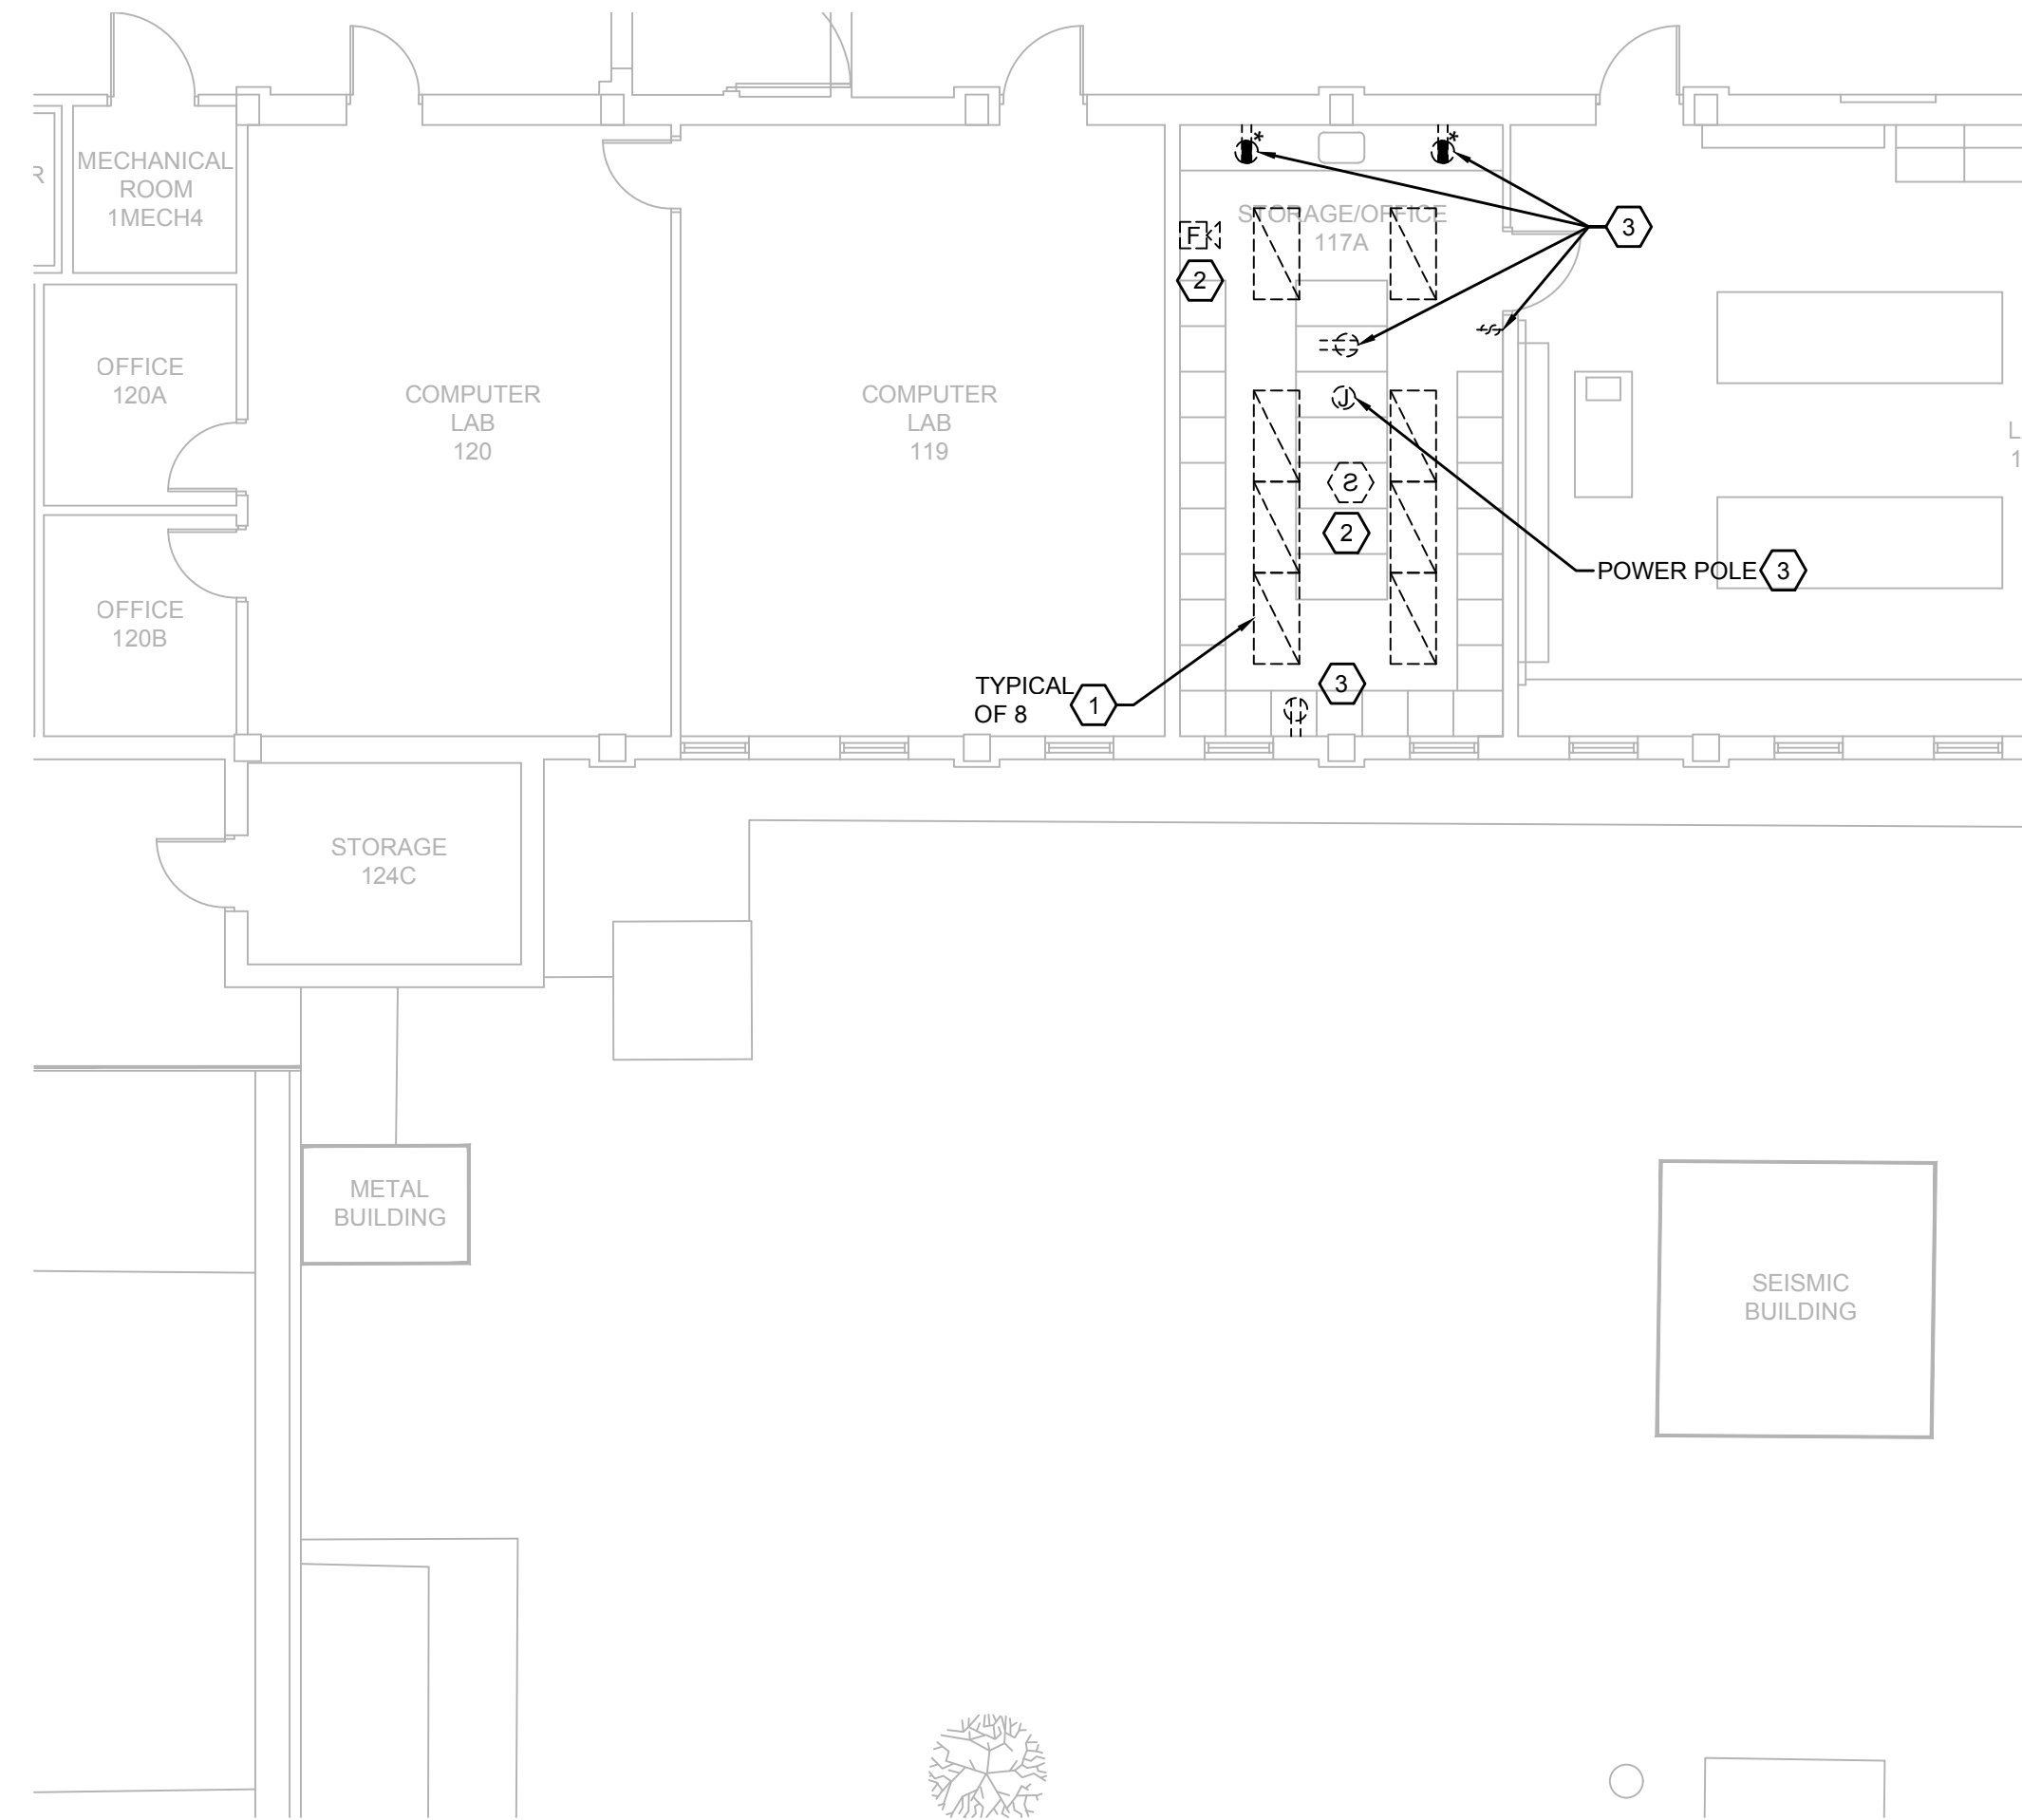

 **2**
B-ED101 SCALE: 1/8" = 1'-0"

**BOLIN SCIENCE HALL - FIRST FLOOR - AREA 1A
ELECTRICAL DEMOLITION PLAN**

GENERAL NOTES

1. REFER TO ARCHITECTURAL OVERALL FLOOR PLANS FOR LOCATIONS SCOPE OF WORK AREAS WITHIN THE BUILDING.

KEY NOTES

1. REMOVE EXISTING LIGHTS. RETAIN CIRCUITING FOR RE-USE.
2. REMOVE EXISTING FIRE ALARM DEVICE. RETAIN FOR RE-USE IN NEW LOCATION.
3. REMOVE EXISTING WIRING DEVICE. RETAIN CIRCUITING FOR RE-USE.
4. REMOVE ALL LIGHTS IN THIS AREA AND STORE THEM DURING CONSTRUCTION FOR RE-INSTALLATION AFTER THE SPRINKLER PIPING HAS BEEN INSTALLED.
5. REMOVE EXISTING 2000KVA TRANSFORMER. APPLY ALL NECESSARY PRECAUTION TO PRESERVE THE PRIMARY DUCTBANK SERVING TRANSFORMER IN GOOD AND SAFE CONDITION. TIMING OF REMOVAL AND THE INSTALLATION OF THE NEW TRANSFORMER SHALL BE COORDINATED WITH OWNER TO MINIMIZE POWER DISRUPTION TO THE BUILDING. REF. DRAWING B-101. DISPOSE OF THE EXISTING TRANSFORMER IN COMPLIANCE WITH LOCAL, STATE, AND FEDERAL REGULATIONS. OWNER WILL PROVIDE TEST REPORT SHOWING TRANSFORMER DOES NOT CONTAIN PCB PRIOR TO REMOVAL.
6. REMOVE EXISTING TXU METER AND METERING CURRENT TRANSFORMERS (CTS) AND RETURN TO OWNER. PRESERVE IN GOOD CONDITION. PRESERVE EXISTING SCHNEIDER ELECTRIC PM750 METER AND WIRING FOR REUSE AND INSTALLATION IN THE NEW TRANSFORMER. REFERENCE BE-102 FOR ADDITIONAL REQUIREMENTS.
7. APPROXIMATE LOCATION OF EXISTING PRIMARY CABLE IN DUCTBANK. FIELD VERIFY EXACT LOCATION.



DATE SIGNED:



TASADA - FIRE MARSHAL DEFERRED MAINTENANCE PROJECTS FOR
MIDWESTERN STATE UNIVERSITY
3410 TAFT BOULEVARD
WICHITA FALLS, TEXAS



DRAWN BY:

DATE: 15 MAY 2017


REVISIONS

NO.	DESCRIPTION	DATE
1	ADDENDUM 1	08/02/17
2	ADDENDUM 2	08/10/17

16782.00


© 2017 HARPER PERKINS ARCHITECTS

B-ED101

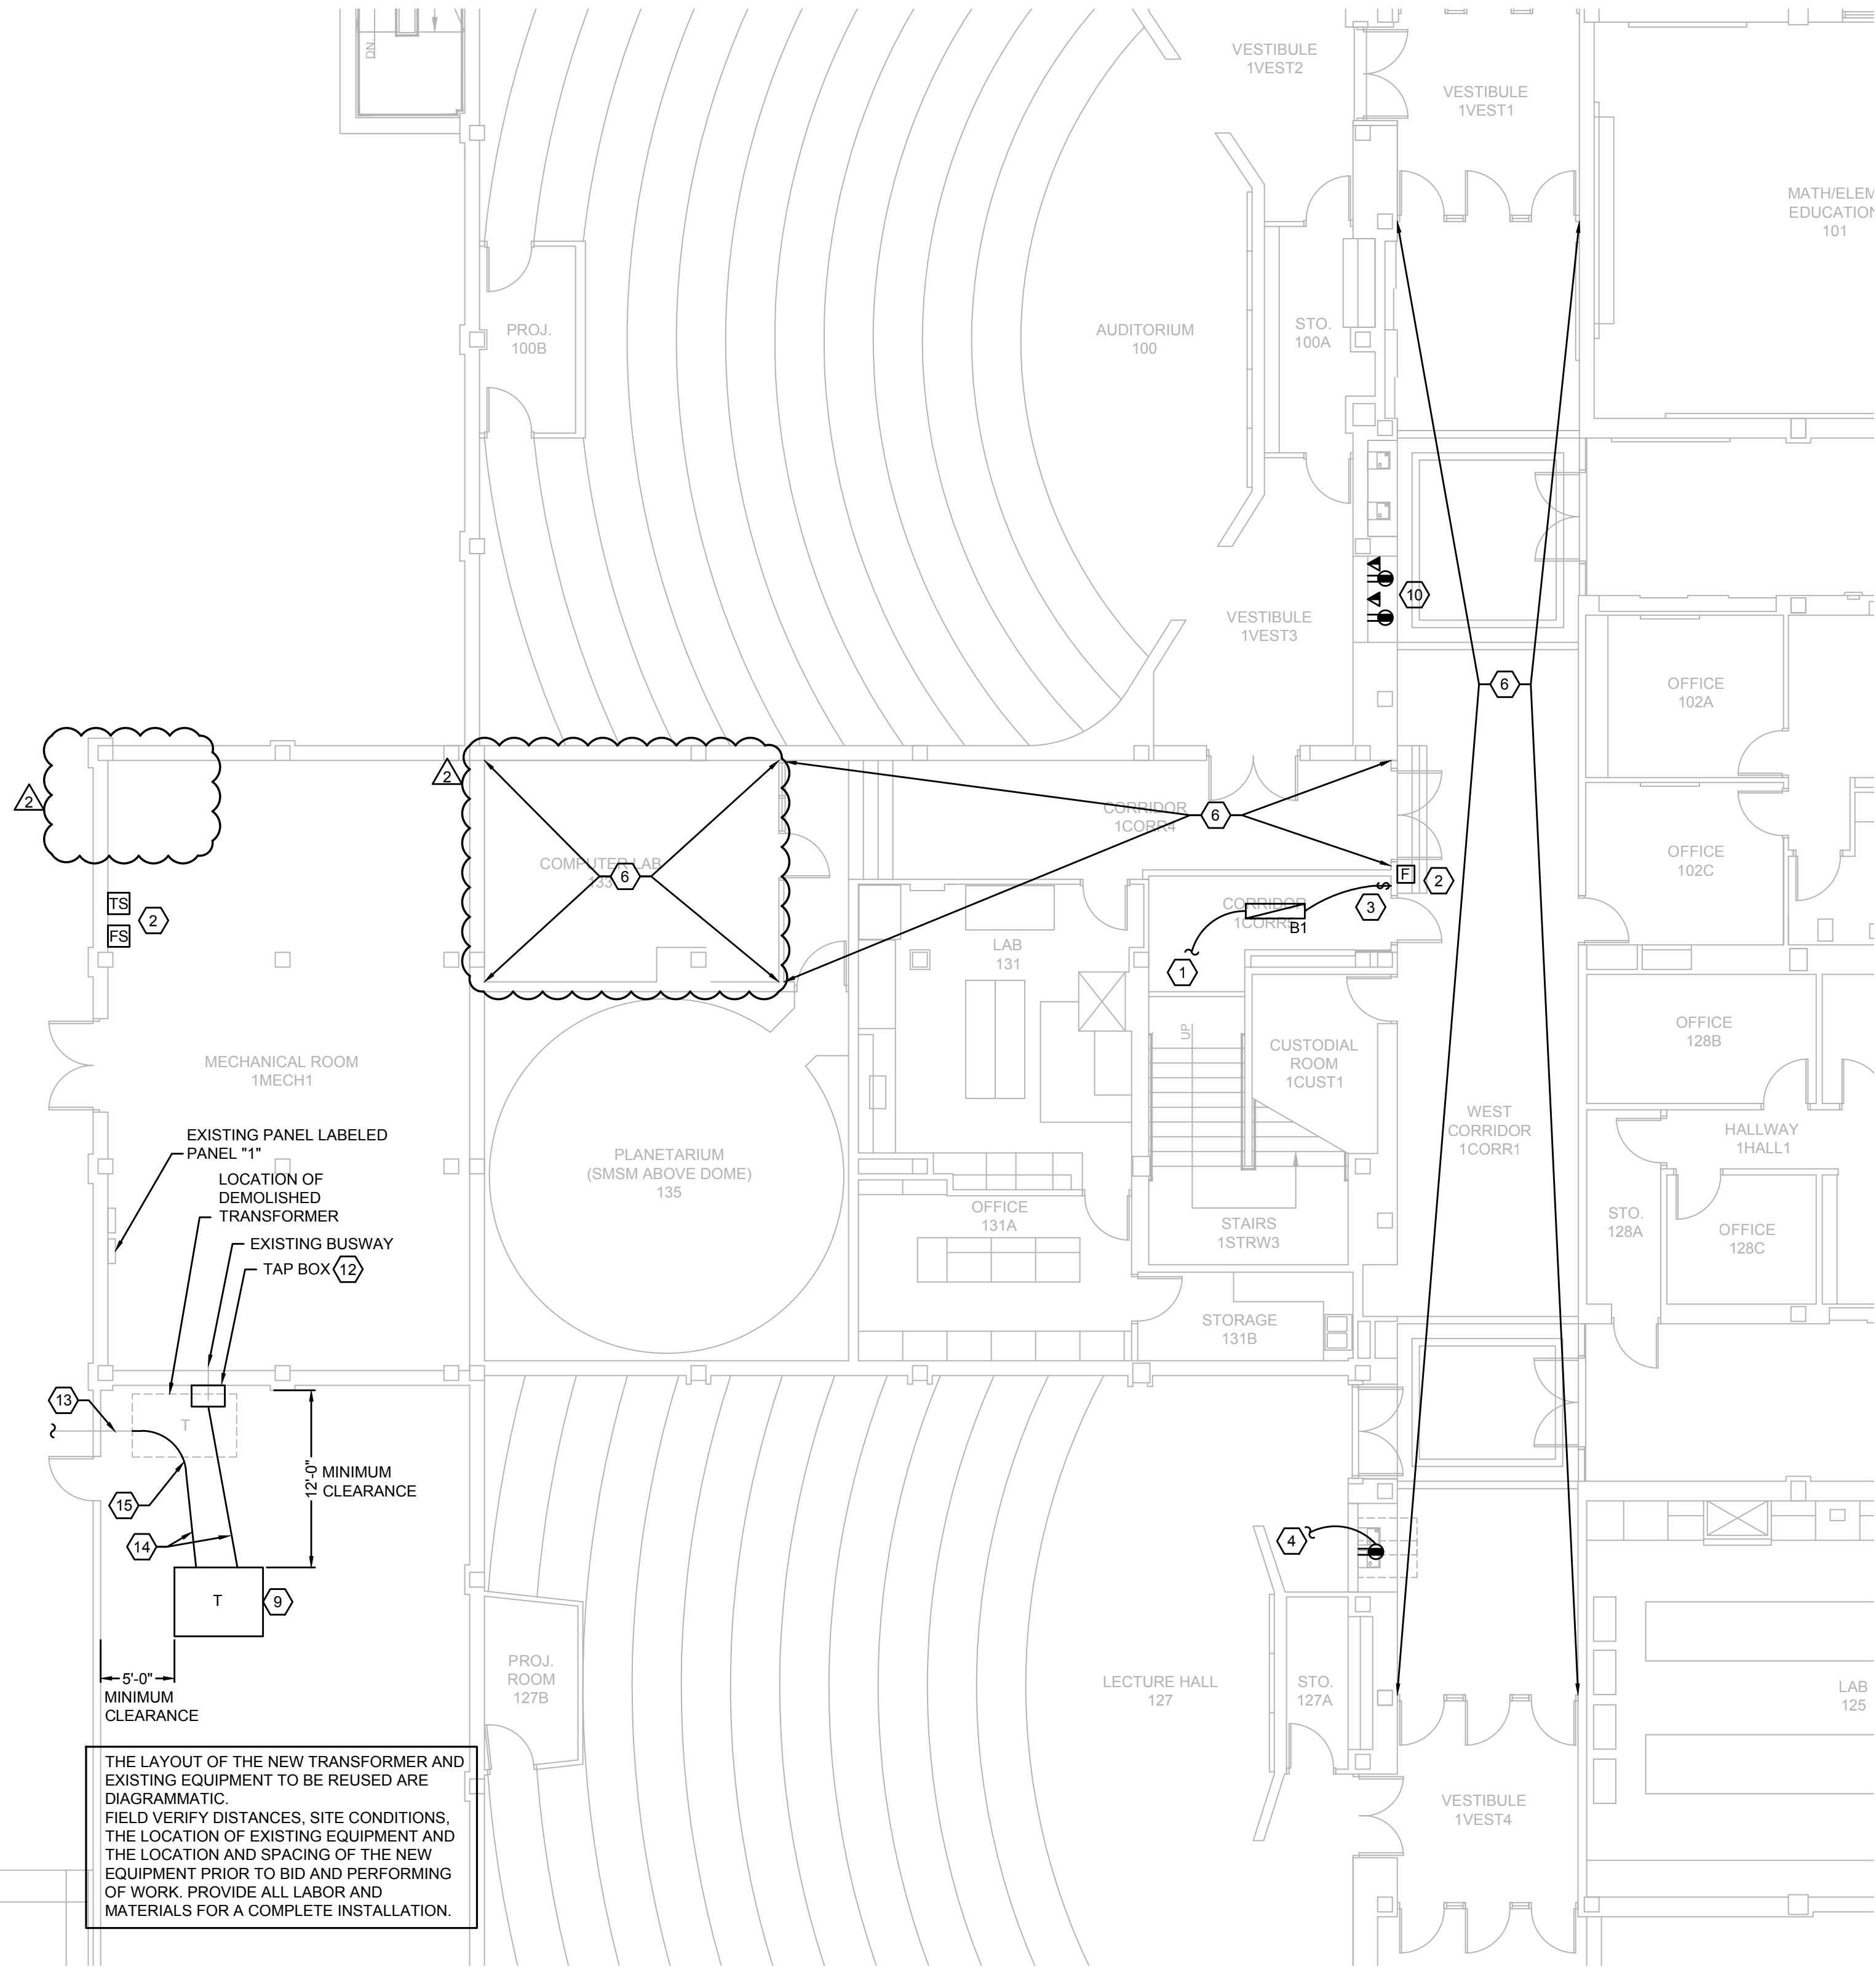


BOLIN SCIENCE HALL - FIRST FLOOR - AREA 1C
ELECTRICAL PLAN

LIGHT FIXTURE SCHEDULE										
TYPE	DESCRIPTION	LAMP			MOUNTING	ELECTRICAL		MANUFACTURER	CATALOG NUMBER	NOTES
		TYPE	COLOR TEMP	CRI		VOLTS	VA			
A1	2X2 LENSED TROFFER	FLUORESCENT	4000K	85	RECESSED GRID	UNV	35	HEW	50G-S22-2-17-F-AF12125-UNV	
B1	1X4 SURFACE MOUNTED WRAP AROUND	FLUORESCENT	4000K	85	SURFACE	UNV	65	HEW	21-4-232-1-EB2-UNV	
B1E	SAME AS B1 EXCEPT WITH EMERGENCY BATTERY BACK-UP									
X1	STANDARD LED EXIT SIGN	LED	N/A	N/A	SURFACE	UNV	10	HEW	EXIT-R-EM-WHT-SDT	1,2
E1	INTERIOR EMERGENCY WALL PACK	LED	N/A	N/A	SURFACE	UNV	10	HEW	EMER/LED-WHT-SDT	
F1	EXTERIOR WALL MOUNTED LIGHT	LED	6350K	N/A	WALL ABOVE DOOR	UNV	2.78	HEW	PGP-HTR	
NOTES:										
1. VERIFY MOUNTING, NUMBER OF FACES AND ARROW CONFIGURATION WITH PLANS PRIOR TO ORDERING FIXTURES.										
2. VERIFY MOUNTING HEIGHT AND ORIENTATION WITH ARCHITECTURAL DRAWINGS PRIOR TO ROUGH-IN.										

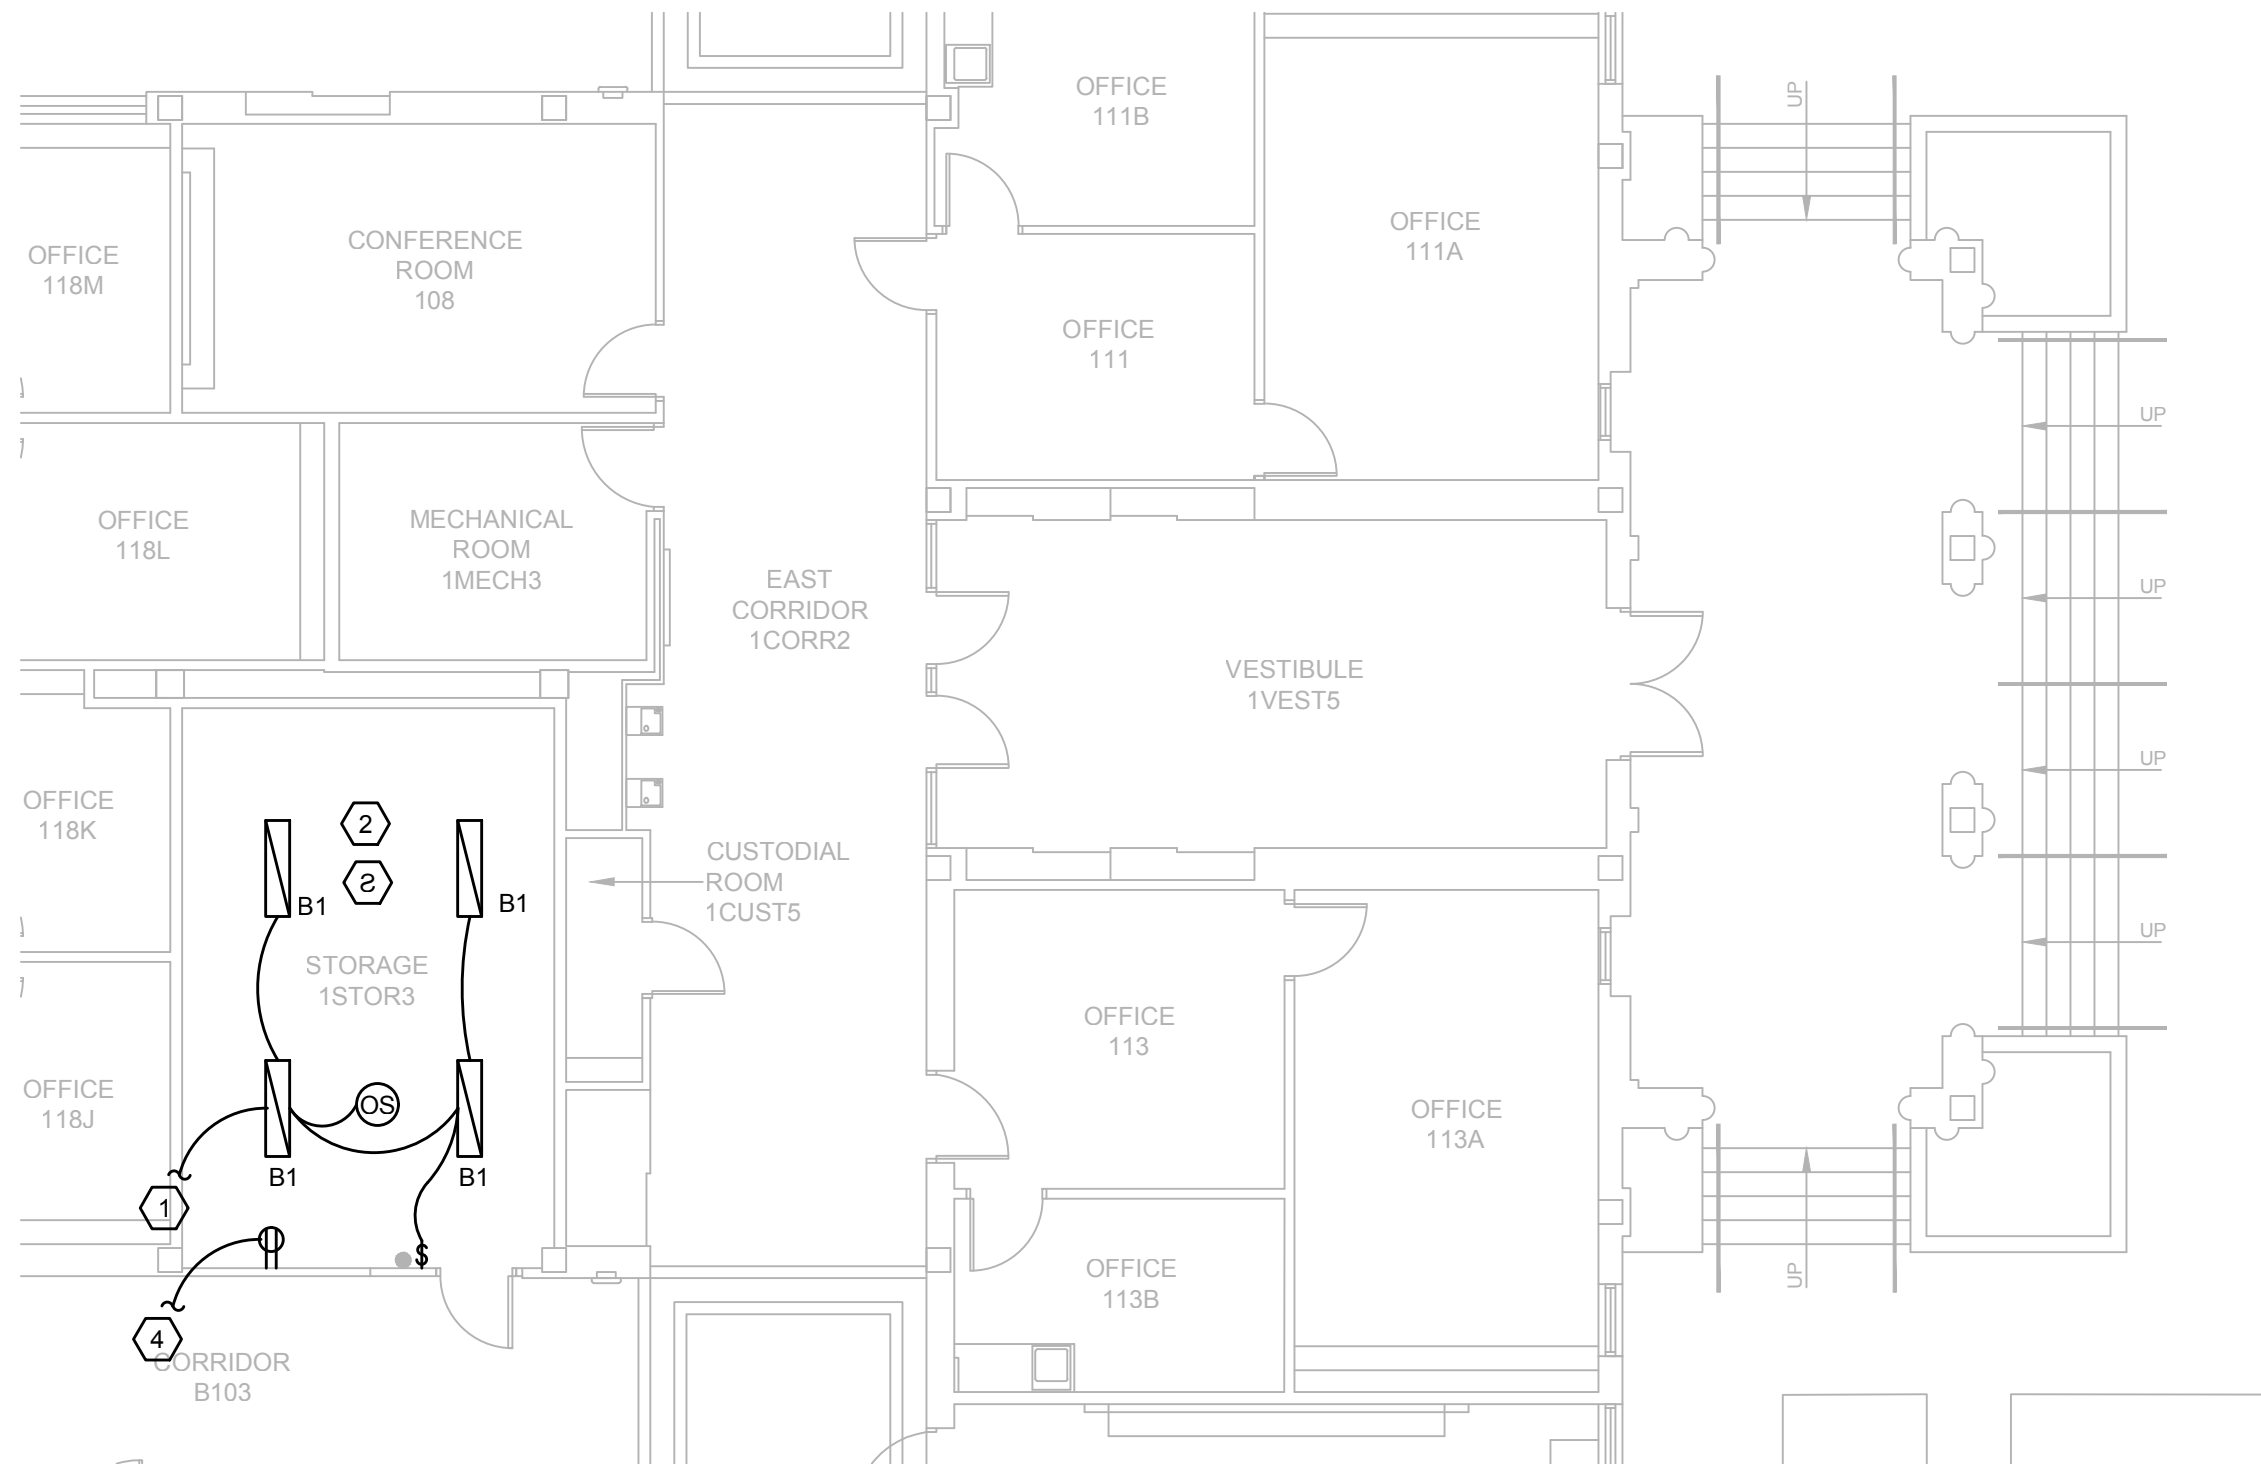

BOLIN SCIENCE HALL - FIRST FLOOR - AREA 1B
ELECTRICAL PLAN

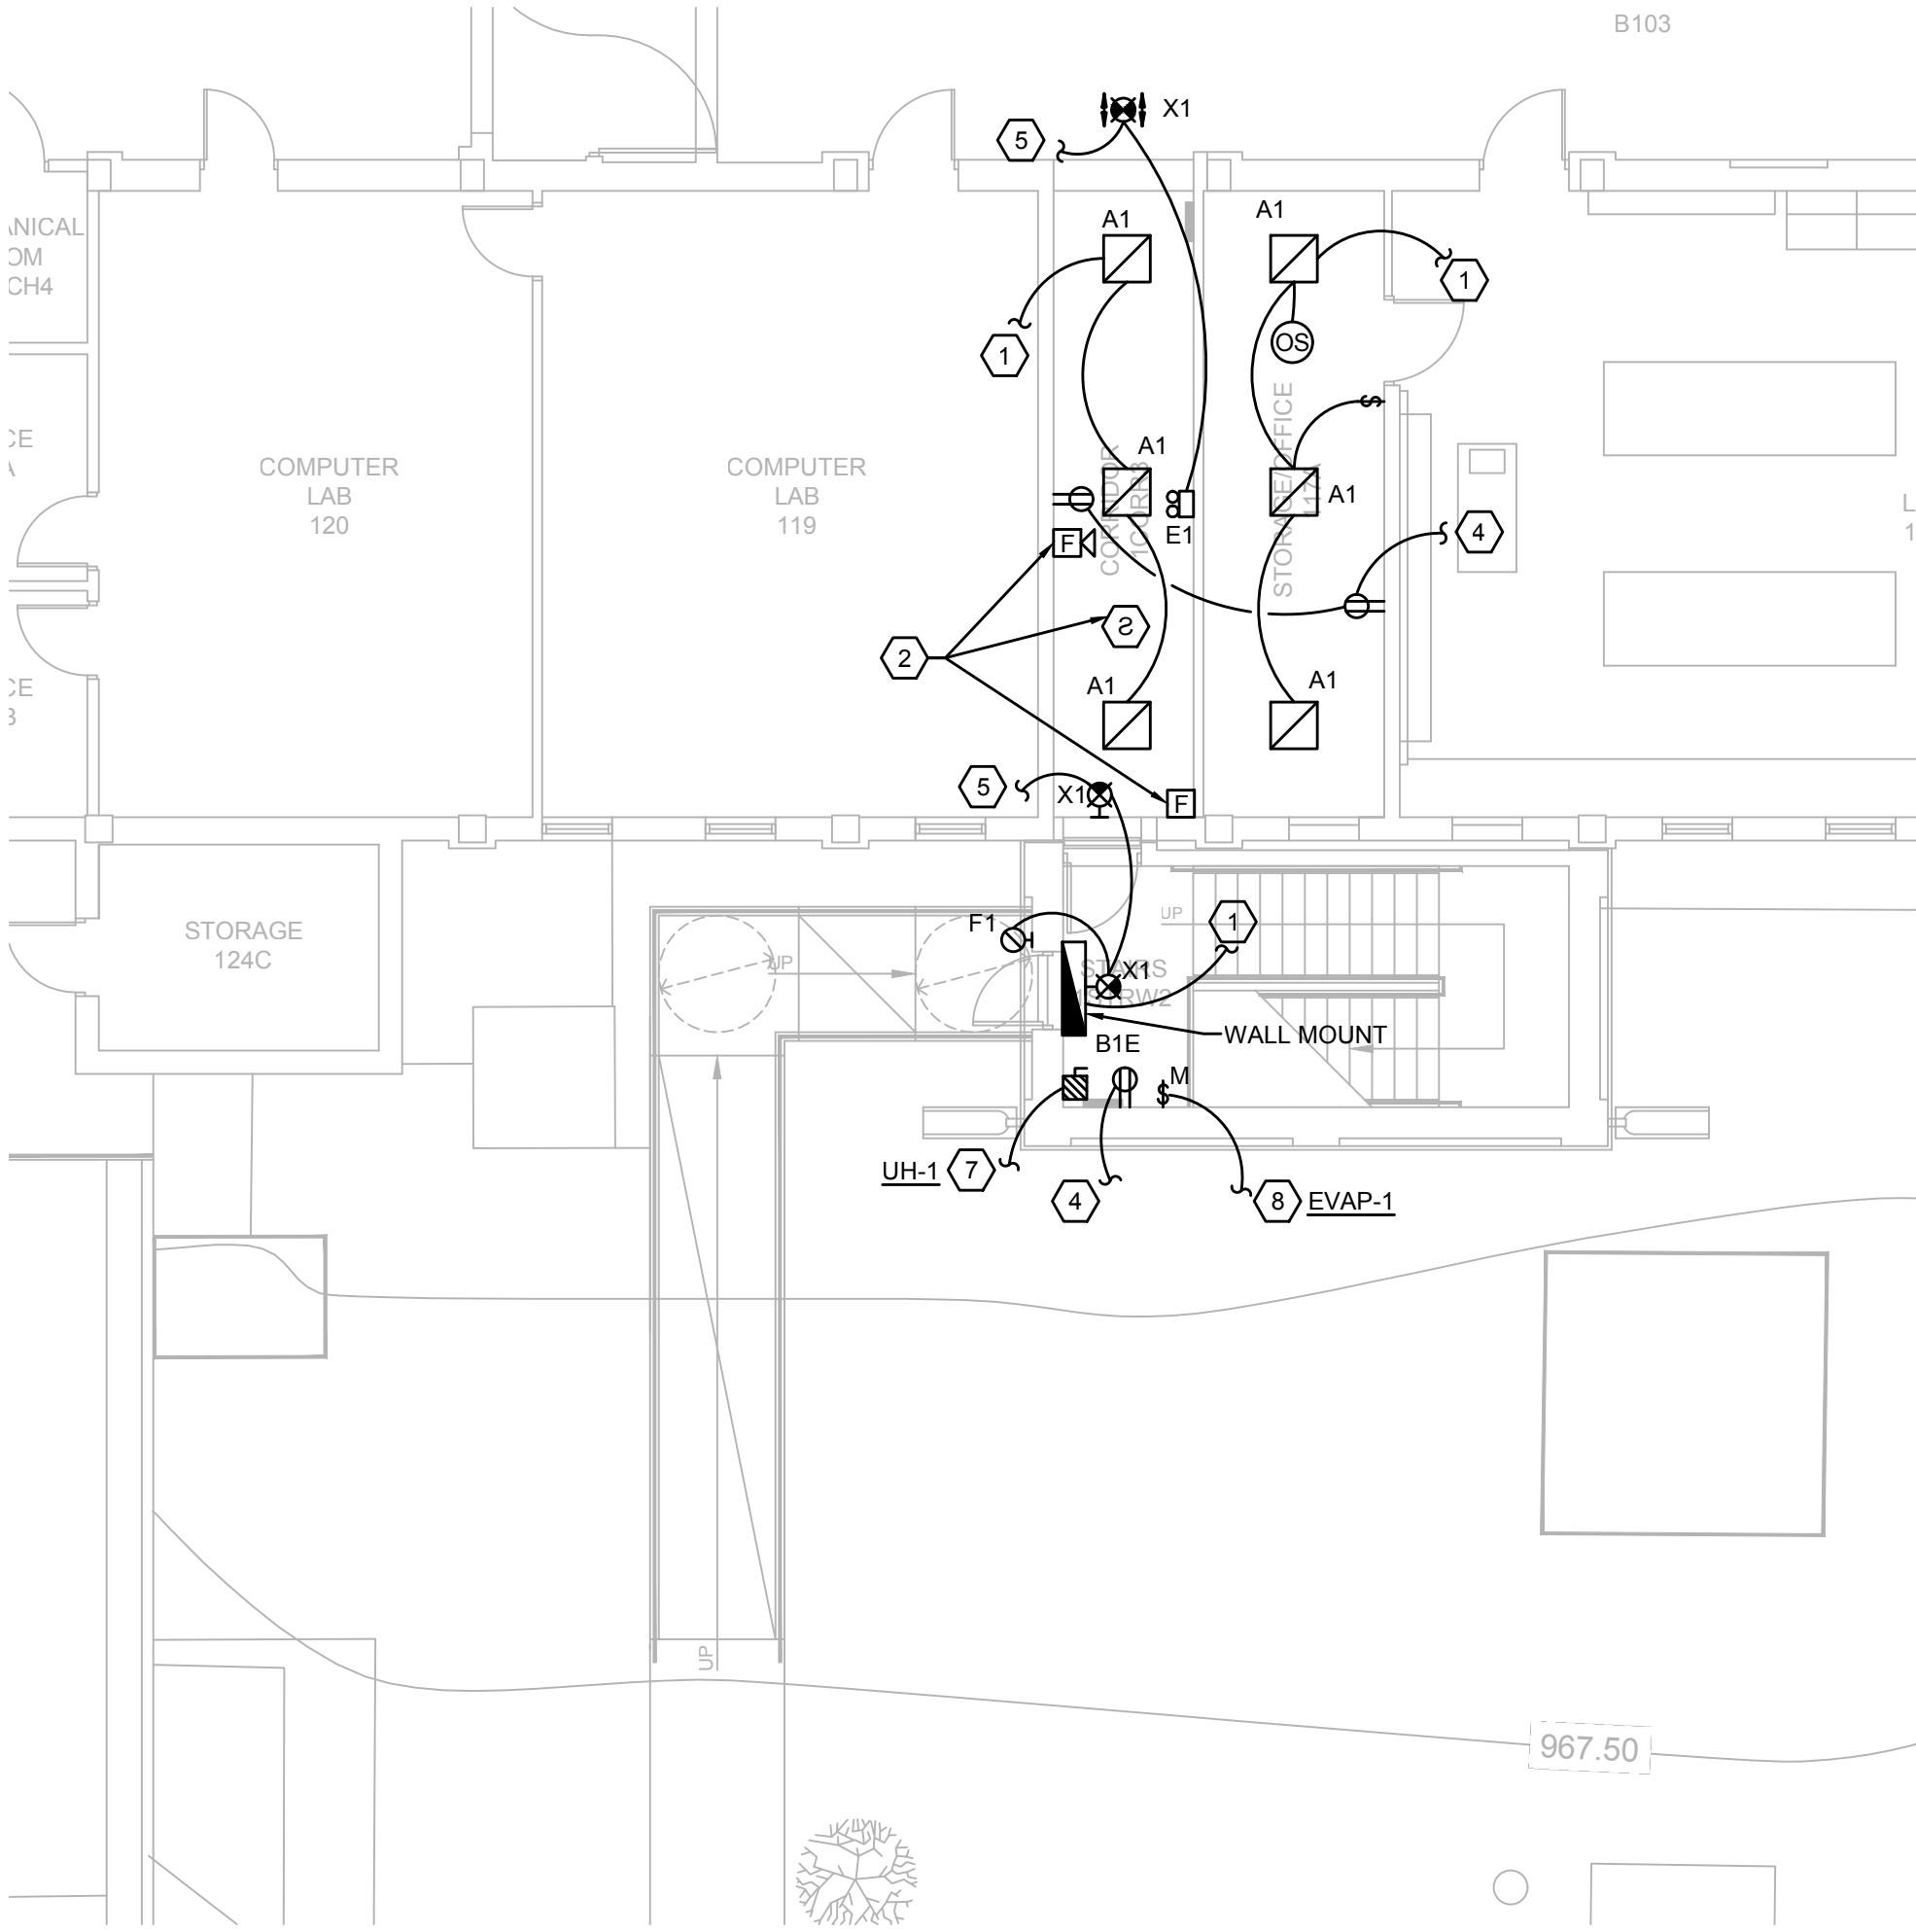

BOLIN SCIENCE HALL - FIRST FLOOR - AREA 1A
ELECTRICAL PLAN



DATE SIGNED:
HPA
ARCHITECTS • PROGRAMMERS • PLANNERS
HARPER PERKINS ARCHITECTS, INC.
4724 OLD JACKSBORO HIGHWAY
WICHITA FALLS, TEXAS 76302-3599
VOICE: 940.767.4121 FAX: 940.397.0273
E-MAIL: office@harperperkins.com WEB: www.harperperkins.com

CEI CAMPOS
ENGINEERING, Inc.
Consulting Engineers
1331 River Bend Drive
Dallas, Texas 75247
(214) 696-6291
campos@camposengineering.com
Registration No. F-001731
CEI Project Number D17-1263.00

TASADA - FIRE MARSHAL DEFERRED MAINTENANCE PROJECTS FOR
MIDWESTERN STATE UNIVERSITY
3410 TAFT BOULEVARD
WICHITA FALLS, TEXAS



DRAWN BY:
DATE: 15 MAY 2017

REVISIONS		
NO.	DESCRIPTION	DATE
1	ADDENDUM 1	08/02/17
2	ADDENDUM 2	08/10/17

16782.00

© 2017 HARPER PERKINS ARCHITECTS


B-E101

- ### GENERAL NOTES
- REFER TO ARCHITECTURAL OVERALL FLOOR PLANS FOR LOCATIONS SCOPE OF WORK AREAS WITHIN THE BUILDING.
 - REFER TO MECHANICAL AND PLUMBING PLANS FOR LOCATIONS AND INFORMATION ON MECHANICAL AND PLUMBING EQUIPMENT.
- ### KEY NOTES #
- CONNECT NEW LIGHTS TO EXISTING LIGHTING CIRCUIT SERVING THIS AREA (16A LOAD MAX. PER 20A CIRCUIT).
 - NEW FIRE ALARM DEVICE. CONNECT TO EXISTING FIRE ALARM SYSTEM. VERIFY LOCATION WITH AHJ PRIOR TO INSTALLATION.
 - RELOCATED LIGHT SWITCH. RECONNECT TO LIGHTING IN THIS AREA.
 - CONNECT NEW RECEPTACLE TO NEAREST EXISTING 120V RECEPTACLE CIRCUIT (16.0A LOAD MAX. PER 20A CIRCUIT).
 - CONNECT NEW EXIT SIGN AND EMERGENCY WALL PACK TO NEAREST AVAILABLE UNCONTROLLED LIGHTING CIRCUIT (16A LOAD MAX. PER 20A CIRCUIT).
 - RE-INSTALL THE EXISTING LIGHT FIXTURES IN THIS AREA AFTER THE NEW SPRINKLER PIPING HAS BEEN INSTALLED.
 - PROVIDE 30/NF/2 DISCONNECT SWITCH FOR UNIT HEATER, 208V, 1-PH, 2.5KW. USE CIRCUIT RC-37/39. FIELD VERIFY THAT THE EXISTING BREAKER IN THE PANEL IS 20A/2P. OTHERWISE REPLACE WITH NEW. ROUTE 2#10, #10G, 3/4" CONDUIT FROM BREAKER TO UNIT. FIELD COORDINATE ACTUAL LOCATION OF UNIT PRIOR TO ROUGH-IN. NEW CIRCUIT BREAKER SHALL MATCH THE EXISTING BREAKER AIC RATING.
 - EVAPORATOR UNITS EVAP-1 AND EVAP-2, 208V, 1-PH, 0.2A, TO BE CIRCUITED FROM OUTDOOR UNIT CIRCUIT CU-2 (RC-34/36), ROUTE 3#12, #12G, 3/4" FROM OUTDOOR UNIT VIA MOTOR RATED SWITCH. REFER TO MANUFACTURER'S WIRING INSTRUCTIONS FOR MORE INFORMATION BEFORE START OF WORK.
 - INSTALL NEW 2000KVA TRANSFORMER TO REPLACE THE EXISTING 2000KVA TRANSFORMER. PROVIDE ALL MATERIAL AND LABOR TO CONNECT THE NEW TRANSFORMER ASSEMBLY TO THE EXISTING PRIMARY AND SECONDARY SERVICES. COORDINATE THE WORK WITH THE OWNER FOR TIMING AND PHASING OF THE WORK IN ORDER TO MINIMIZE DISRUPTION OF SERVICE TO THE BUILDING. OBTAIN WRITTEN APPROVAL FROM THE OWNER AT MINIMUM OF FIVE BUSINESS DAYS PRIOR TO A SHUT DOWN OF SERVICE. SEE DRAWING B-E102 FOR ADDITIONAL DETAILS AND REQUIREMENTS.
 - NEW LOCATION OF RELOCATED EXISTING VENDING MACHINES. REFER TO B-E101. EXTEND CIRCUIT TO NEW LOCATION. PROVIDE NEW OUTLETS. COORDINATE WITH OWNER FOR EXACT LOCATION BEFORE ROUGH-IN.
 - NOT USED.
 - PROVIDE NEW TAP BOX AND TAP KIT FOR CONNECTION OF EXISTING BUSWAY FEEDING THE EXISTING MDP IN THE MECHANICAL ROOM AND THE NEW FEEDERS COMING FROM THE NEW TRANSFORMER. FIELD VERIFY THE LOCATION OF THE EXISTING BUSWAY.
 - REMOVE EXISTING PRIMARY CABLES BETWEEN SWITCH A AND EXISTING TRANSFORMER. PRESERVE DUCTBANK IN GOOD AND SAFE CONDITION FOR REUSE AND EXTENSION TO SERVE THE NEW TRANSFORMER. REFERENCE DRAWING B-E102 AND B-E201 FOR ADDITIONAL REQUIREMENTS.
 - COORDINATE ROUTING OF UNDERGROUND WIRING WITH NEW EQUIPMENT AND EXISTING INSTALLATION.
 - TWO NEW 4" DUCT IN CONCRETE DUCTBANK TO MATCH EXISTING AND EXTEND TO NEW TRANSFORMER. FIELD VERIFY EXISTING DUCT QUANTITIES AND SIZES, MATCH EXISTING. REFERENCE DRAWING B-E201.




DATE SIGNED:

ARCHITECTS PROGRAMMERS PLANNERS
HARPER PERKINS ARCHITECTS, INC.
4724 OLD JACKSBORO HIGHWAY
WICHITA FALLS, TEXAS 76302-3599
VOICE: 940.787.1421 Fax: 940.387.0273
E-MAIL: office@harperperkins.com WEB: www.harperperkins.com

 CAMPOS
ENGINEERING, Inc.
Consulting Engineers
1331 River Bend Drive
Dallas, Texas 75247
(214) 696-6291
campos@camposengineering.com
Registration No. F-001731
CEI Project Number D17-1263.00

TASADA - FIRE MARSHAL DEFERRED MAINTENANCE PROJECTS FOR
MIDWESTERN STATE UNIVERSITY
3410 TAFT BOULEVARD
WICHITA FALLS, TEXAS



DRAWN BY:		
DATE: 15 MAY 2017		
REVISIONS		
NO.	DESCRIPTION	DATE
	ADDENDUM 2	08/10/17

16782.00

© 2017 HARPER PERKINS ARCHITECTS

E001

GENERAL NOTES FIRE ALARM DEMOLITION

- REMOVE EXISTING WORK AS REQUIRED TO CLEAR THE AREAS FOR THE NEW CONSTRUCTION.
- ALL EQUIPMENT REMOVED THAT IS NOT BEING REUSED SHALL REMAIN THE PROPERTY OF THE OWNER AND SHALL BE STORED OR DISPOSED OF AS DIRECTED.
- EXISTING FIRE ALARM RACEWAY OR WIRING THAT IS NOT TO BE REUSED SHALL BE REMOVED BACK TO THE NEAREST ACTIVE JUNCTION BOX OR ACTIVE PULL BOX AND THE OPENINGS BLANKED. CONDUITS IN MASONRY SHALL BE CUT BELOW THE SURFACE AND THE MASONRY SURFACE PATCHED.
- EXISTING FIRE ALARM RACEWAY OR WIRING THAT INTERFERES WITH THE NEW WORK SHALL BE RELOCATED AND REVISED AS REQUIRED TO ACCOMMODATE THE NEW WORK.
- MAINTAIN THE FIRE ALARM PROTECTION FOR ALL AREAS DURING DEMOLITION AS REQUIRED BY THE AHJ.
- REMOVE ALL EXISTING EQUIPMENT NOT REUSED OR NOT NECESSARY FOR THE COMPLETION OF THE WORK.
- COORDINATE ALL DEMOLITION WORK WITH ALL TRADES.
- PROVIDE FIRE STOPPING AT ALL UNUSED OR REMOVED CONDUIT PENETRATIONS THROUGH EXISTING FLOOR SLABS AND WALLS TO MAINTAIN CURRENT FIRE RATING AND INTEGRITY OF THE WALL OR FLOOR ASSEMBLY. USE U.L. LISTED METHODS AND MATERIALS.
- REPAIR THE CEILINGS, WALLS AND FLOORS TO MATCH THE ADJACENT UNAFFECTED AREAS WHERE ITEMS ARE TO BE REMOVED AND NOT REPLACED.

GENERAL NOTES FIRE ALARM EXISTING CONDITIONS

- THE EXISTING AREAS OF WORK ARE BASED UPON EXISTING CONSTRUCTION DOCUMENTS AND VISUAL SURVEY. THE DRAWINGS ARE DIAGRAMMATIC AND ARE NOT INTENDED TO SHOW THE FULL SCOPE OF EXISTING CONDITIONS THAT MAY AFFECT THE WORK. A FIELD VISIT, PRIOR TO SUBMITTING A BID, IS REQUIRED TO CAREFULLY EXAMINE AND FIELD VERIFY THE EXISTING CONDITIONS. FIELD VERIFY THE QUANTITY AND LOCATION OF ALL EXISTING EQUIPMENT AND THE DIMENSIONS, ETC., PRIOR TO BID. PROVIDE ALL LABOR AND MATERIALS TO:
 - MODIFY EXISTING CONDITIONS TO ACCOMMODATE THE NEW WORK.
 - REPAIR OR REWORK EXISTING SYSTEMS TO REMAIN SO THEY COMPLY WITH CODE REQUIREMENTS AND OPERATE PROPERLY.
 - COORDINATE THE WORK WITH ALL OTHER TRADES.
 - PROVIDE A COMPLETE AND OPERATING INSTALLATION.
- PREVENT DAMAGE TO EXISTING EQUIPMENT TO BE RELOCATED OR REUSED. WHERE DAMAGE OCCURS, REPLACE OR REPAIR THE EQUIPMENT TO THE SATISFACTION OF THE ENGINEER AT NO ADDITIONAL COST. THOROUGHLY CLEAN ALL ITEMS BEFORE REINSTALLATION.
- PAINT, PATCH AND REPAIR ADJACENT AREAS THAT ARE AFFECTED BY THE WORK TO MATCH THE UNAFFECTED ADJACENT SURFACE.

FIRE ALARM DESIGN AND INSTALLATION GENERAL NOTES

- THE FIRE ALARM DESIGN IS PERFORMANCE BASED. A COMPLETE FIRE ALARM SYSTEM SHALL BE DESIGNED AND SEALED BY A NICET LEVEL IV CERTIFIED DESIGNER. THE EXACT DEVICE LOCATIONS, NUMBER OF DEVICES, DEVICE TYPES, WIRING, POWER SUPPLIES, VOLTAGE DROP, CALCULATIONS, ETC., SHALL BE PROVIDED WITH SHOP DRAWINGS PREPARED BY THE LICENSED FIRE ALARM DESIGNER.
- VISIT THE SITE PRIOR TO BID AND FIELD VERIFY EXISTING CONDITIONS. COORDINATE THE FIRE ALARM DESIGN AND INSTALLATION REQUIREMENTS WITH OTHER TRADES PRIOR TO BID AND DURING CONSTRUCTION. PROVIDE ALL LABOR MATERIALS REQUIRED FOR A COMPLETE CODE COMPLIANT FIRE ALARM SYSTEM.
- PROVIDE THE DESIGN AND LAYOUT AND INSTALLATION OF A COMPLETE SYSTEM IN ACCORDANCE WITH THE APPLICABLE CODES AND STANDARDS (INCLUDING ADA, LIFE SAFETY AND ANY OTHER REQUIREMENTS OF THE AUTHORITY HAVING JURISDICTION). COORDINATE THE DESIGN WITH ALL THE CONTRACT DRAWINGS AND SPECIFICATIONS AND COORDINATE THE INSTALLATION WITH ALL TRADES TO PROVIDE A COMPLETE DESIGN AND INSTALLATION.
- THE LICENSED FIRE ALARM DESIGNER SHALL SUBMIT DRAWINGS TO THE STATE FIRE MARSHAL'S OFFICE AND/OR AUTHORITY HAVING JURISDICTION FOR APPROVAL PRIOR TO SUBMITTING SHOP DRAWINGS TO ENGINEER.
- REFERENCE MECHANICAL DRAWINGS FOR THE DESIGN AND INSTALLATION OF DUCT DETECTORS, FIRE/SMOKE DAMPERS AND CONTROL DAMPERS. COORDINATE THE ELECTRIC POWER AND CONTROL REQUIREMENTS WITH OTHER TRADES. PROVIDE A COMPLETE AND OPERATING SYSTEM. SEE MECHANICAL CONTROL DRAWINGS FOR ADDITIONAL INFORMATION.
- COORDINATE THE DESIGN AND INSTALLATION OF ELECTRICAL POWER AND CONTROL REQUIREMENTS FOR FIRE DOORS WITH OTHER TRADES. PROVIDE A COMPLETE OPERATING SYSTEM.
- VERIFY THE FINAL LOCATION OF THE FIRE ALARM CONTROL AND ANNUNCIATOR (WHERE REQUIRED) PANELS WITH THE LOCAL AUTHORITY HAVING JURISDICTION PRIOR TO ROUGH-IN. NOTIFY THE ENGINEER IF THE LOCATION VARIES FROM THE LOCATION SHOWN ON THE DRAWINGS. PROVIDE THE DESIGN, LABOR AND MATERIALS TO ACCOMMODATE A REVISED LOCATION.
- COORDINATE THE LOCATION AND INSTALLATION OF THE ELECTRICAL POWER FOR ALL FIRE ALARM CONTROL PANELS AND RELATED DEVICES WITH THE OTHER TRADES. PROVIDE A COMPLETE OPERATING SYSTEM.
- SEAL PENETRATIONS OF RATED WALLS WITH APPROVED FIRE CAULKING TO MAINTAIN THE FIRE RATING AND INTEGRITY OF THE WALL ASSEMBLY.
- PENETRATIONS OF EXTERIOR WALLS AND ROOF DECK SHALL BE WEATHER TIGHT.
- COORDINATE THE LOCATION/ROUGH-IN AND INSTALLATION OF CONDUITS, J-BOXES, BACK BOXES, ETC., WITH THE OTHER TRADES. PROVIDE A COMPLETE OPERATING SYSTEM.
- REFER TO THE PROJECT SPECIFICATIONS FOR ADDITIONAL SYSTEM PERFORMANCE REQUIREMENTS.
- THE MOST STRINGENT REQUIREMENT SHALL GOVERN WHEN THERE ARE CONFLICTS BETWEEN THE SPECIFICATIONS AND DRAWINGS.

GENERAL NOTES ELECTRICAL DEMOLITION


- REMOVE EXISTING WORK AS INDICATED ON THE DRAWINGS OR AS REQUIRED TO CLEAR THE AREAS FOR THE NEW CONSTRUCTION.
- ALL EQUIPMENT REMOVED THAT IS NOT TO BE REUSED SHALL REMAIN THE PROPERTY OF THE OWNER AND SHALL BE STORED OR DISPOSED OF AS DIRECTED.
- COMPLETELY REMOVE ELECTRICAL WORK SHOWN TO BE DEMOLISHED OR IS NOT REQUIRED. EXISTING RACEWAYS THAT ARE NOT TO BE REUSED SHALL BE REMOVED BACK TO THE NEAREST ACTIVE JUNCTION BOX OR ACTIVE PULL BOX AND THE OPENINGS BLANKED. CONDUITS IN MASONRY SHALL BE CUT BELOW THE SURFACE AND THE MASONRY SURFACES PATCHED.
- DURING DEMOLITION WORK, MAINTAIN POWER TO ALL CIRCUITS THAT ARE TO REMAIN IN SERVICE.
- REMOVE AND DISPOSE OF ALL EXISTING ELECTRICAL EQUIPMENT NOT REUSED OR NOT NECESSARY FOR THE COMPLETION OF THIS PROJECT.
- COORDINATE ALL DEMOLITION WORK WITH ALL TRADES.
- PROVIDE FIRE STOPPING AT ALL UNUSED OR REMOVED CONDUIT PENETRATIONS THROUGH EXISTING FLOOR SLABS AND WALLS TO MAINTAIN CURRENT FIRE RATING AND THE INTEGRITY OF THE WALL OR FLOOR ASSEMBLY. USE UL LISTED METHODS AND MATERIALS.
- REPAIR (AS REQUIRED) THE CEILINGS, WALLS AND FLOORS TO MATCH THE SURROUNDING AREAS WHERE ITEMS ARE TO BE REMOVED AND NOT REPLACED.
- VISIT THE SITE PRIOR TO BID AND FIELD VERIFY EXISTING CONDITIONS. NOTIFY THE ENGINEER WHERE EXISTING CONDITIONS ARE IN CONFLICT WITH THE CONSTRUCTION DOCUMENTS. COORDINATE THE ELECTRICAL DEMOLITION SCOPE OF WORK WITH THE OTHER TRADES AND INCLUDE ALL LABOR AND MATERIALS FOR A COMPLETE AND OPERATING INSTALLATION.

GENERAL NOTES EXISTING ELECTRICAL CONDITIONS

- THE EXISTING AREAS OF WORK, INCLUDING SITE UTILITIES SHOWN ON THE DRAWINGS, ARE BASED UPON EXISTING CONSTRUCTION DOCUMENTS AND VISUAL SURVEY. THE DRAWINGS ARE DIAGRAMMATIC AND ARE NOT INTENDED TO SHOW THE FULL SCOPE OF EXISTING CONDITIONS THAT MAY AFFECT THE WORK. A FIELD VISIT, PRIOR TO SUBMITTING A BID, IS REQUIRED TO CAREFULLY EXAMINE AND FIELD VERIFY THE EXISTING CONDITIONS. FIELD VERIFY DIMENSIONS OF ALL EXISTING EQUIPMENT LOCATIONS AND THE DIMENSIONS OF SITE UTILITIES, ETC., PRIOR TO BID. PROVIDE ALL LABOR AND MATERIALS TO:
 - MODIFY EXISTING CONDITIONS TO ACCOMMODATE THE NEW WORK.
 - REPAIR OR REWORK EXISTING SYSTEMS TO REMAIN SO THEY COMPLY WITH CODE REQUIREMENTS AND OPERATE PROPERLY.
 - COORDINATE THE WORK WITH ALL OTHER TRADES.
 - PROVIDE A COMPLETE AND OPERATING INSTALLATION.
- PREVENT DAMAGE TO EXISTING EQUIPMENT TO BE RELOCATED OR REUSED. WHERE DAMAGE OCCURS, REPLACE OR REPAIR THE EQUIPMENT TO THE SATISFACTION OF THE ENGINEER AT NO ADDITIONAL COST. THOROUGHLY CLEAN ALL ITEMS BEFORE REINSTALLATION.
- PAINT, PATCH AND REPAIR ADJACENT AREAS THAT ARE AFFECTED BY THE WORK TO MATCH THE UNAFFECTED ADJACENT SURFACE.
- CLEAN AND RELAP ALL LIGHT FIXTURES THAT ARE TO BE RELOCATED OR REUSED.
- NEATLY UPDATE EXISTING PANELBOARD SCHEDULES TO SHOW ALL CHANGES. PROVIDE A NEW TYPEWRITTEN SCHEDULE IF REQUIRED BY THE ENGINEER.
- LOCATE ALL EXISTING UTILITIES PRIOR TO STARTING THE WORK. PROTECT EXISTING UTILITIES FROM DAMAGE.
- RELOCATE EXISTING ELECTRICAL POWER OR LIGHTING EQUIPMENT OR SYSTEMS AS REQUIRED THAT INTERFERE WITH THE NEW WORK AND TO ACCOMMODATE THE WORK OF OTHER TRADES.
- ELECTRICAL DEVICES, EQUIPMENT AND SYSTEMS LOCATED IN AREAS OUTSIDE THE AREA OF WORK SHALL REMAIN IN SERVICE UNLESS OTHERWISE NOTED. FURNISH AND INSTALL ACCESSIBLE JUNCTION BOXES AND REWORK EXISTING CIRCUITS AS REQUIRED TO MAINTAIN SERVICE CONTINUITY.
- NEW CIRCUIT BREAKERS INSTALLED IN EXISTING PANELBOARDS SHALL BE OF THE SAME MANUFACTURER AND MATCH THE SHORT CIRCUIT RATING (AIC) AS THE PANELBOARD.


GENERAL ELECTRICAL NOTES

- THE CONSTRUCTION DRAWINGS ARE DIAGRAMMATIC. COORDINATE THE INSTALLATION OF THE ELECTRICAL SYSTEMS WITH THE OTHER TRADES. CORRECT INTERFERENCES AT NO ADDITIONAL COST.
- COORDINATE THE FINAL LOCATION OF THE MECHANICAL, FIRE ALARM, FIRE SPRINKLER AND OTHER TRADES EQUIPMENT PRIOR TO ROUGH-IN. PROVIDE ALL LABOR AND MATERIALS FOR A COMPLETE INSTALLATION.
- COORDINATE THE WORK, INCLUDING POWER OUTAGES, WITH THE OWNER'S OPERATIONS. MAINTAIN POWER TO ESSENTIAL SERVICES AT NO ADDITIONAL COST.
- PROVIDE ADDITIONAL SUPPORT FOR ELECTRICAL EQUIPMENT AND RACEWAY TO PROVIDE A STRUCTURALLY SOUND INSTALLATION.
- SEAL RACEWAY AND WIRING THAT ENTER CONDITIONED AREAS FROM NONCONDITIONED AREAS TO PROVIDE AN AIRTIGHT SEAL. USE U.L. LISTED MATERIALS AND METHODS.
- ALL NEW DEVICES SHALL BE FLUSH MOUNTED UNLESS NOTED OTHERWISE.
- SIZE ELECTRICAL GROUNDING CONDUCTORS PER THE NATIONAL ELECTRICAL CODE (NEC) 250-122.
- EXISTING FLOOR, WALL OR CEILING AREAS THAT ARE MODIFIED SHALL BE REPAIRED/PATCHED AND PAINTED TO MATCH THE UNAFFECTED ADJACENT AREA.
- THE USE OF ANY PROCESS OR MATERIAL CONTAINING ASBESTOS OR PCB IS PROHIBITED.
- PROVIDE ALL LABOR, MATERIALS, TRANSPORT AND PROPER DISPOSAL OR RECYCLING OF ALL WASTE MATERIAL. UPON REQUEST, PROVIDE WRITTEN CERTIFICATION THAT THE DISPOSAL AND RECYCLING COMPLY WITH ALL FEDERAL, EPA, STATE AND LOCAL GOVERNMENT REGULATIONS.

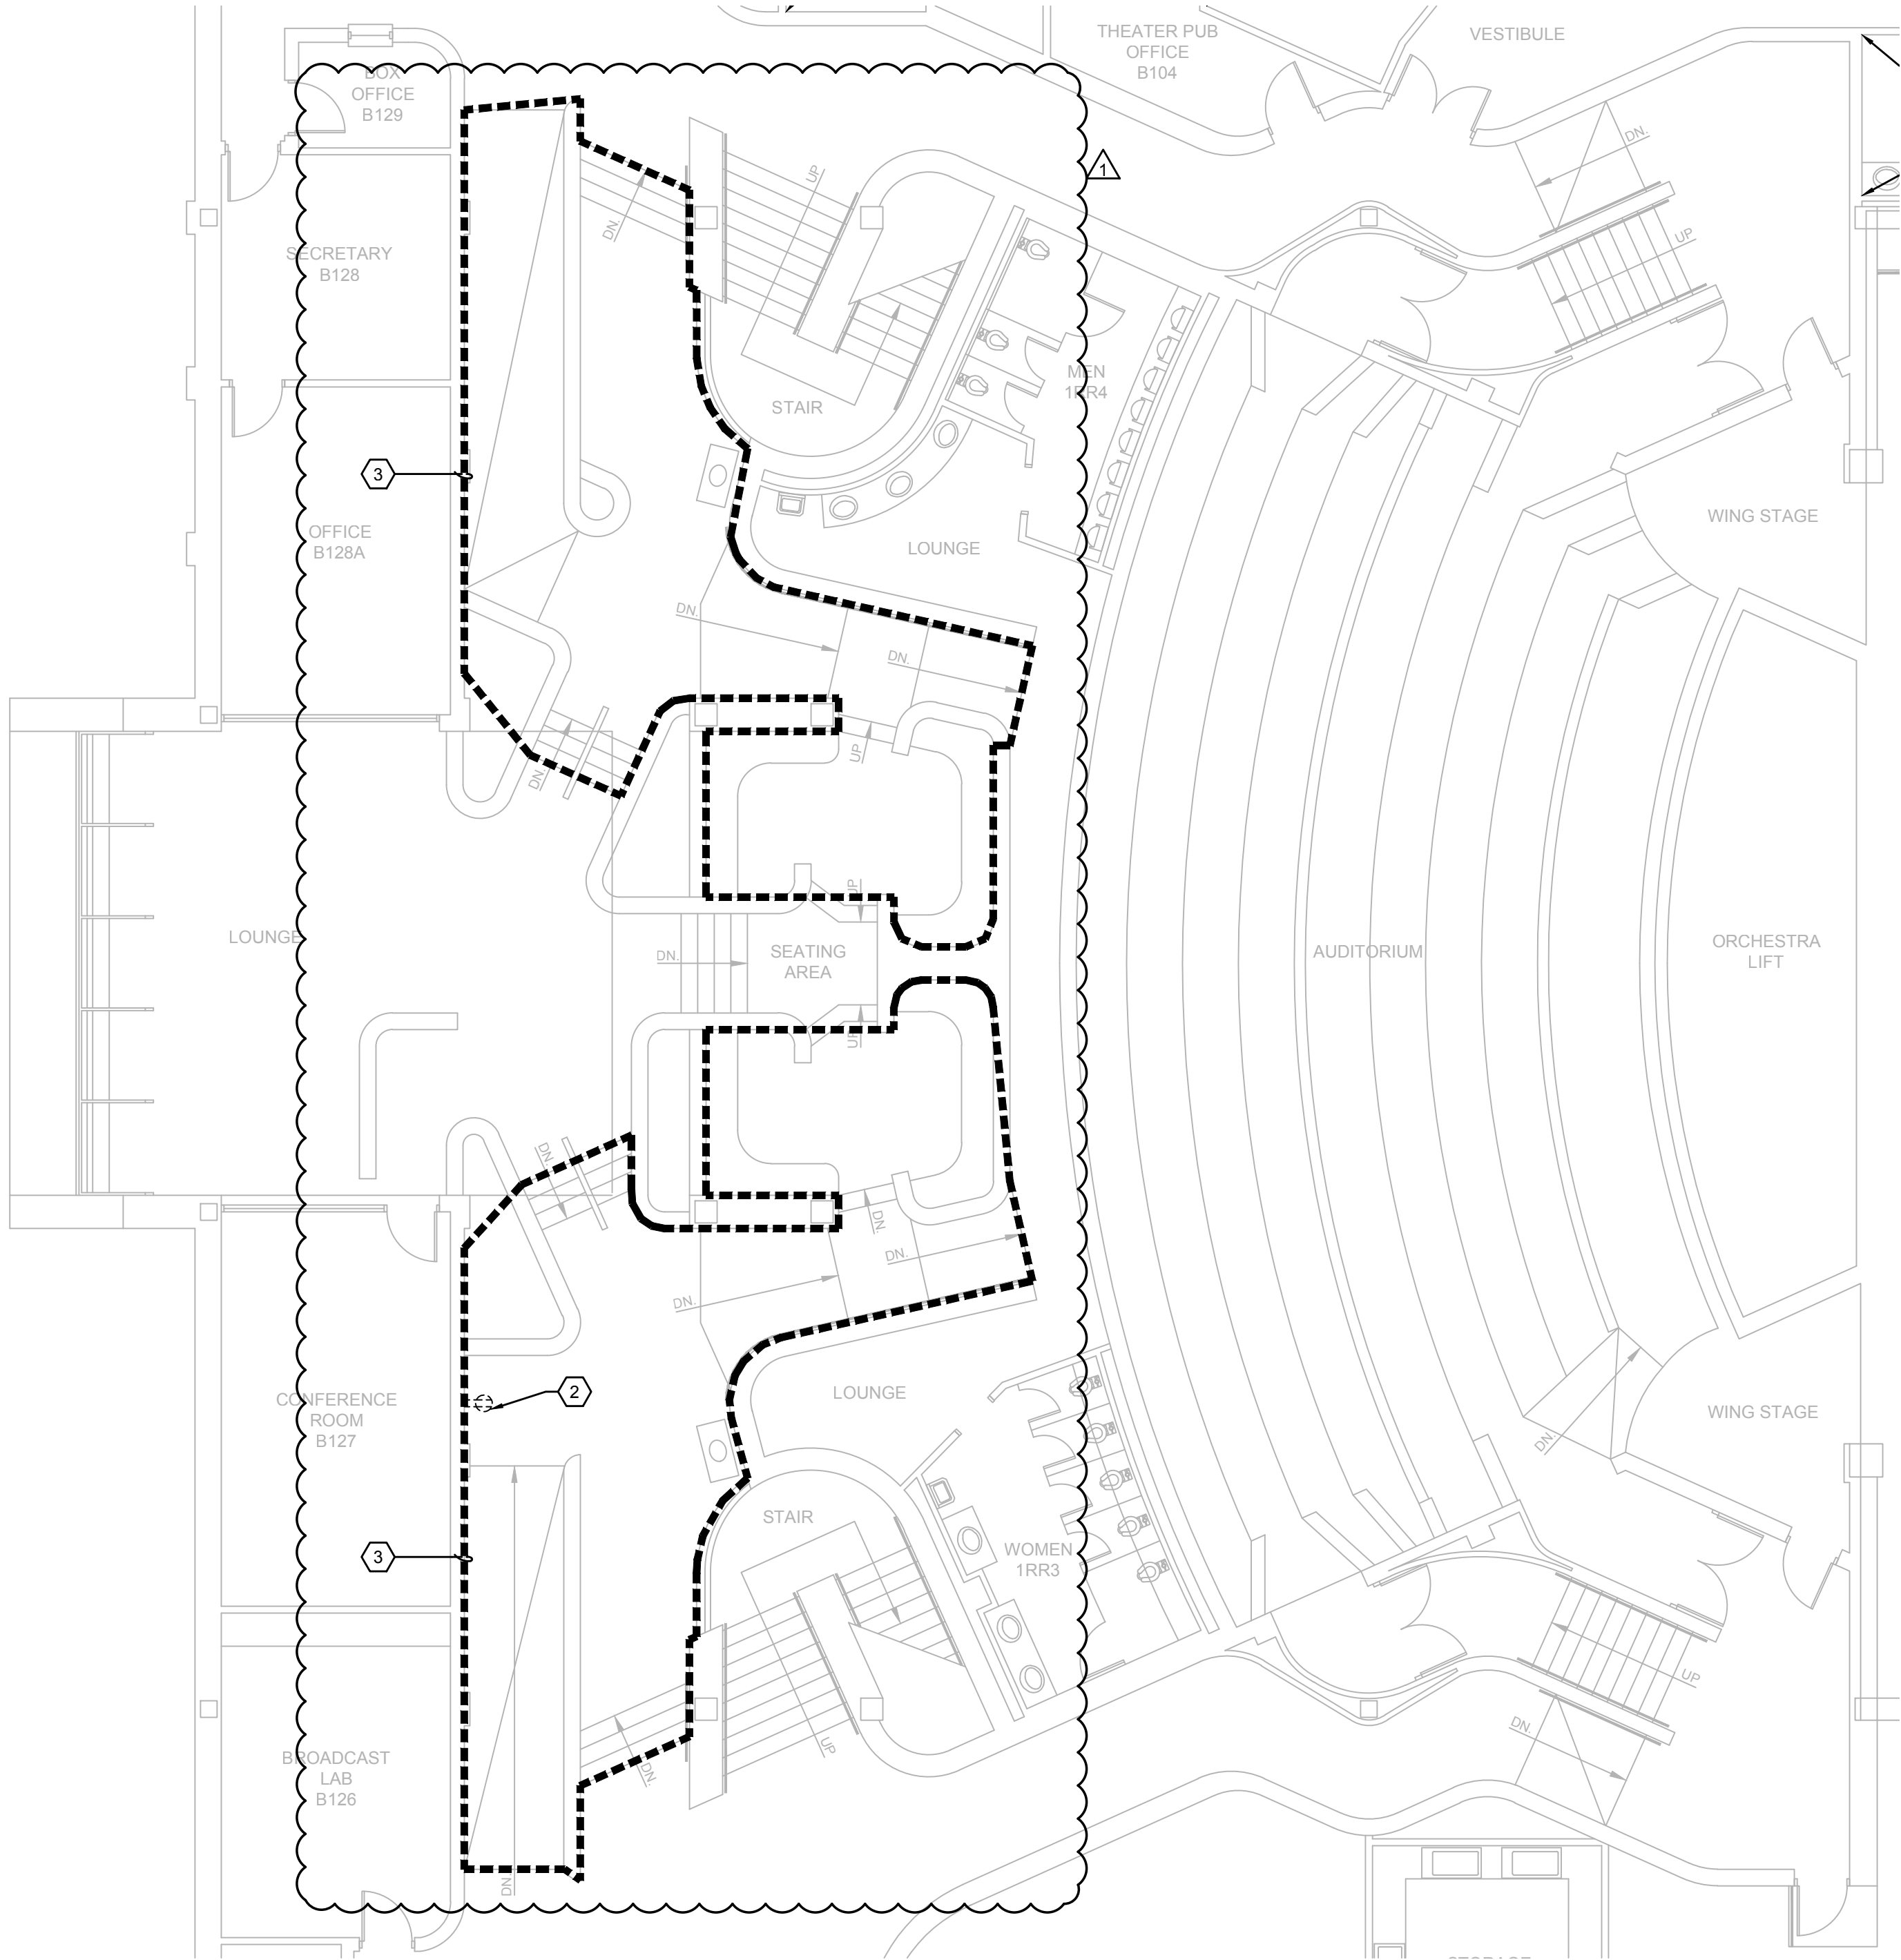

 1
FF-ED102 SCALE: 1/8" = 1'-0"

**FAIN FINE ARTS - FIRST FLOOR - AREA 1D
ELECTRICAL DEMOLITION PLAN**

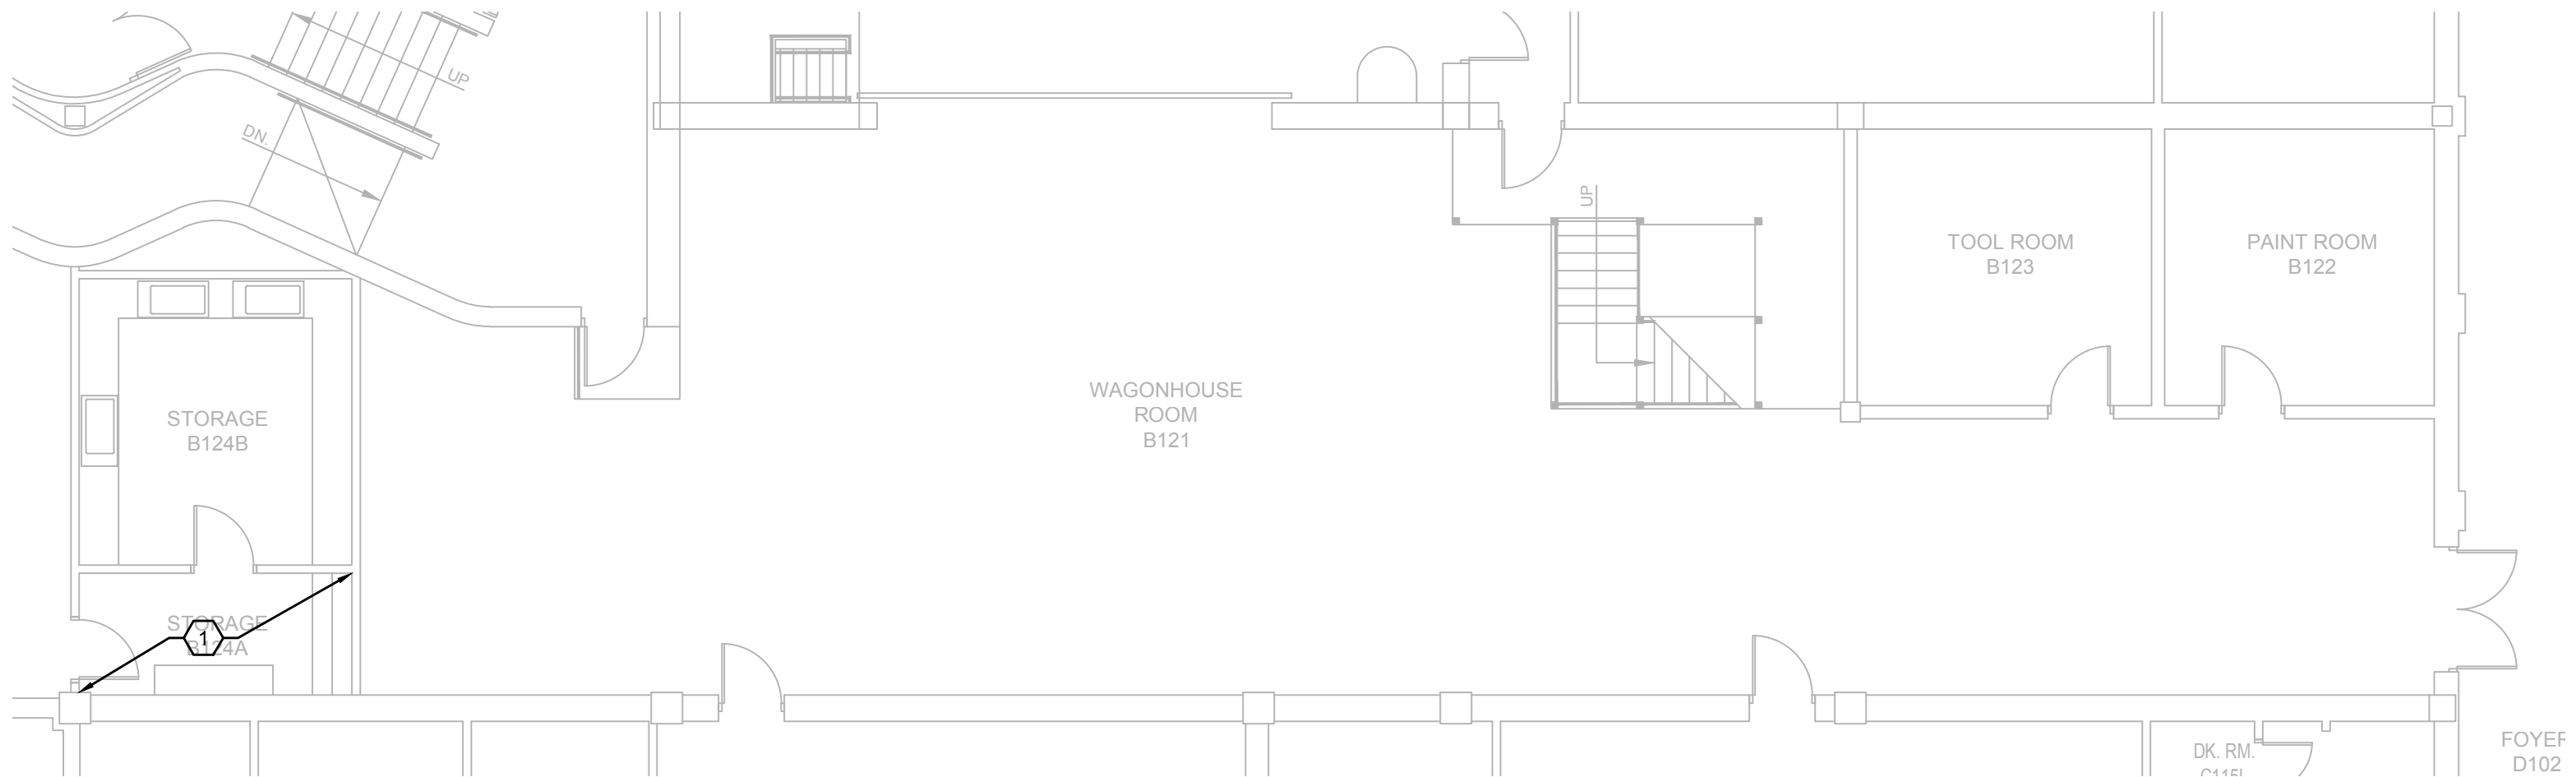

 1
FF-ED102 SCALE: 1/8" = 1'-0"

**FAIN FINE ARTS - FIRST FLOOR - AREA 1C
ELECTRICAL DEMOLITION PLAN**

GENERAL NOTES


1. REFER TO ARCHITECTURAL OVERALL FLOOR PLANS FOR LOCATIONS SCOPE OF WORK AREAS WITHIN THE BUILDING.

KEY NOTES

1. REMOVE ALL LIGHTS IN THIS AREA. RETAIN CIRCUITING FOR RE-USE WITH NEW LIGHTS. FIELD COORDINATE THE EXTENT OF THE CEILING DEMO WITH ARCHITECT PRIOR TO DEMOLITION.

2. REMOVE EXISTING WIRING DEVICE. RETAIN CIRCUITING FOR RE-USE.

3. REFER TO ARCHITECTURAL PLANS FOR THE EXTENT OF DEMOLITION IN THIS AREA. FIELD VERIFY LOCATION AND QUANTITY OF ELECTRICAL RECEPTACLES IN THIS AREA. REMOVE ALL WALL MOUNTED RECEPTACLES. RETAIN BRANCH CIRCUITING FOR RE-USE. REFER TO FF-E102.

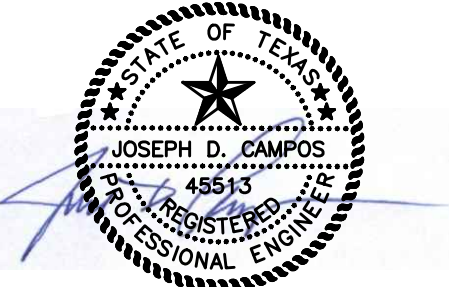

DATE SIGNED:
HPA
HARPER PERKINS ARCHITECTS, INC.
4724 OLD JACKSBORO HIGHWAY
WICHITA FALLS, TEXAS 76302-3599
VOICE: 940.707.1421 FAX: 940.297.0273
E-MAIL: office@harperperkins.com WEB: www.harperperkins.com


CEI
CAMPOS
ENGINEERING, Inc.
Consulting Engineers
1331 River Bend Drive
Dallas, Texas 75247
(214) 696-6291
campos@camposengineering.com
Registration No. F-00731
CEI Project Number D17-1263.00

TAS/ADA - FIRE MARSHAL DEFERRED MAINTENANCE PROJECTS FOR
MIDWESTERN STATE UNIVERSITY
3410 TAFT BOULEVARD
WICHITA FALLS, TEXAS




DRAWN BY:		
DATE: 15 MAY 2017		
REVISIONS		
NO.	DESCRIPTION	DATE
1	ADDENDUM 2	08/10/17

16782.00
© 2017 HARPER PERKINS ARCHITECTS
FF-ED102

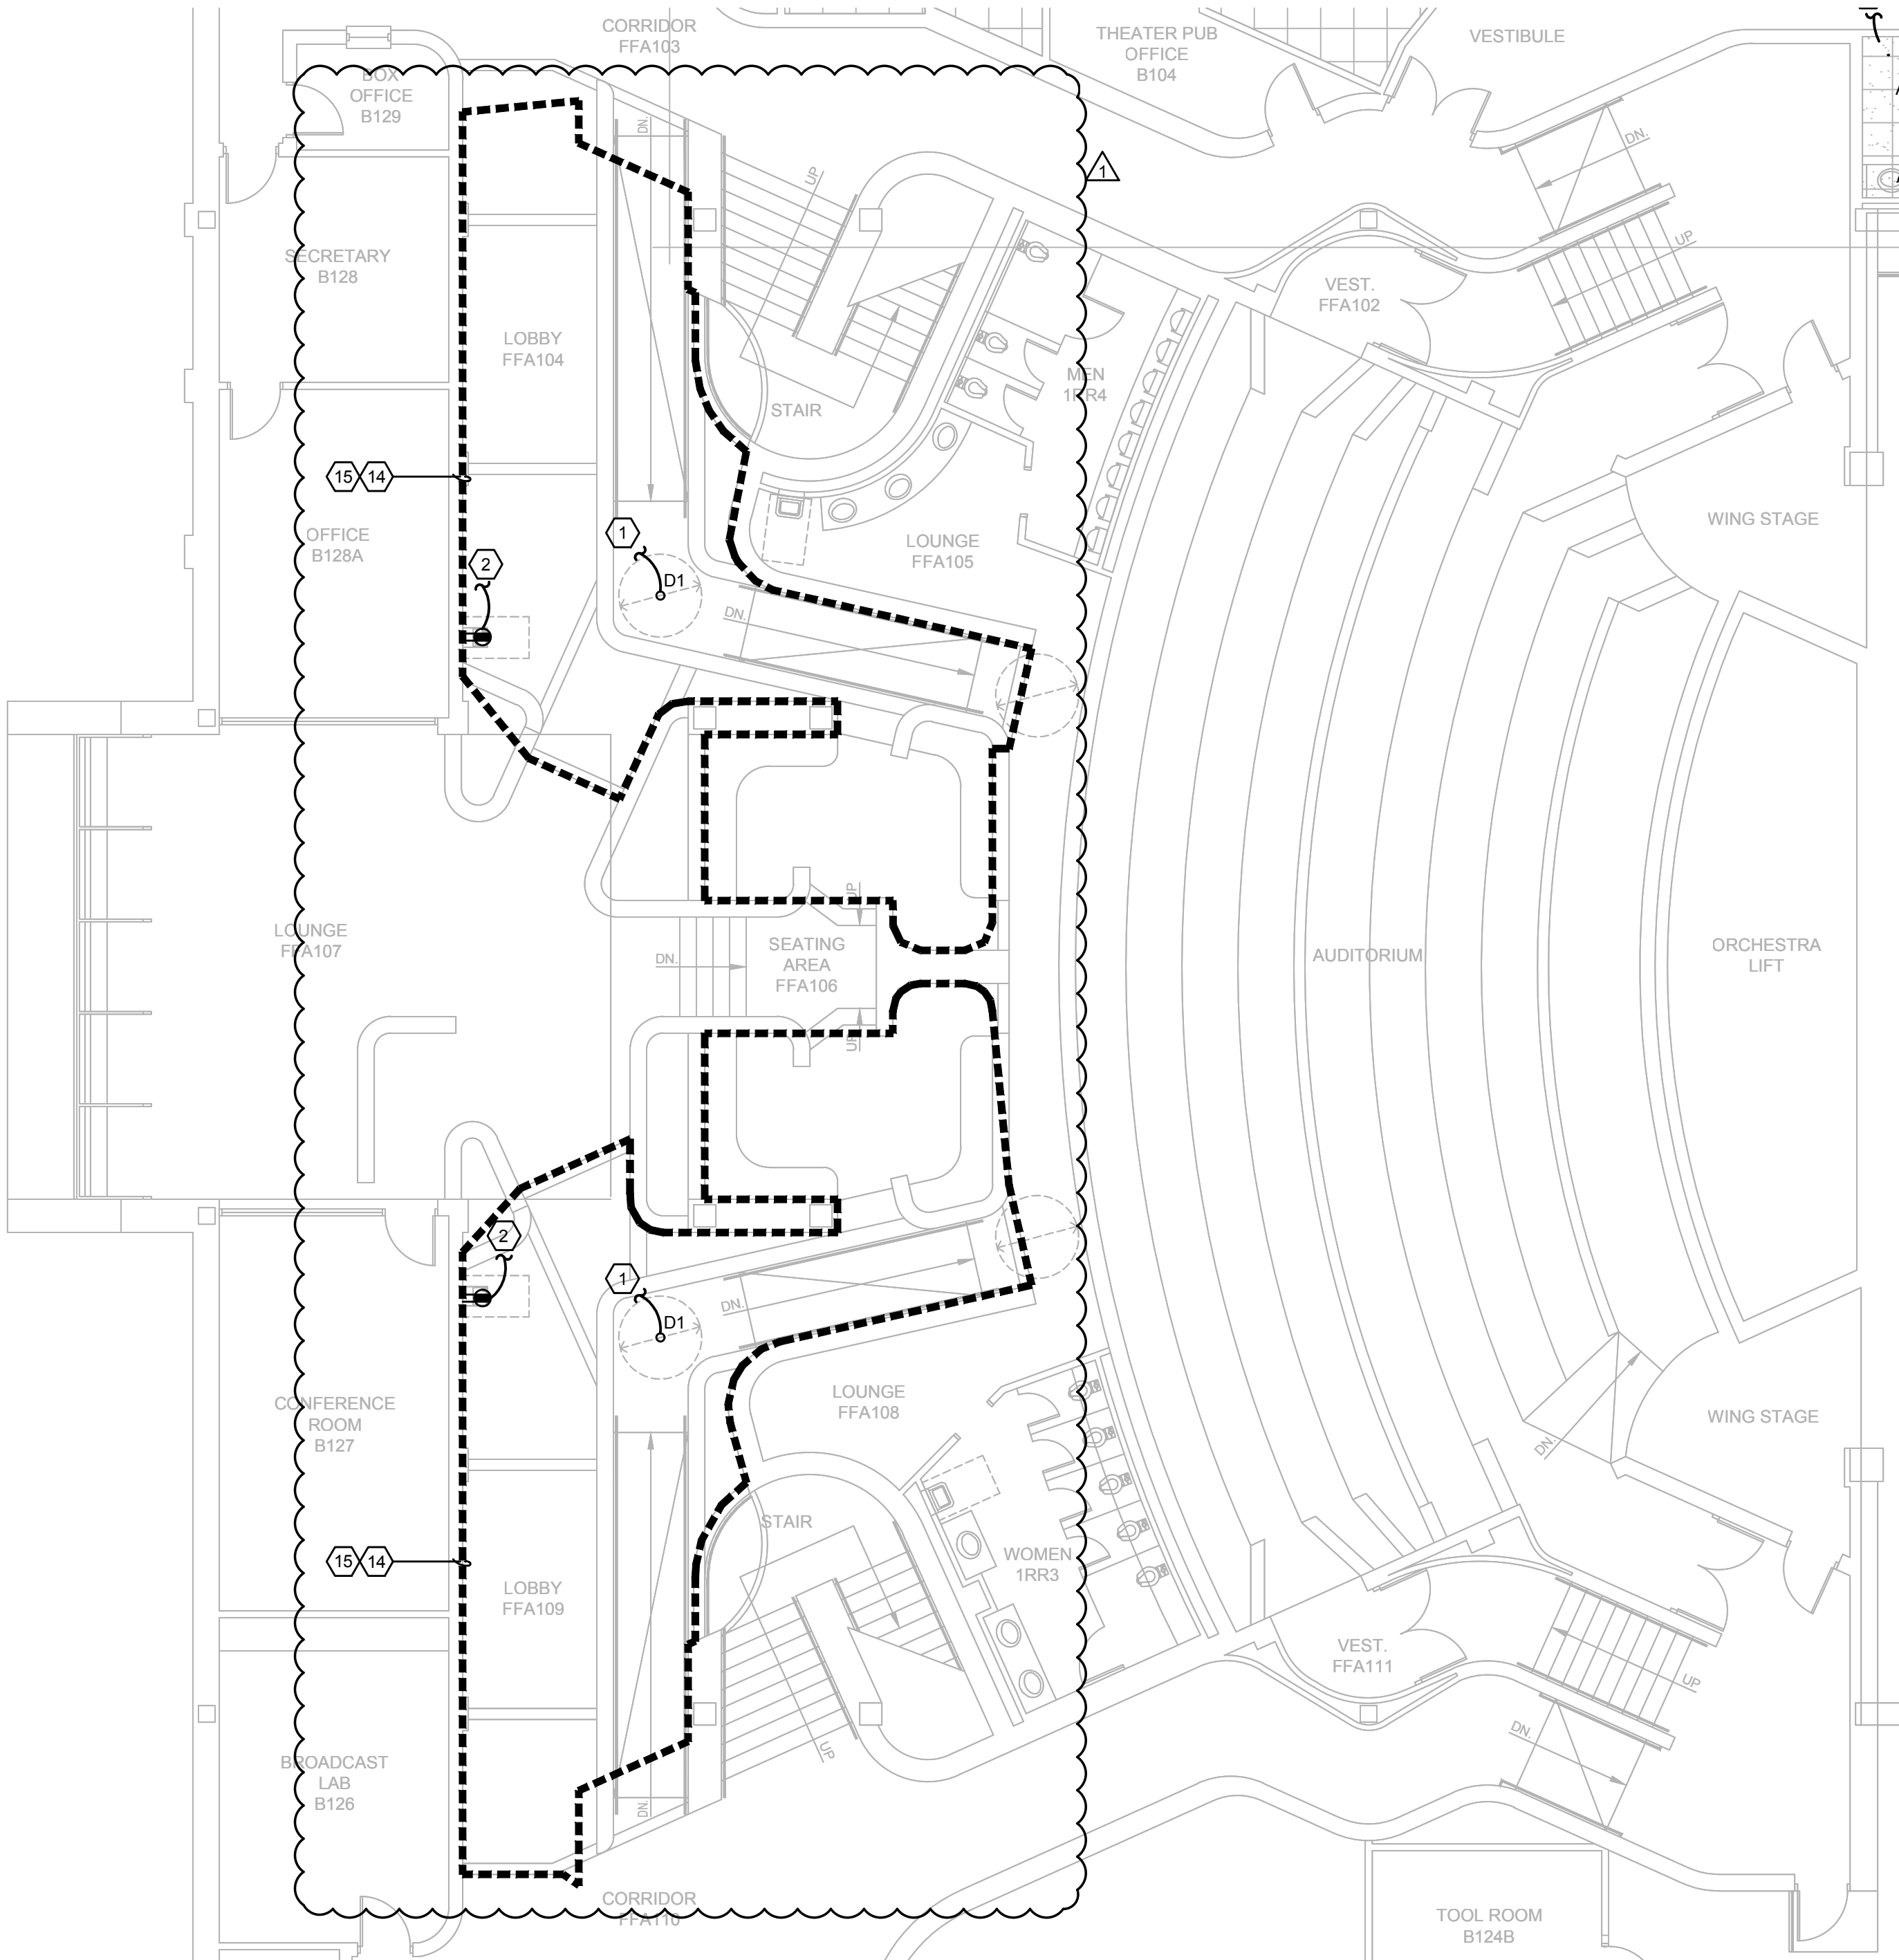


FAIN FINE ARTS - FIRST FLOOR - AREA 1D
ELECTRICAL PLAN
FF-E102 SCALE: 1/8" = 1'-0"

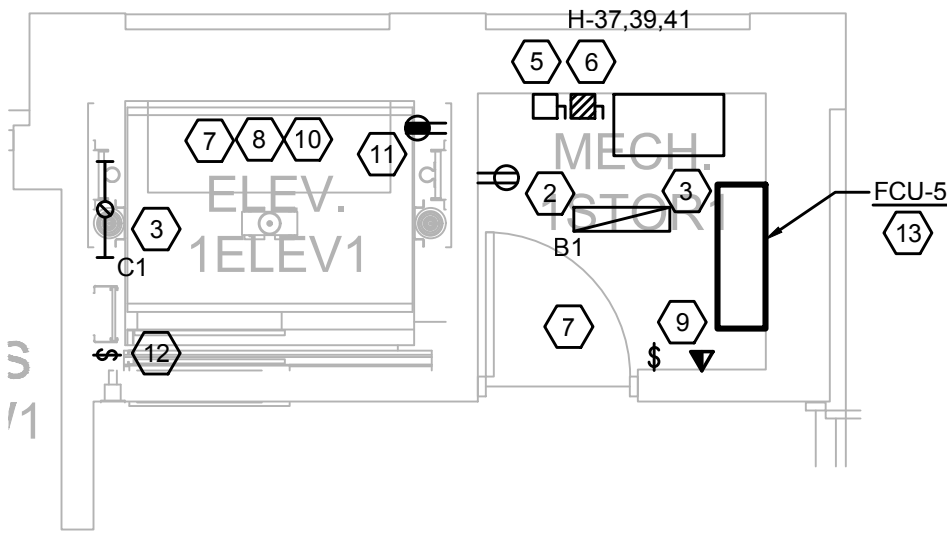

FAIN FINE ARTS - FIRST FLOOR
ELECTRICAL ELEVATOR PLAN
FF-E102 SCALE: 1/4" = 1'-0"

PANEL H (NEW)													S.C. RATING 22,000 AIC	
LOCATION: ELECTRICAL ROOM		480 YI		277 VOLT, 3 PHASE, 4 WIRE						400 AMP M.L.O.				
MOUNTING: SURFACE										400 AMP BUS				
FED FROM: PANEL HD										100% NEUTRAL BUS				
WIRE SIZE	CKT	DESCRIPTION	VA			PH			VA	DESCRIPTION	CKT	WIRE SIZE		
				A	P		P	A						
E	1	(EX) HW PUMP	10000	50	3	A	3	50	10000	(EX) ORCHESTRA ELEVATOR	2	E		
	3		10000						4					
	5		10000						6					
E	7	(EX) VENTILATING FAN	5000	30	3	A	3	25		(NEW) CU-3	8			
	9		5000								10			
	11		5000								12			
E	13	(EX) N. CONDENSATE PUMP	2500	20	3	B	3	20	2500	(EX) W. SUMP PUMP	14	E		
	15		2500						16					
	17		2500						18					
E	19	(EX) S. CONDENSATE PUMP	2500	20	3	A	3	20	2500	(EX) E. SUMP PUMP	20	E		
	21		2500						22					
	23		2500						24					
E	25	(EX) AIR COMPRESSOR	2500	20	3	A	1	20	2500	SPARE	26			
	27		2500						28					
	29		2500						30					
	31	(EX) STAGE BSMT. LTS	1000	20	1	A	1	20		SPARE	32			
	33	(EX) MECH RM LTS.	1000	20	1	B	1			SPACE ONLY	34			
	35	SPARE		20	1	C	1			SPACE ONLY	36			
	37	(NEW) ELEVATOR	10000	60	3	A	3	125	25000	(EX) CHW PUMP	38	E		
	39		10000						25000		40			
	41		10000						25000		42			
	43	SPACE ONLY			1	A	1			SPACE ONLY	44			
	45	SPACE ONLY			1	B	1			SPACE ONLY	46			
	47	SPACE ONLY			1	C	1			SPACE ONLY	48			
	49	SPACE ONLY			1	A	1			SPACE ONLY	50			
	51	SPACE ONLY			1	B	1			SPACE ONLY	52			
	53	SPACE ONLY			1	C	1			SPACE ONLY	54			
	55	SPACE ONLY			1	A	1			SPACE ONLY	56			
	57	SPACE ONLY			1	B	1			SPACE ONLY	58			
	59	SPACE ONLY			1	C	1			SPACE ONLY	60			

LIGHT FIXTURE SCHEDULE										
TYPE	DESCRIPTION	LAMP			MOUNTING	ELECTRICAL		MANUFACTURER	CATALOG NUMBER	NOTES
		TYPE	COLOR TEMP	CRI		VOLTS	VA			
A1	2X2 LENSED TROFFER	FLUORESCENT	4000K	85	RECESSED GRID	UNV	35	HEW	50G-S22-2-17-F-AF12125-UNV	
B1	1X4 SURFACE MOUNTED WRAP AROUND	FLUORESCENT	4000K	85	SURFACE	UNV	85	HEW	21-4-232-1-EB2-UNV	
C1	ELEVATOR PIT LIGHT	FLUORESCENT	4000K	85	SURFACE	UNV	65	HEW	93-4-232-A-EB2	3
D1	DOWNLIGHT	LED	4000K	85	RECESSED	UNV	25	HEW		4
X1	STANDARD LED EXIT SIGN	LED	N/A	N/A	SURFACE	UNV	10	HEW	EXIT-R-EM-WHT-SDT	1,2
E1	INTERIOR EMERGENCY WALL PACK	LED	N/A	N/A	SURFACE	UNV	10	HEW	EMER/LED-WHT-SDT	
F1	EXTERIOR WALL MOUNTED LIGHT	LED	6350K	N/A	WALL ABOVE DOOR	UNV	2.78	HEW	PGP-HTR	5
NOTES:										
1. VERIFY MOUNTING, NUMBER OF FACES AND ARROW CONFIGURATION WITH PLANS PRIOR TO ORDERING FIXTURES.										
2. VERIFY MOUNTING HEIGHT AND ORIENTATION WITH ARCHITECTURAL DRAWINGS PRIOR TO ROUGH-IN.										
3. WALL MOUNT IN ELEVATOR PIT.										
4. FIELD COORDINATE MOUNTING OF DOWNLIGHT WITH ARCHITECT PRIOR TO ROUGH-IN.										
5. PROVIDE FIXTURE WITH LOW TEMPERATURE EMERGENCY BALLAST AND INTEGRAL PHOTOCCELL FOR ON/OFF CONTROL.										

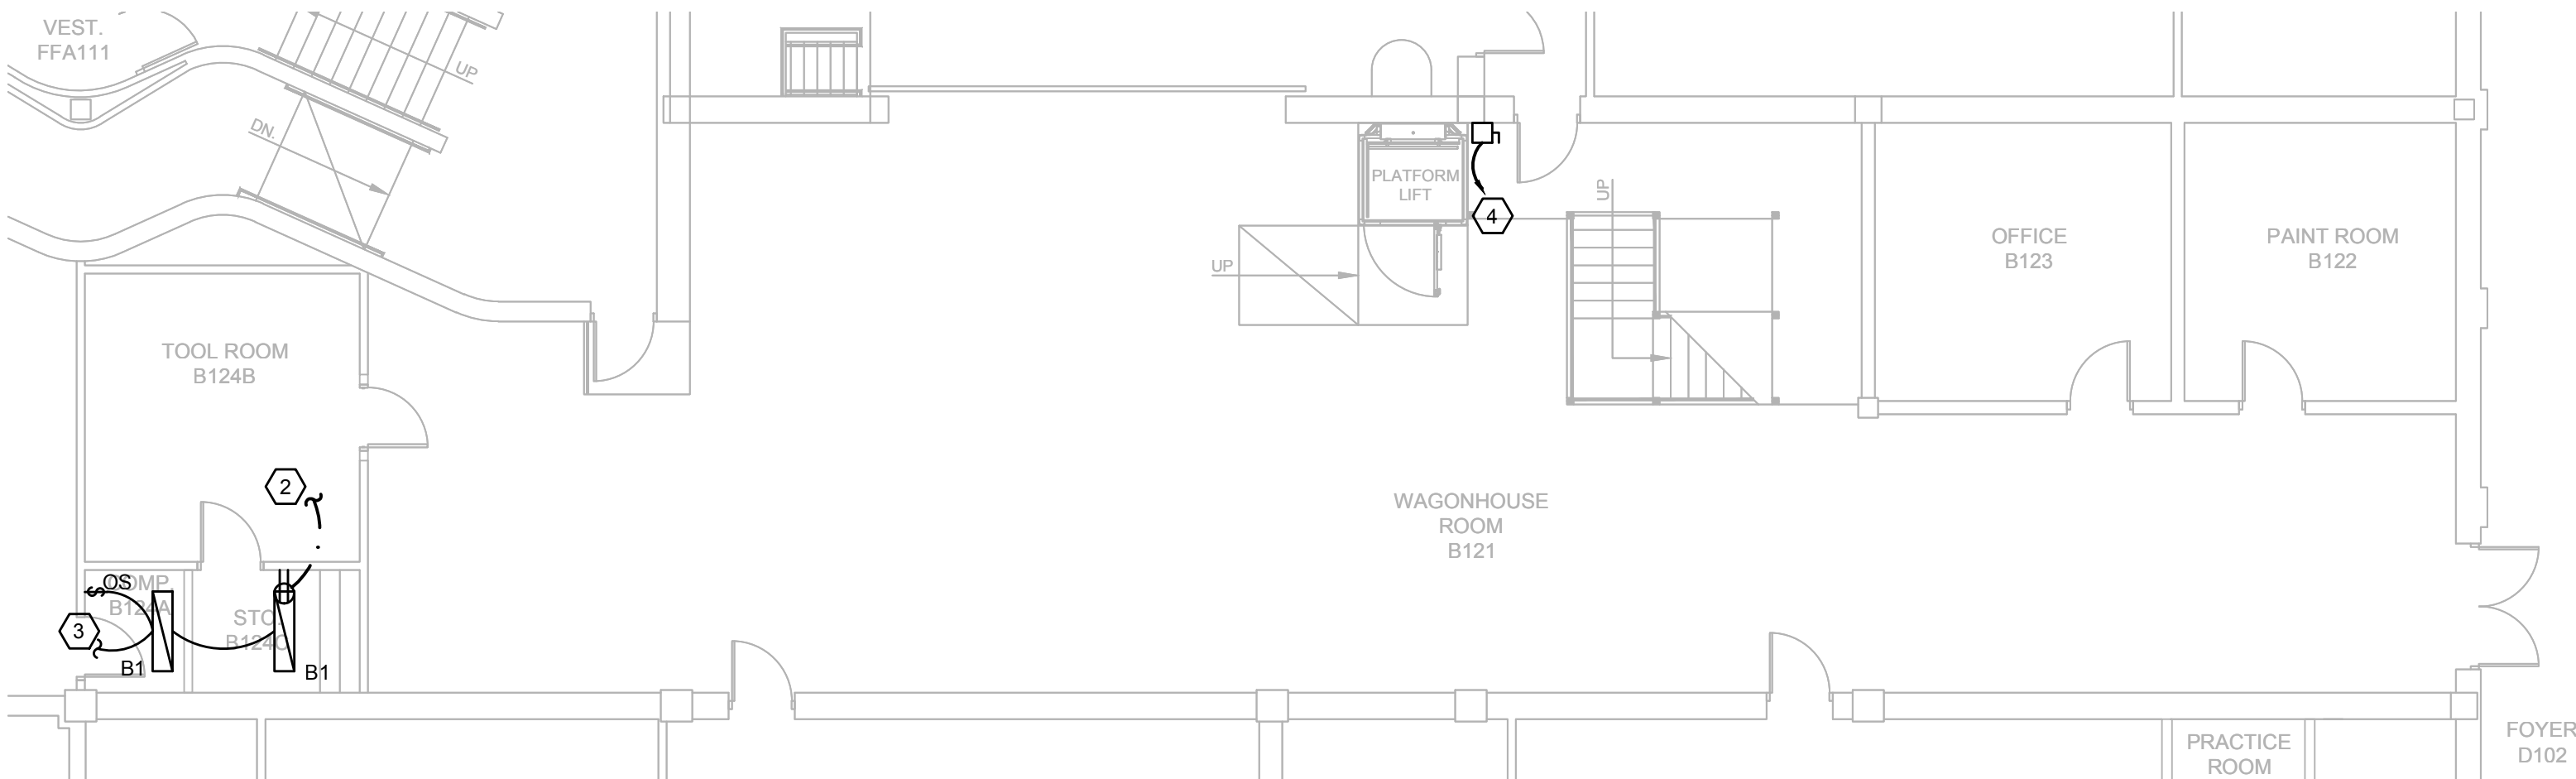


FAIN FINE ARTS - FIRST FLOOR - AREA 1C
ELECTRICAL PLAN
FF-E102 SCALE: 1/8" = 1'-0"

GENERAL NOTES

1. REFER TO ARCHITECTURAL OVERALL FLOOR PLANS FOR LOCATIONS SCOPE OF WORK AREAS WITHIN THE BUILDING.

KEY NOTES

1. MOUNT NEW RECESSED CAN LIGHT UNDERNEATH STAIR LANDING. CONNECT NEW LIGHTS TO EXISTING LIGHTING CIRCUIT AND LOCAL LIGHTING CONTROLS SERVING THIS AREA.
2. CONNECT NEW RECEPTACLE TO NEAREST EXISTING 120V RECEPTACLE CIRCUIT (16A LOAD MAX. PER 20A CIRCUIT).
3. CONNECT NEW LIGHTS TO EXISTING LIGHTING CIRCUIT SERVING THIS AREA (16A LOAD MAX. PER 20A CIRCUIT).
4. USE CIRCUIT LB7-104. PROVIDE 20A/1P CIRCUIT BREAKER TO SERVE VERTICAL PLATFORM LIFT. FIELD COORDINATE ALL CONNECTION REQUIREMENTS PRIOR TO ROUGH-IN. PROVIDE ALL REQUIRED INTERCONNECTIONS BETWEEN LIFT POWER SUPPLY AND LIFT CONTROL PANEL. VERIFY WITH EQUIPMENT VENDOR THAT AN OPTIONAL DISCONNECTING MEANS IS INCLUDED WITH THE PLATFORM LIFT. OTHERWISE PROVIDE WITH AND LOCATE NEAR THE EQUIPMENT.
5. ELEVATOR CAB LIGHT DISCONNECT 20A, 1P, 120V. CIRCUIT BREAKERS MOUNTED IN NEMA-1 ENCLOSURE WITH HANDLE PADLOCK ATTACHMENT CAPABLE OF LOCKING BREAKER IN OPEN POSITION. USE CIRCUIT LB7-110. PROVIDE 20A/1P CB AND 2/12, 1#12G, 3/4"C.
6. 60A, 3 POLE, 480V, NEMA-1 ENCLOSURE FUSED AT (60 AMPS). ALL IN ONE ELEVATOR DISCONNECT SWITCH WITH BUILT IN SHUNT TRIP BY BUSSMANN. ROUTE TO NEW 60A/3P CIRCUIT BREAKER IN NEW PANEL "H".
7. COORDINATE LOCATIONS OF ALL EQUIPMENT IN ELEVATOR EQUIPMENT ROOM WITH ELEVATOR SHOP DRAWINGS PRIOR TO ROUGH-IN.
8. CONNECT EMERGENCY SHUT-DOWN OF ELEVATOR AS REQUIRED. SEQUENCE EQUIPMENT TO SHUT-DOWN THE ELEVATOR BY SMOKE DETECTORS WHEN REQUIRED.
9. TELEPHONE FOR ELEVATOR CAB. CONNECT AS REQUIRED.
10. CONTRACTOR SHALL REFERENCE ELEVATOR SPECIFICATIONS. COORDINATE ALL ELECTRICAL REQUIREMENTS WITH ELEVATOR MANUFACTURER PRIOR TO ROUGH-IN. FAILURE TO COORDINATE REQUIREMENTS WILL NOT RESULT IN ADDITIONAL COMPENSATION BEING PROVIDED TO THE CONTRACTOR.
11. PROVIDE WP/GFI RECEPTACLE LOCATED IN ELEVATOR PIT, FOR CONNECTION OF ELEVATOR PIT SUMP PUMP (SP-1). USE CIRCUIT LB7-106, WITH 2#10, #10G, 3/4"C, PROVIDE 20A/1P CB AT PANEL.
12. MOUNT LIGHT SWITCH FOR PIT LIGHTS NEXT TO LADDER INTO PIT.
13. FCU, 208V, 1-PH, 0.2A. USE CIRCUIT LB7-99/101, PROVIDE 20A/2P BREAKER IN PANEL AND ROUTE 2#12, #12G, 3/4" CONDUIT FROM BREAKER TO UNIT. COORDINATE WITH EQUIPMENT INSTALLER FOR LOCATIONS AND REQUIREMENTS.
14. INSTALL NEW RECEPTACLES ALONG NEW WALLS. REFER TO FF-ED102. THE QUANTITY OF THE NEW RECEPTACLES TO BE INSTALLED SHALL BE EQUAL TO THE QUANTITY THAT WAS REMOVED. LOCATE THE NEW RECEPTACLES ON THE NEW WALLS AS CLOSE AS POSSIBLE TO THE ORIGINAL LOCATION, FACING THE SAME ORIENTATION, AND TO BE MOUNTED AT 18" AFF AND/OR RAMP. REUSE EXISTING CIRCUIT EXTENDED TO NEW LOCATION.
15. COORDINATE WITH ARCHITECT AND GENERAL CONTRACTOR FOR ANY ADJUSTMENT AND RELOCATION OF LIGHTING FIXTURES IN THIS AREA.

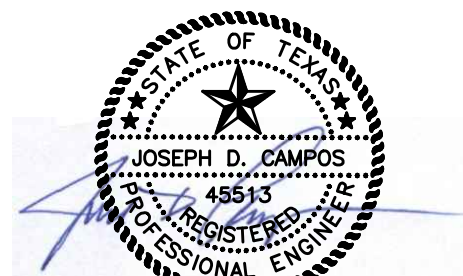

08/10/2017

DATE SIGNED:

HPA
HARPER PERKINS ARCHITECTS, INC.
4724 OLD JACKSBORO HIGHWAY
WICHITA FALLS, TEXAS 76302-3599
VOICE: 840.767.1421 FAX: 840.397.0273
E-MAIL: office@harperperkins.com WEB: www.harperperkins.com

CAMPUS ENGINEERING, Inc.
Consulting Engineers
1331 River Bend Drive
Dallas, Texas 75247
(214) 696-6291
campus@campusengineering.com
Registration No. F-001731
CEI Project Number D17-1263.00

TASADA - FIRE MARSHAL DEFERRED MAINTENANCE PROJECTS FOR
MIDWESTERN STATE UNIVERSITY
3410 TAFT BOULEVARD
WICHITA FALLS, TEXAS





DRAWN BY:		
DATE: 15 MAY 2017		
REVISIONS		
NO.	DESCRIPTION	DATE
1	ADDENDUM 2	08/10/17

16782.00


© 2017 HARPER PERKINS ARCHITECTS

FF-E102

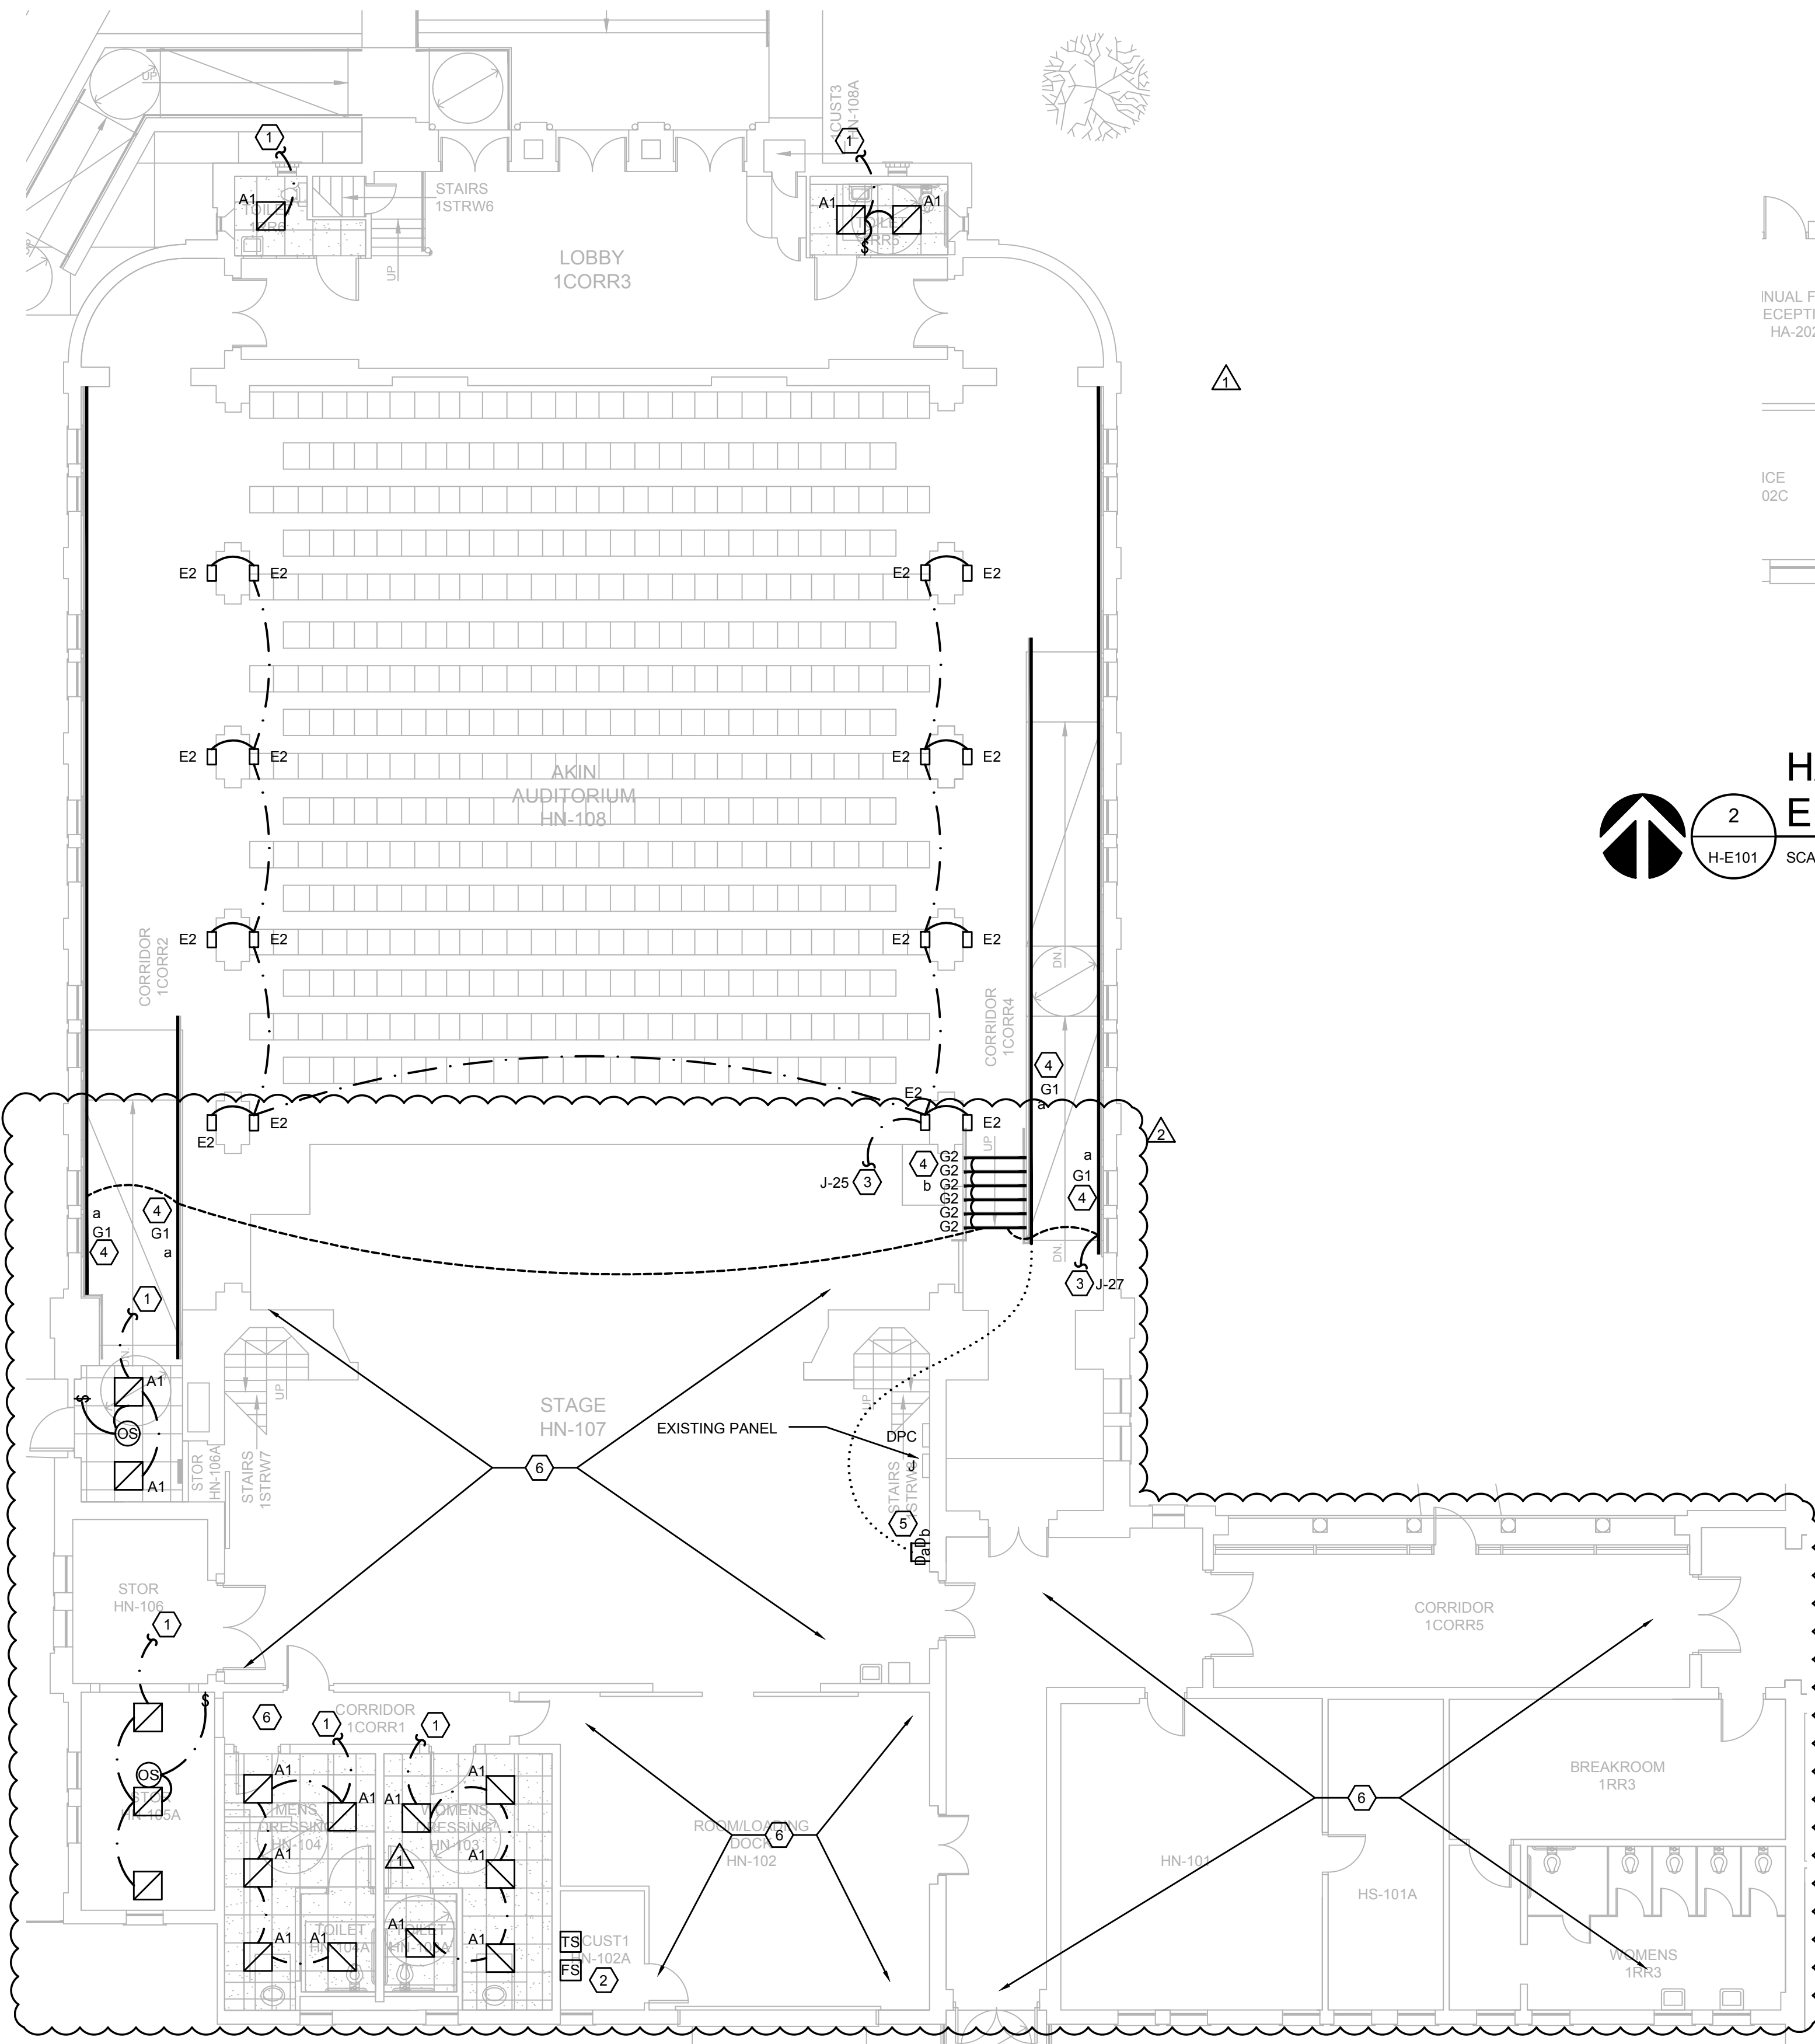

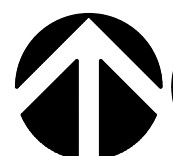
 **1**
H-E101 SCALE: 1/8" = 1'-0"

**HARDIN ADMIN BUILDING - FIRST FLOOR - AREA 1B & 1A
ELECTRICAL PLAN**

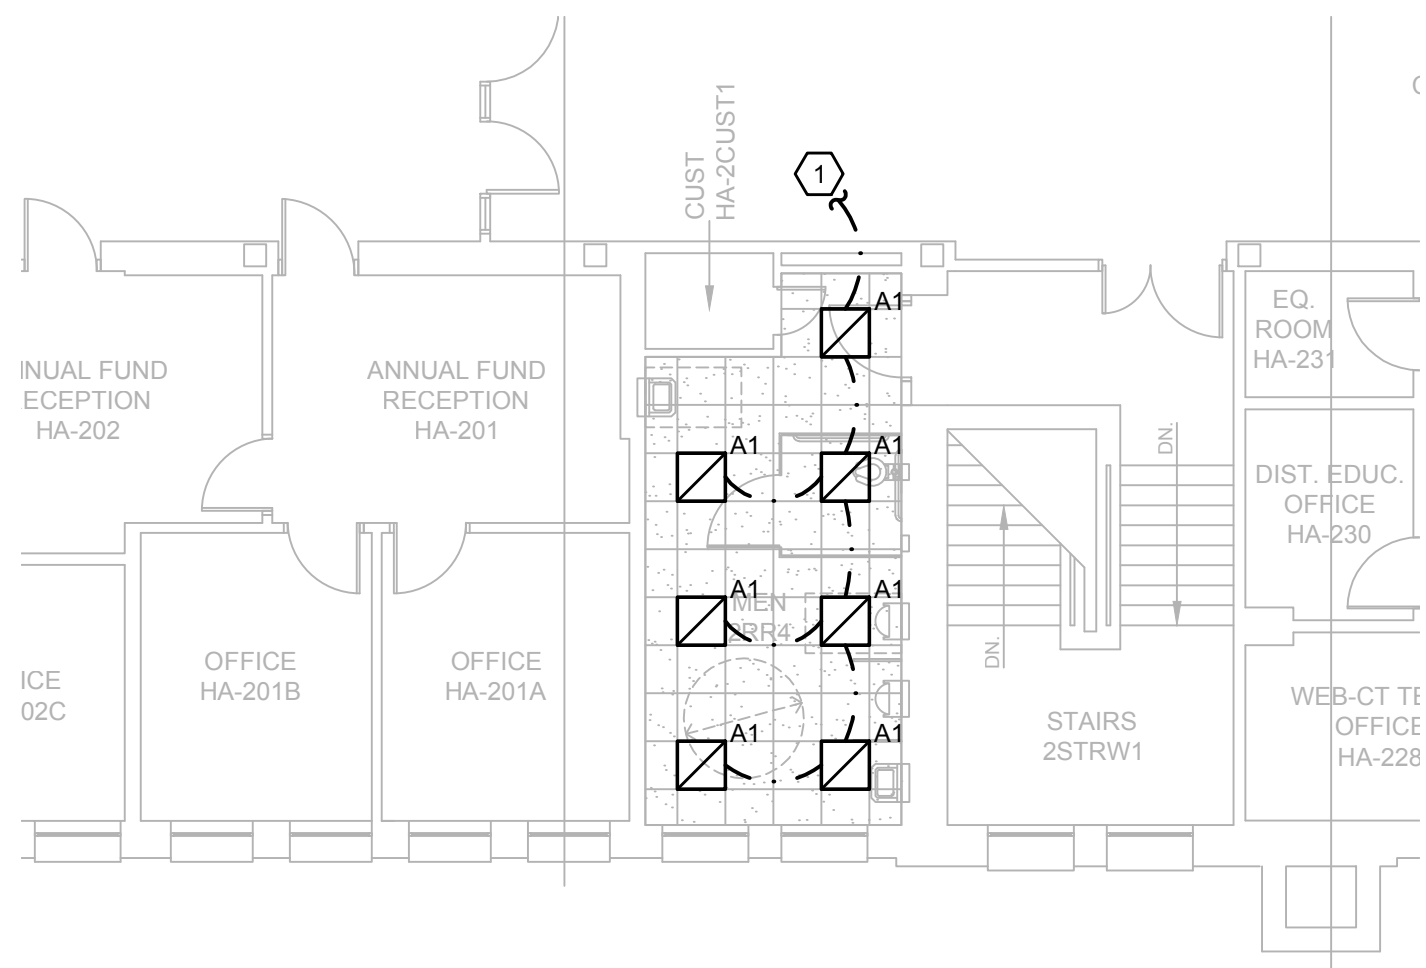

 **2**
H-E101 SCALE: 1/8" = 1'-0"

**HARDIN ADMIN BUILDING - SECOND FLOOR - AREA 2B
ELECTRICAL PLAN**

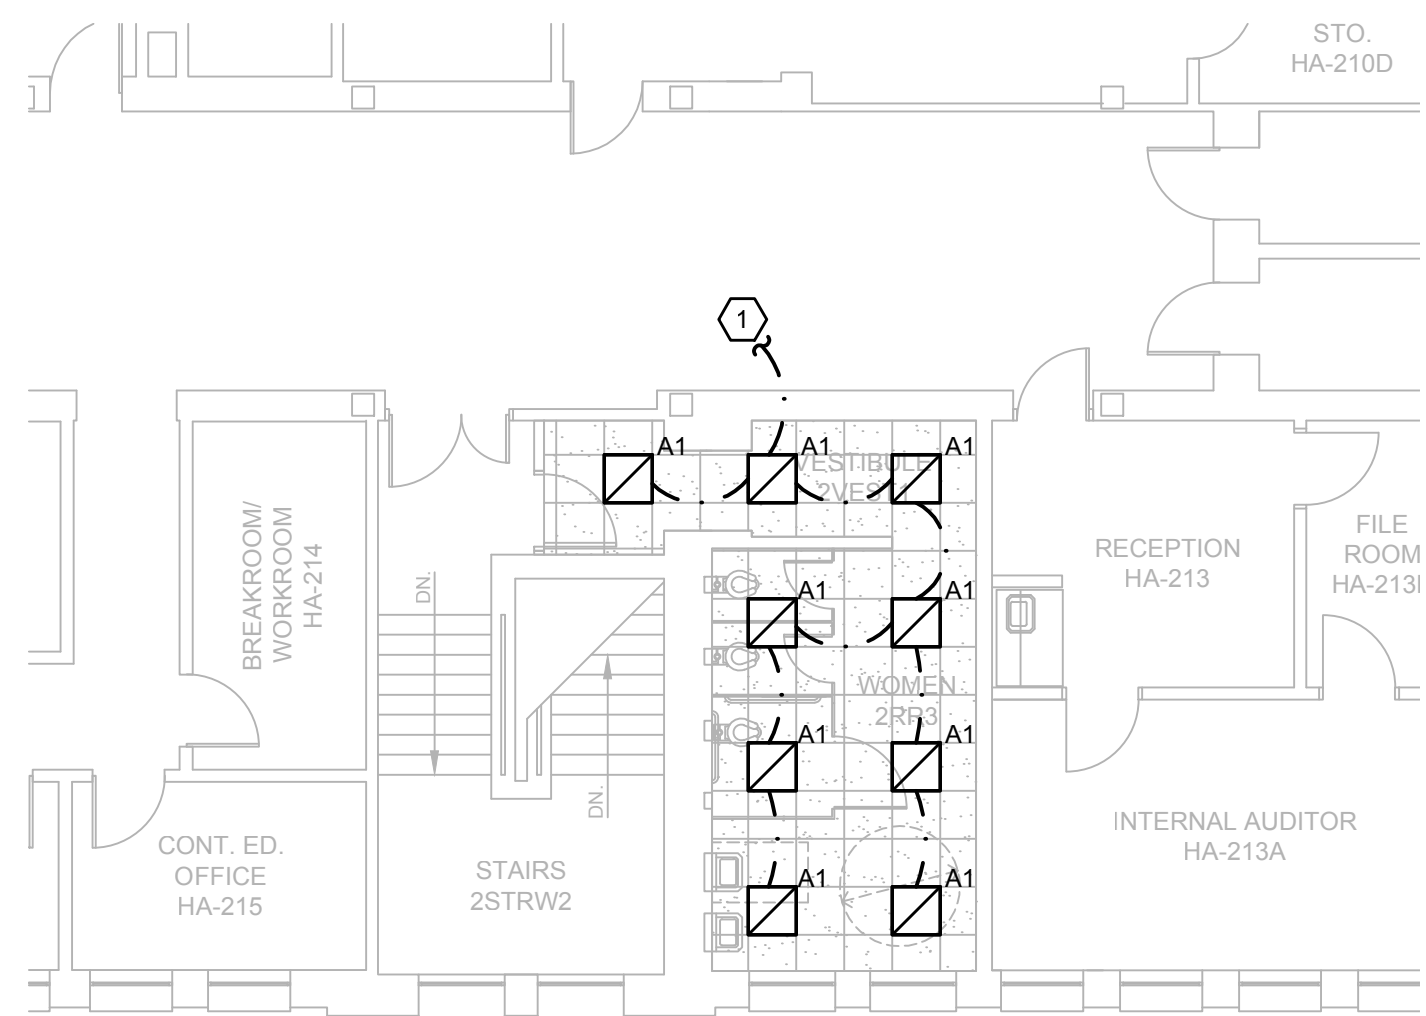

 **4**
H-E101 SCALE: 1/8" = 1'-0"

**HARDIN ADMIN BUILDING - SECOND FLOOR - AREA 2C
ELECTRICAL PLAN**

LIGHT FIXTURE SCHEDULE										
TYPE	DESCRIPTION	TYPE	LAMP COLOR TEMP	CRI	MOUNTING	ELECTRICAL		MANUFACTURER	CATALOG NUMBER	NOTES
						VOLTS	VA			
A1	2X2 LENSED TROFFER	FLUORESCENT	4000K	85	RECESSED GRID	UNV	35	HEW	50G-S22-2-17-F-AF12125-UNV	
G1	LED PATHWAY, AISLE LIGHTING	LED	N/A	N/A	FLOOR	12V	1.8/FT	CALIFORNIA ACCENT LTG. INC.	AIL1800-4"-LED-_-SLC	PROVIDE DIMMABLE DRIVER, 120V
G2	CARPETED STEP LIGHT	LED	N/A	N/A	FLOOR	12V	1.8/FT	CALIFORNIA ACCENT LTG. INC.	STL6125-4-LED-_-SL	PROVIDE DIMMABLE DRIVER, 120V
E2	EMERGENCY LED SCONCE	LED	6350K	N/A	WALL	120V	2.78	DUAL LITE	PGZ	NORMAL OFF, EMERGENCY ON
GENERAL NOTES: 1. FOR EXT LIGHTS, VERIFY MOUNTING, NUMBER OF FACES AND ARROW CONFIGURATION WITH PLANS PRIOR TO ORDERING FIXTURES. 2. VERIFY MOUNTING HEIGHT AND ORIENTATION WITH ARCHITECTURAL DRAWINGS PRIOR TO ROUGH-IN. 3. COORDINATE AND VERIFY FIXTURE/LAMP COLOR AND FINISH WITH ARCHITECT. 4. COORDINATE EXACT LOCATION AND REQUIREMENTS WITH ARCHITECT PRIOR TO ROUGH-IN 5. PROVIDE LIGHTING FIXTURE/ASSEMBLY COMPLETE WITH HARDWARE, CONNECTORS, DRIVERS, ETC. NECESSARY FOR A SATISFACTORY AND WORKABLE INSTALLATION. 6. INSTALL PER MANUFACTURER'S RECOMMENDATION.										

- ### GENERAL NOTES

 - REFER TO ARCHITECTURAL OVERALL FLOOR PLANS FOR LOCATIONS SCOPE OF WORK AREAS WITHIN THE BUILDING.
 - EMERGENCY AND EXIT LIGHTS SHALL BE CIRCUITED AHEAD OF ANY SWITCHING DEVICE.
- ### KEY NOTES #

 - CONNECT NEW LIGHTS TO EXISTING LIGHTING CIRCUIT SERVING THIS AREA.
 - NEW FIRE ALARM DEVICE. CONNECT TO EXISTING FIRE ALARM SYSTEM. VERIFY LOCATION WITH AHJ PRIOR TO INSTALLATION.
 - HOMERUN CIRCUIT TO PANEL "J", USE AVAILABLE SPACE.PROVIDE 20A/1P CIRCUIT BREAKER , USE 2#12, 1#12G, 3/4"C.
 - NEW DIMMABLE 0-10V LED AISLE AND STEP LIGHTING (TYPE G1 & G2) TO BE INSTALLED PER MANUFACTURER'S RECOMMENDATION, PROVIDE ALL NECESSARY MATERIALS FOR A COMPLETE OPERATING SYSTEM. COORDINATE WITH ARCHITECT FOR LOCATION AND DETAILS. AISLE LIGHTING G1 TO BE CONTROLLED BY DIMMER ZONE "a", STEP LIGHTING G2 TO BE CONTROLLED BY DIMMER ZONE "b".
 - PROVIDE TWO ZONE WALL DIMMING STATION COMPATIBLE WITH FIXTURES G1 AND G2. DIMMING WALL STATION TO BE EQUAL TO GANGED (TWO) NXSW-ORLO AND NX CONTROLLER NXRC-2RD-UNV. HUBBELL NX SERIES NETWORKED LIGHTING CONTROLS. REFER TO MANUFACTURER'S INSTALLATION INSTRUCTIONS FOR MORE DETAILS.
 - REMOVE ALL LIGHTS IN THIS AREA AND STORE THEM DURING CONSTRUCTION FOR RE-INSTALLATION AFTER THE SPRINKLER PIPING HAS BEEN INSTALLED. COORDINATE REMOVAL AND RE-INSTALLATION WITH FIRE PROTECTION CONTRACTOR. REFER TO SECTION 260112 "INTERDISCIPLINARY COORDINATION FOR CONNECTION AND RECONNECTION OF OTHER EQUIPMENT. MAKE NECESSARY ADJUSTMENT TO THE WIRING SUCH AS EXTENDING THE CIRCUIT AND ADDING WIRING DEVICES AS ROUTING MAY BE AFFECTED BY THE FIRE PROTECTION INSTALLATION.



DATE SIGNED:
HPA
ARCHITECTS PROGRAMMERS PLANNERS
HARPER PERKINS ARCHITECTS, INC.
4724 OLD JACKSBORO HIGHWAY
WICHITA FALLS, TEXAS 76302-3599
VOICE: 940.767.1421 FAX: 940.397.0273
E-MAIL: office@harperperkins.com WEB: www.harperperkins.com

CAMPOS ENGINEERING, Inc.
Consulting Engineers
CEI
1331 River Bend Drive
Dallas, Texas 75247
(214) 696-6291
campos@camposengineering.com
Registration No. F-001731
CEI Project Number D17-1263.00

TASADA - FIRE MARSHAL DEFERRED MAINTENANCE PROJECTS FOR
MIDWESTERN STATE UNIVERSITY
3410 TAFT BOULEVARD
WICHITA FALLS, TEXAS




DRAWN BY:
DATE: 15 MAY 2017


REVISIONS		
NO.	DESCRIPTION	DATE
Δ	ADDENDUM 1	08/02/17
Δ	ADDENDUM 2	08/10/17

16782.00
© 2017 HARPER PERKINS ARCHITECTS

H-E101

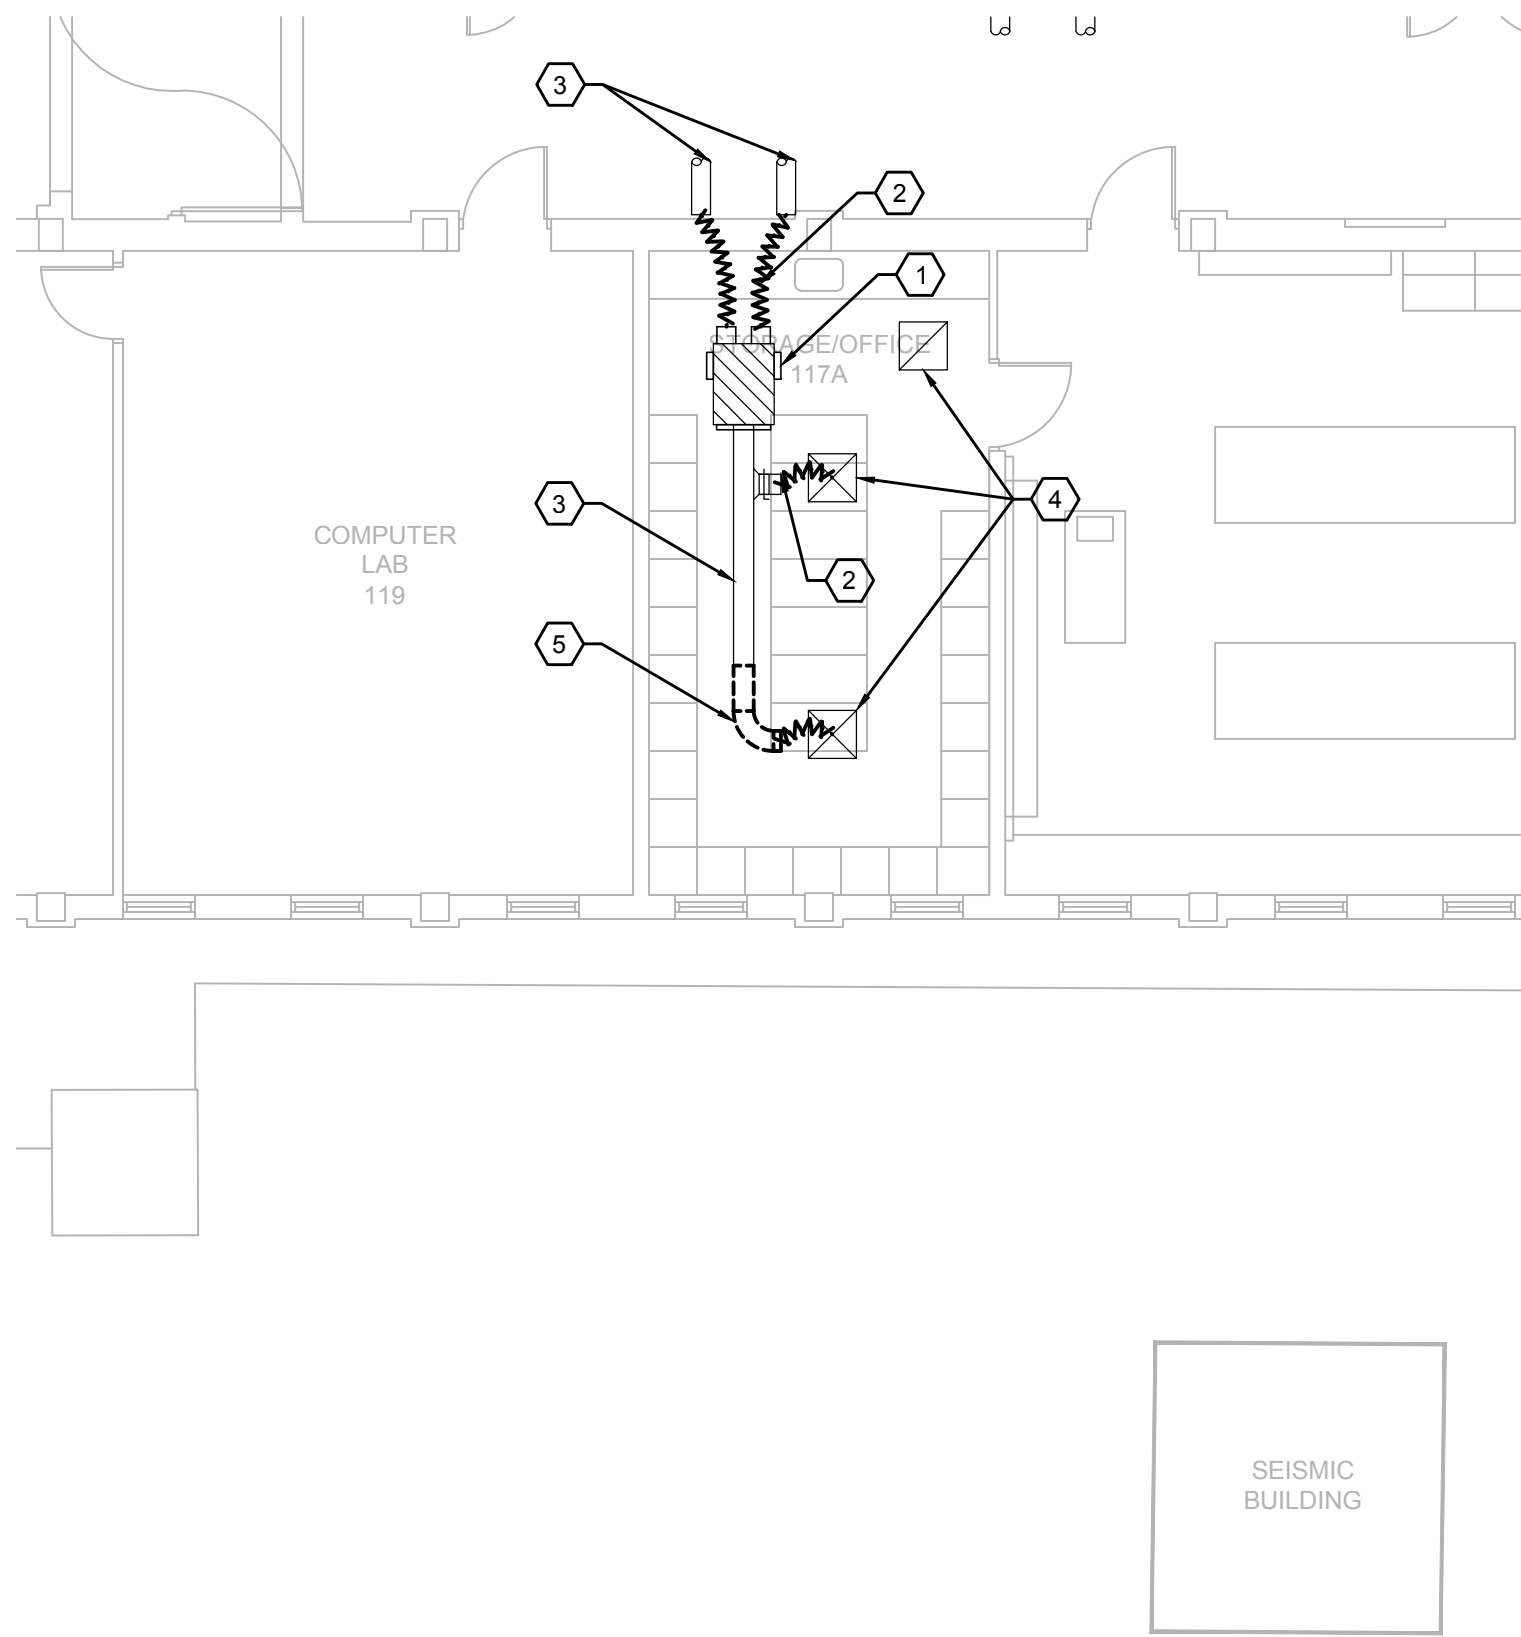


BOLIN SCIENCE HALL - FIRST FLOOR - AREA 1A
MECHANICAL DEMOLITION PLAN

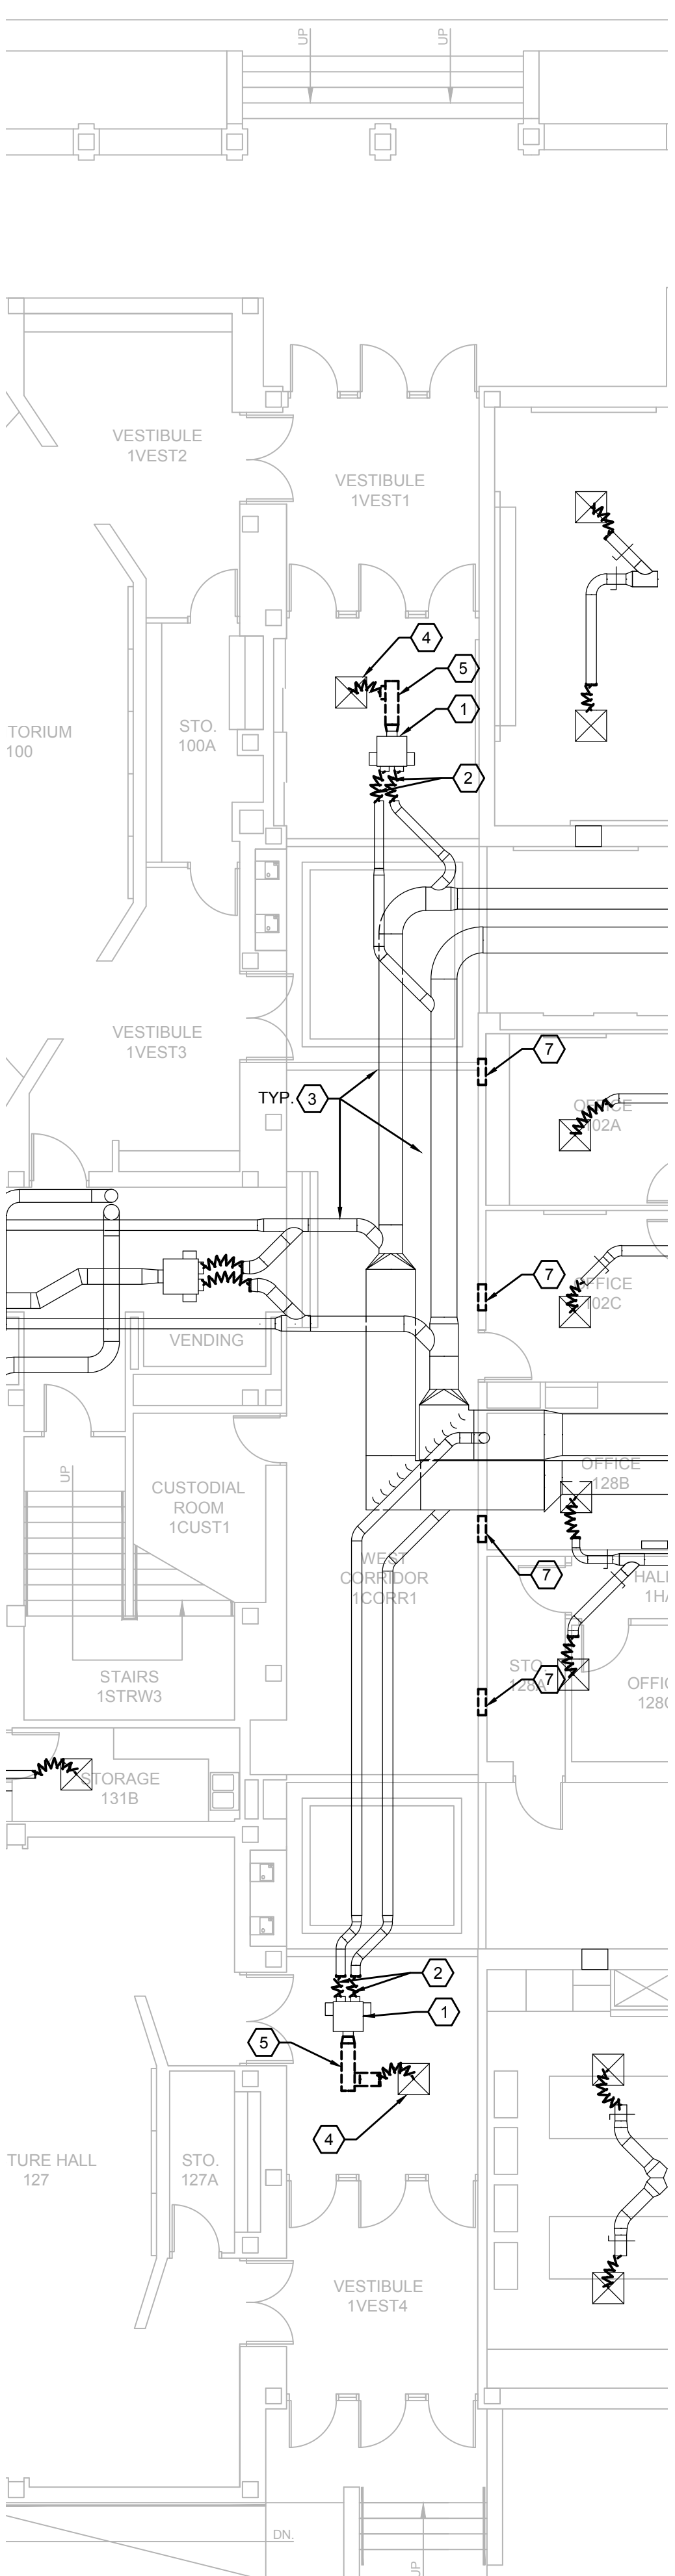


BOLIN SCIENCE HALL - FIRST FLOOR - AREA 1C
MECHANICAL DEMOLITION PLAN

- GENERAL NOTES**
(NOT ALL NOTES APPLY TO EACH SHEET)
- A. REFER TO SYMBOL LEGEND AND GENERAL NOTES.
 - B. REFER TO SPECIFICATIONS.
 - C. REFER TO ARCHITECTURAL OVERALL FLOOR PLANS FOR LOCATIONS SCOPE OF WORK AREAS WITHIN THE BUILDING.


- KEY NOTES** #
- (NOT ALL NOTES APPLY TO EACH SHEET)
- 1. EXISTING DUAL DUCT MIXING BOX TO REMAIN.
 - 2. REMOVE EXISTING FLEX DUCT.
 - 3. EXISTING DUCTWORK TO REMAIN.
 - 4. EXISTING SUPPLY DIFFUSER/RETURN GRILLE TO BE REMOVED AND REUSED UNLESS DAMAGED. IF DAMAGED REPLACE WITH DIFFUSER/GRILLE OF SAME SIZE, MANUFACTURER, MODEL AND COLOR.
 - 5. DEMOLISH EXISTING DUCTWORK TO THE EXTENT SHOWN IN PLANS.
 - 6. EXISTING FLOOR HATCH TO ACCESS THE CRAWLSPACE/BASEMENT AREA BELOW. DO NOT DEMOLISH THIS ACCESS DOOR.
 - 7. REMOVE AND DISPOSE OF EXISTING RETURN AIR TRANSFER DUCT AND GRILLE. CONTRACTOR SHALL INSPECT FULL WALL AND ADDRESS ANY ADDITIONAL TRANSFERS NOT SHOWN ON THIS PLAN. COORDINATE WITH SHEET B-M101 FOR TRANSFERS TO REMAIN.

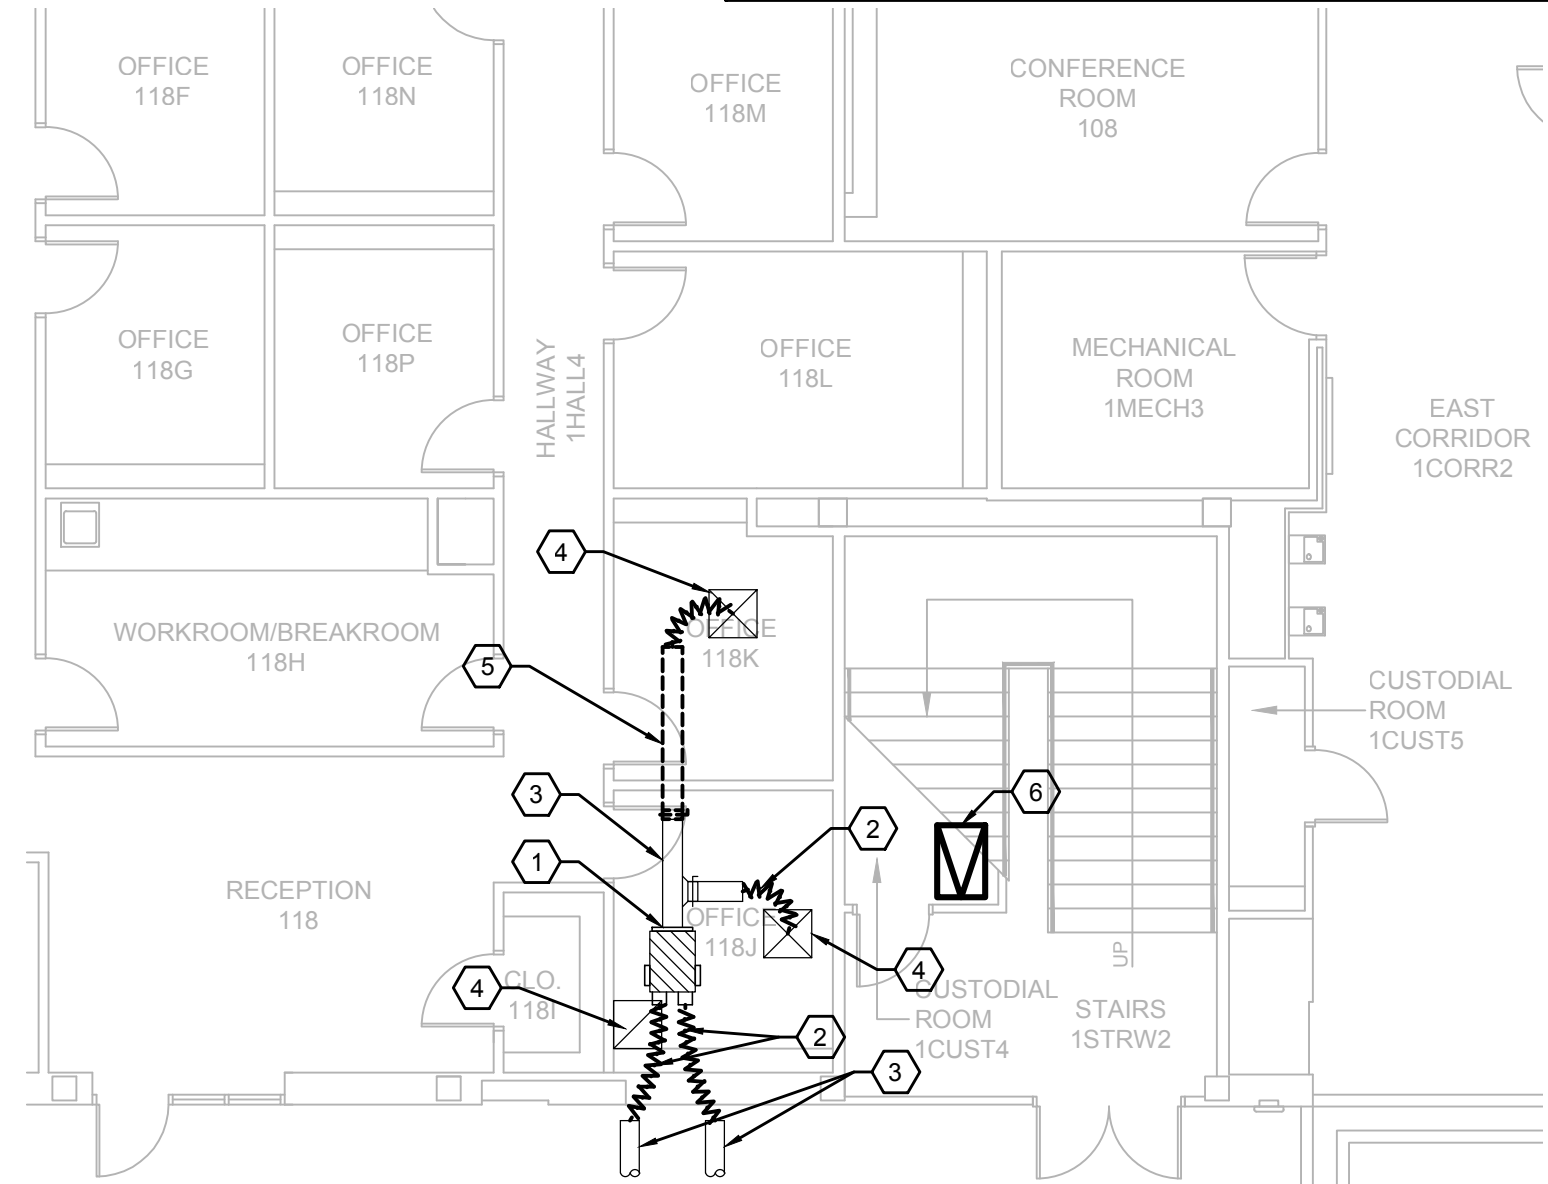

BOLIN SCIENCE HALL - FIRST FLOOR - AREA 1B
MECHANICAL DEMOLITION PLAN

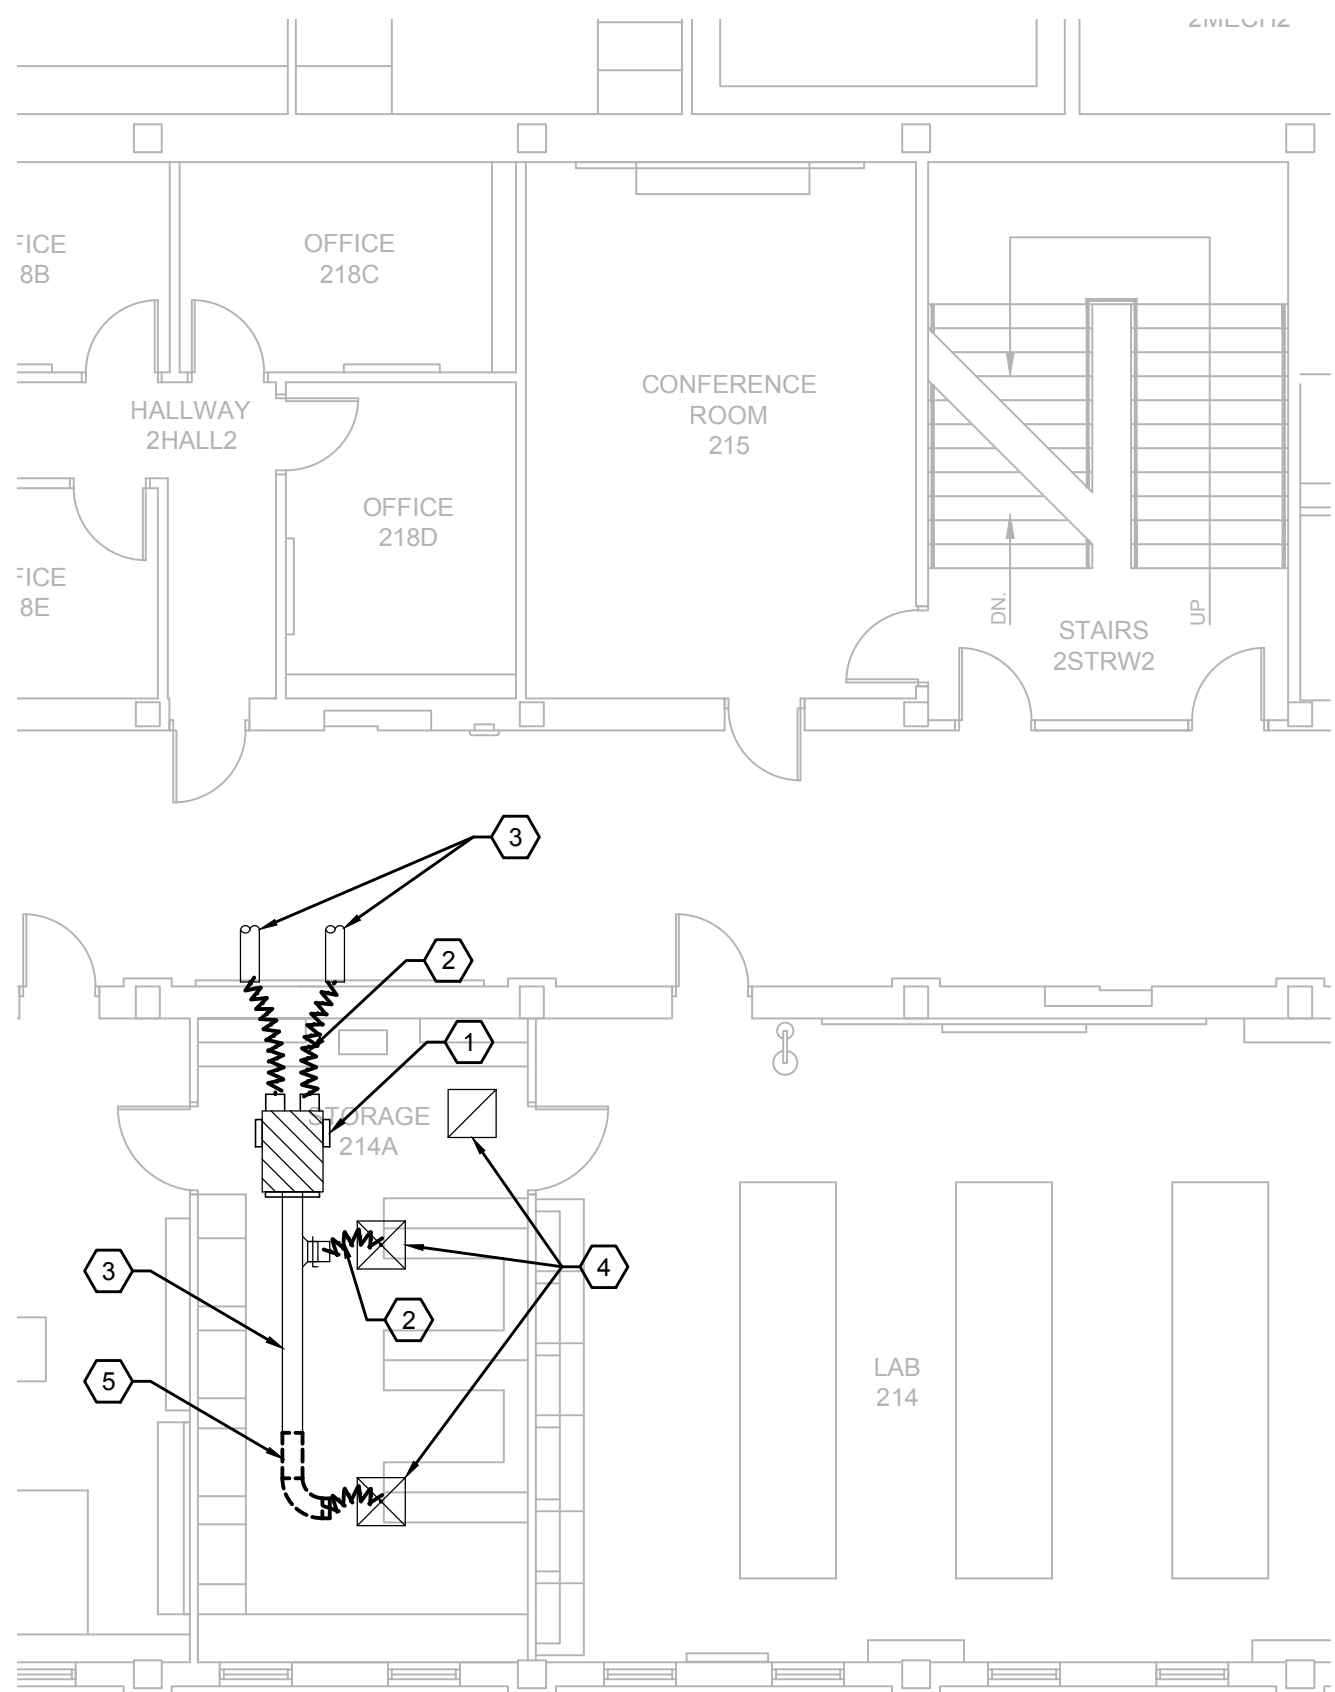

BOLIN SCIENCE HALL - SECOND FLOOR - AREA 2A
MECHANICAL DEMOLITION PLAN

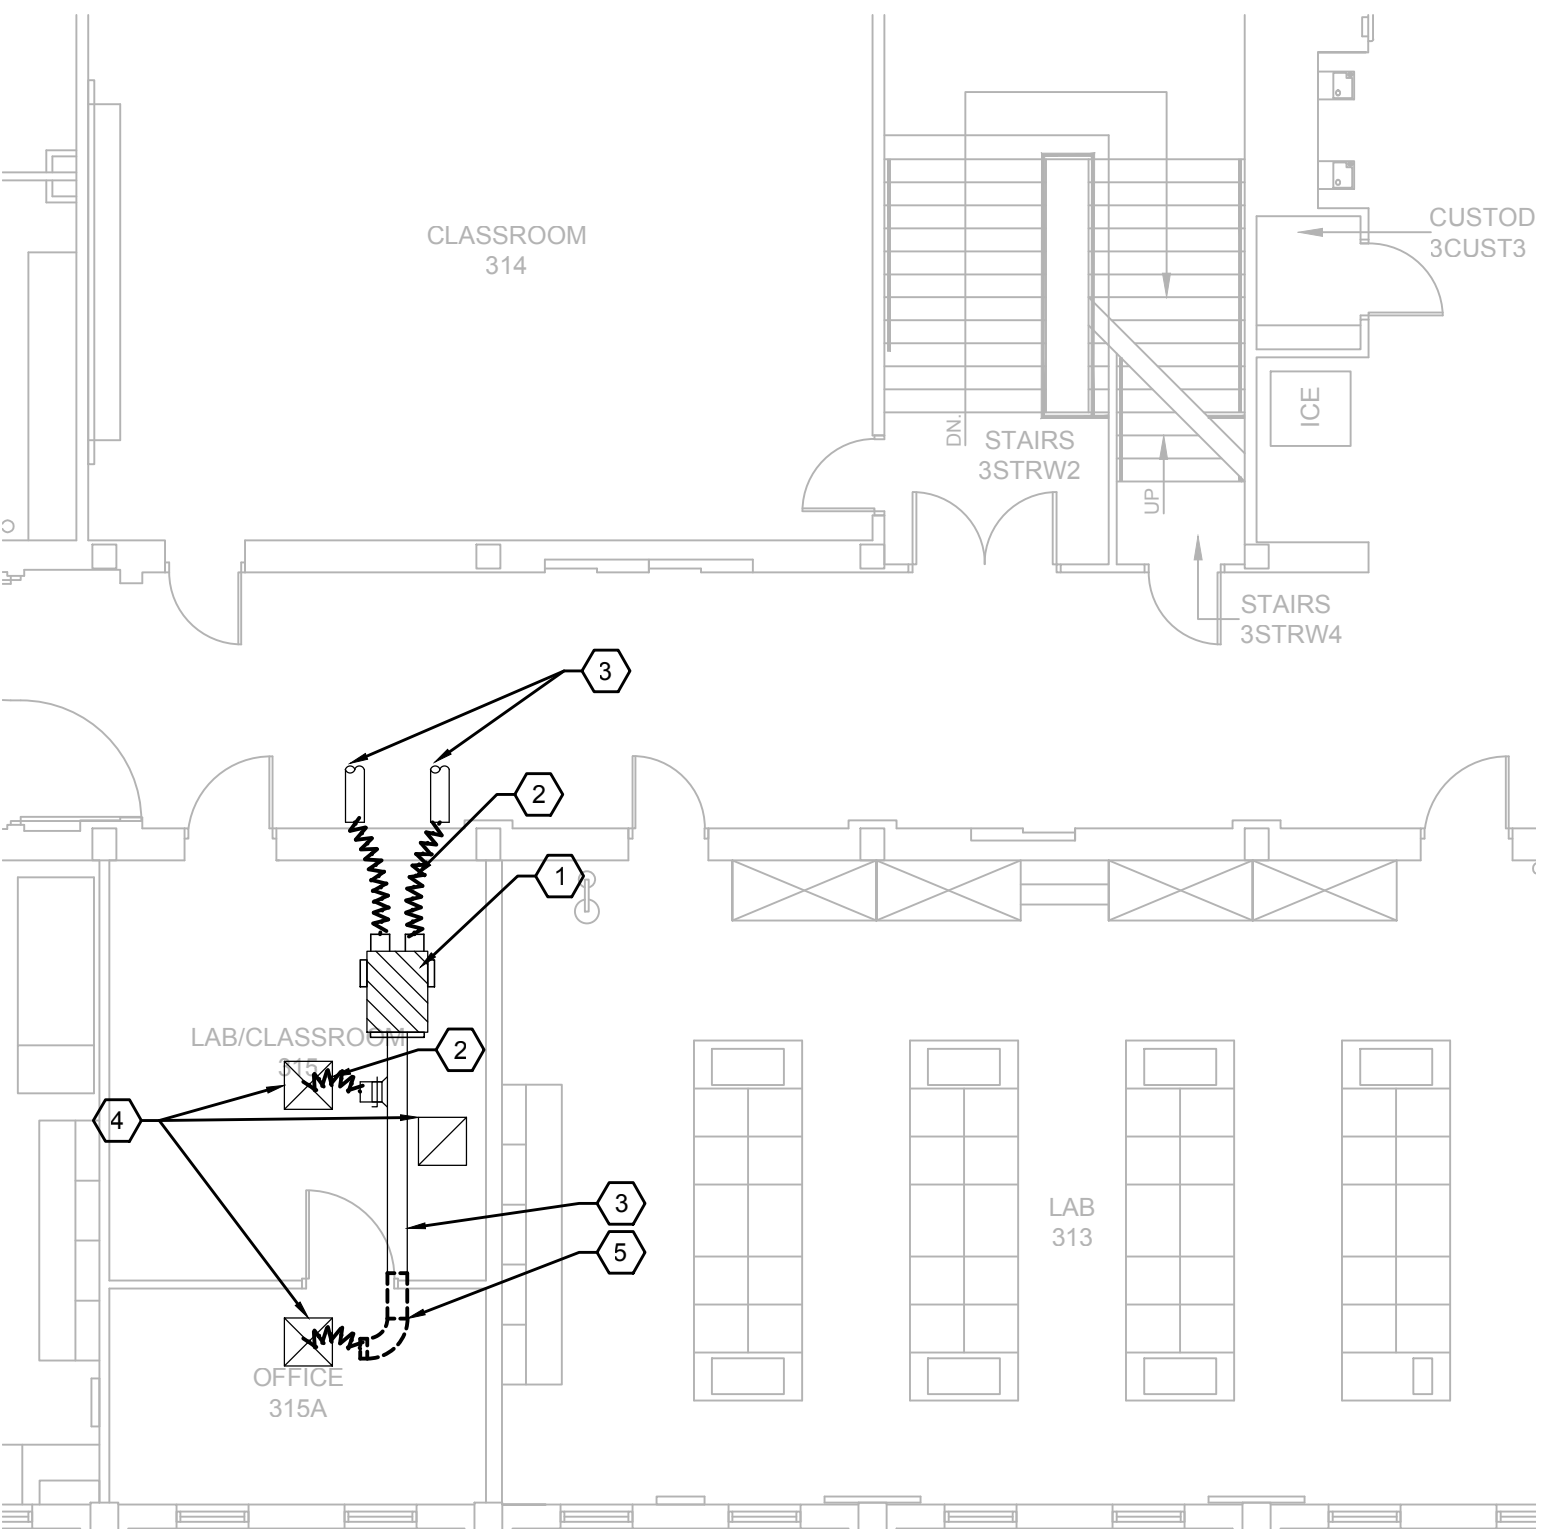

BOLIN SCIENCE HALL - THIRD FLOOR - AREA 3A
MECHANICAL DEMOLITION PLAN

DATE SIGNED: **HPA**
ARCHITECTS - PROGRAMMERS - PLANNERS
HARPER PERKINS ARCHITECTS, INC.
4724 OLD JACKSBORO HIGHWAY
WICHITA FALLS, TEXAS 76302-3599
VOICE: 846.767.1421 FAX: 846.397.0273
E-MAIL: office@harperperkins.com WEB: www.harperperkins.com

CAMPOS ENGINEERING, Inc.
Consulting Engineers
1331 River Bend Drive
Dallas, Texas 75247
(214) 696-6291
campos@camposengineering.com
Registration No. F-001731
CEI Project Number D17-1263.00

TASADA - FIRE MARSHAL DEFERRED MAINTENANCE PROJECTS FOR

MIDWESTERN STATE UNIVERSITY

3410 TAFT BOULEVARD
WICHITA FALLS, TEXAS

DRAWN BY:


DATE: 15 MAY 2017


REVISIONS		
NO.	DESCRIPTION	DATE
1	ADDENDUM 2	08/10/17

16782.00


© 2017 HARPER PERKINS ARCHITECTS

B-MD101

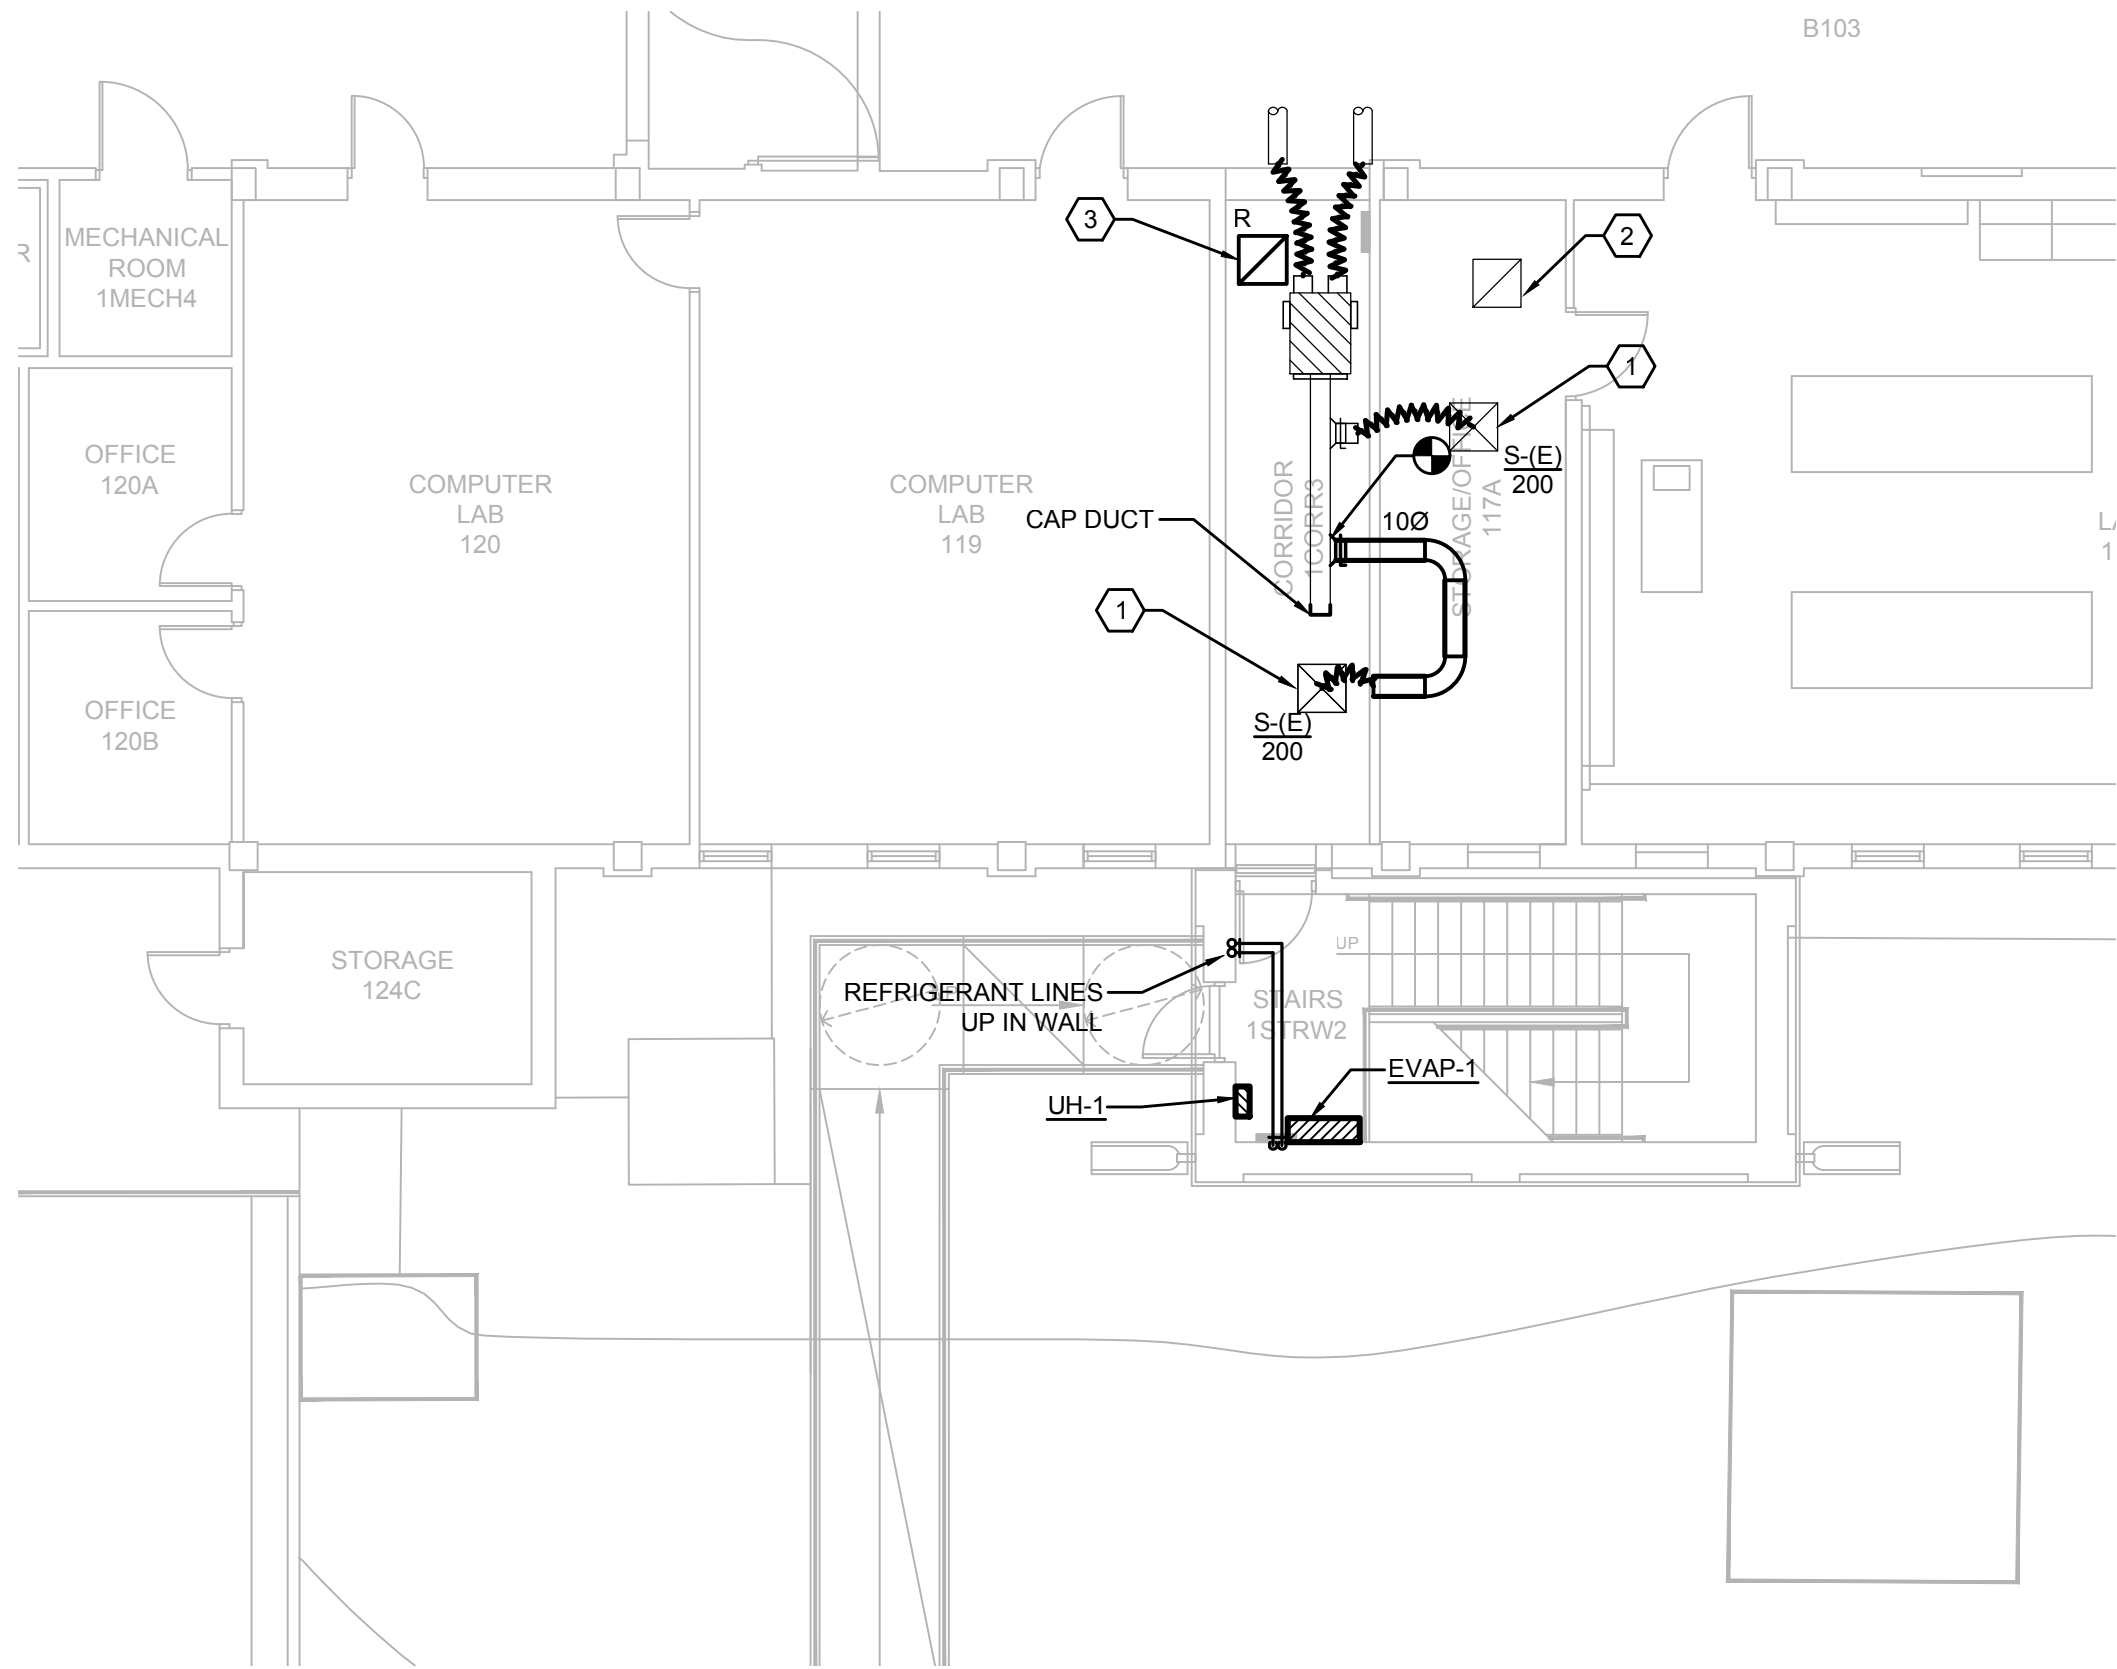


 1
B-M101 SCALE: 1/8" = 1'-0"

**BOLIN SCIENCE HALL - FIRST FLOOR - AREA 1A
MECHANICAL PLAN**

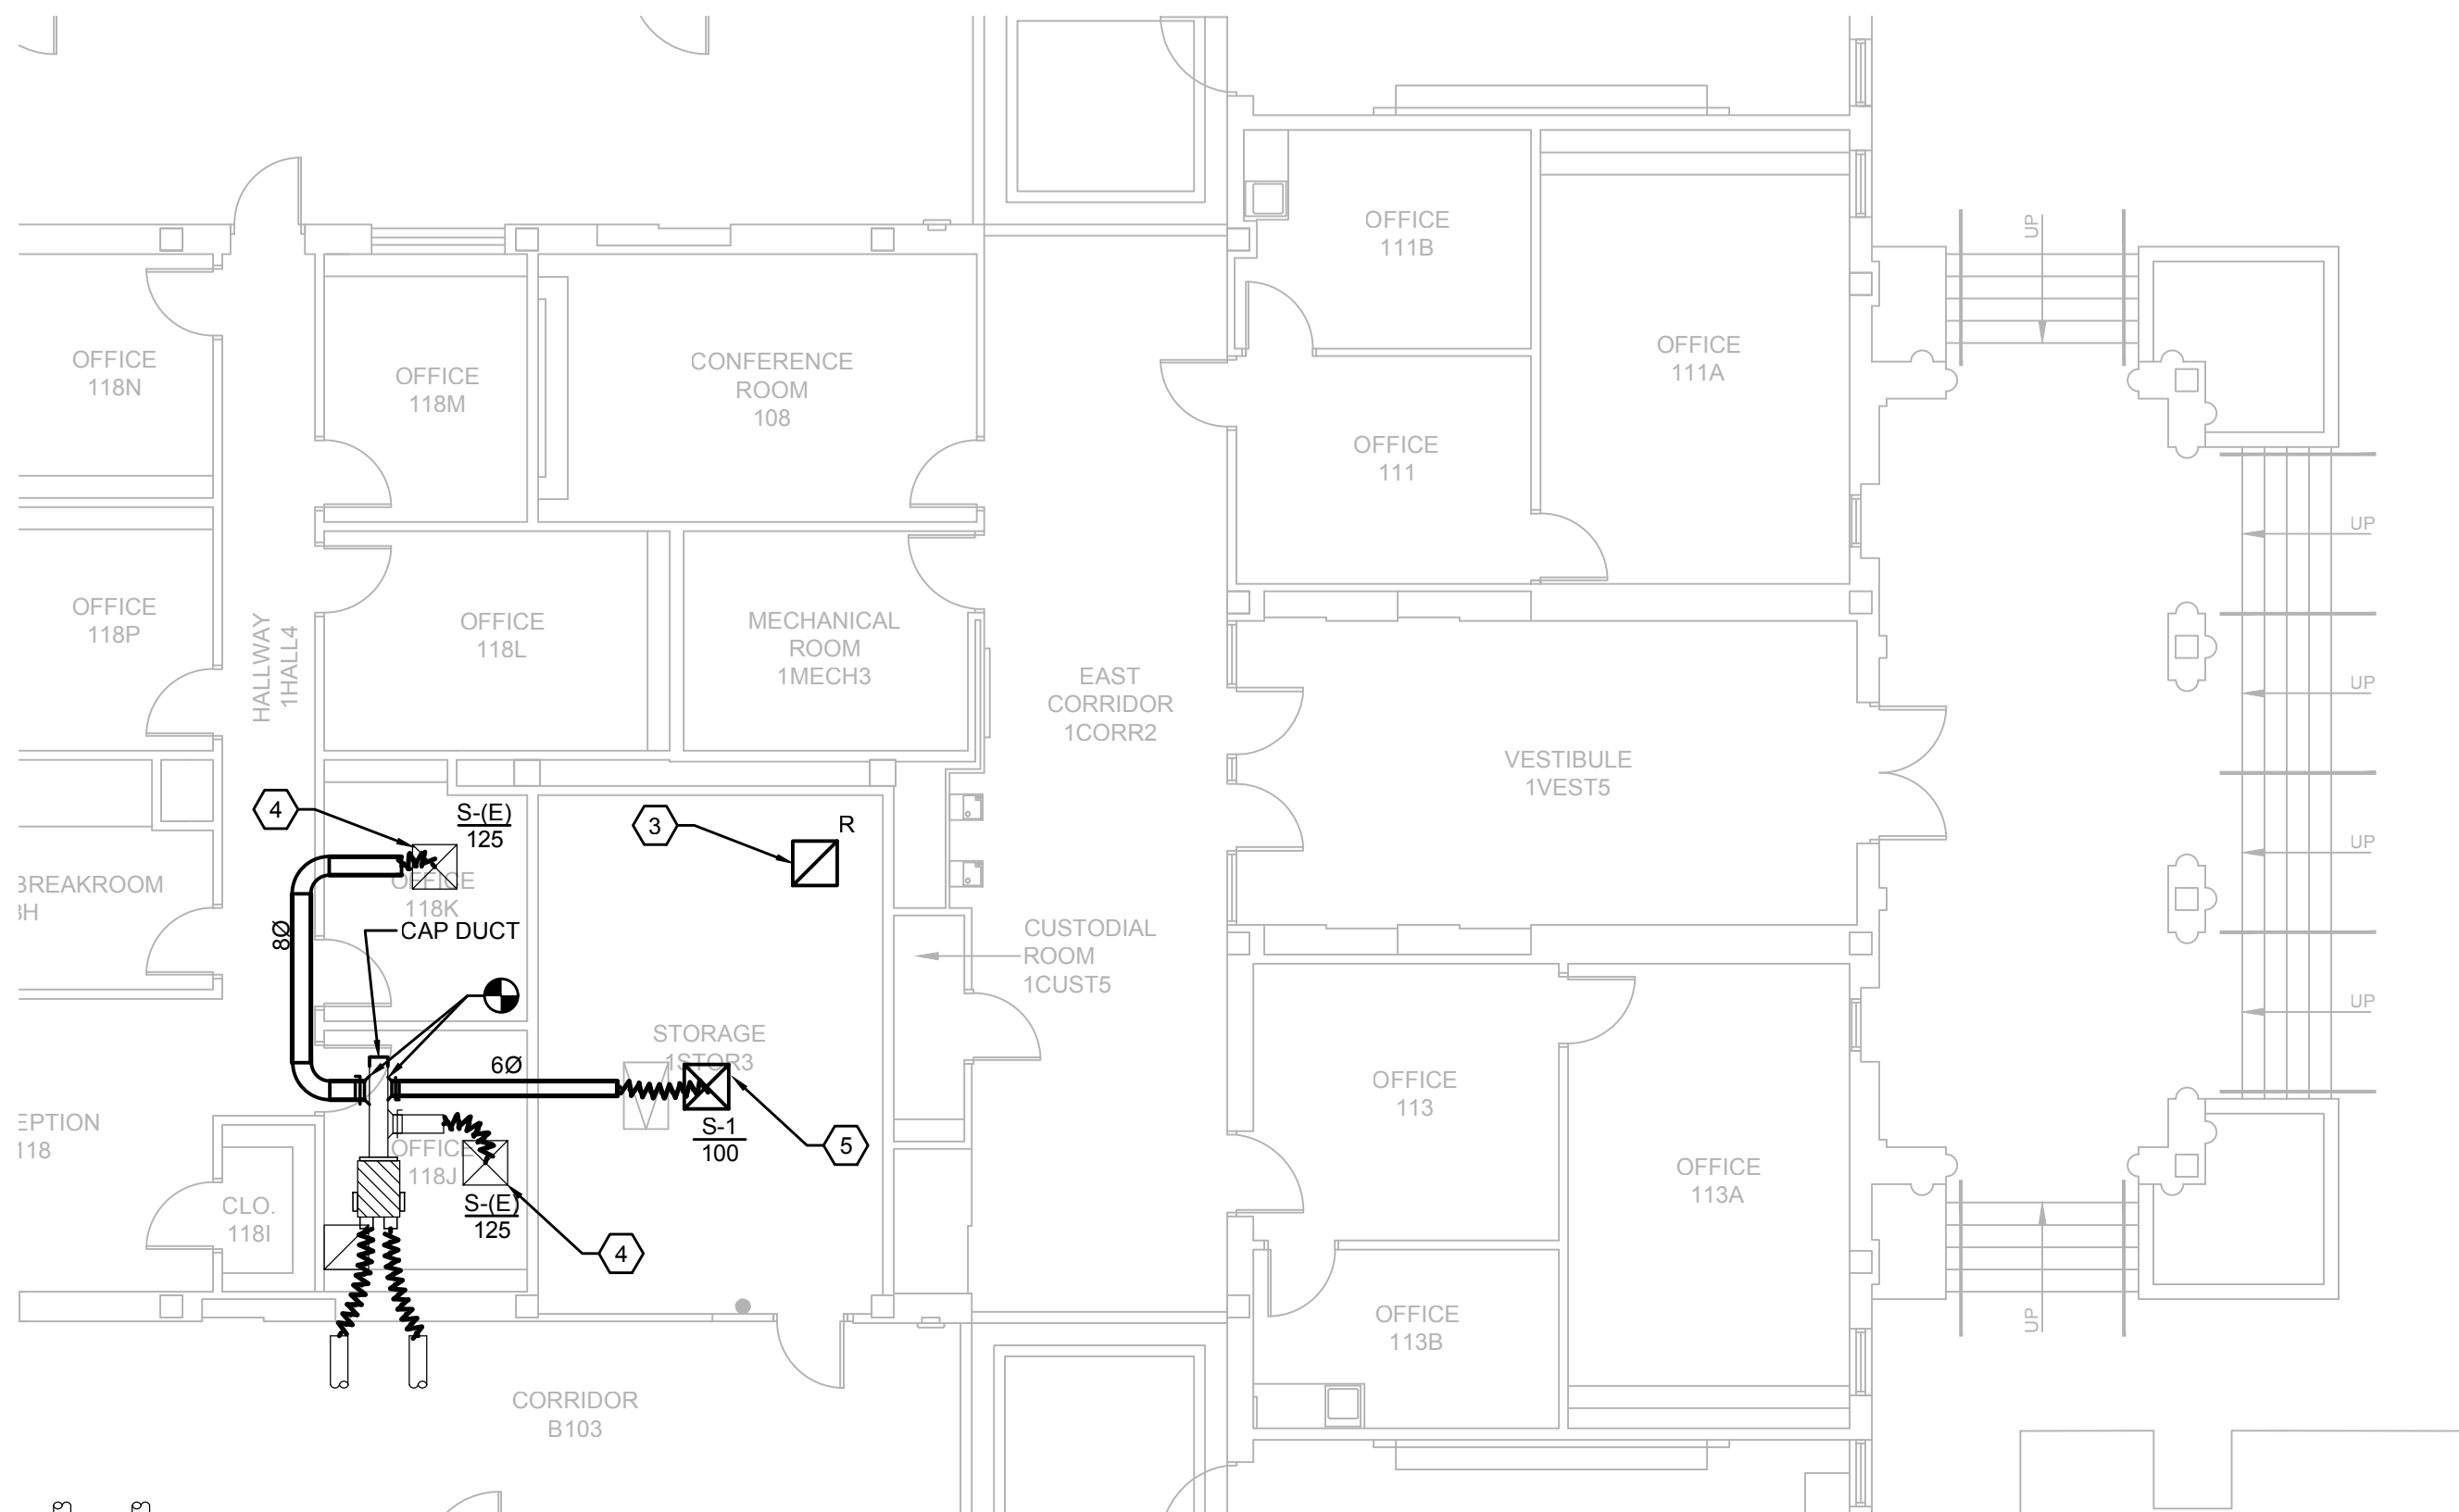

 2
B-M101 SCALE: 1/8" = 1'-0"

**BOLIN SCIENCE HALL - FIRST FLOOR - AREA 1B
MECHANICAL PLAN**

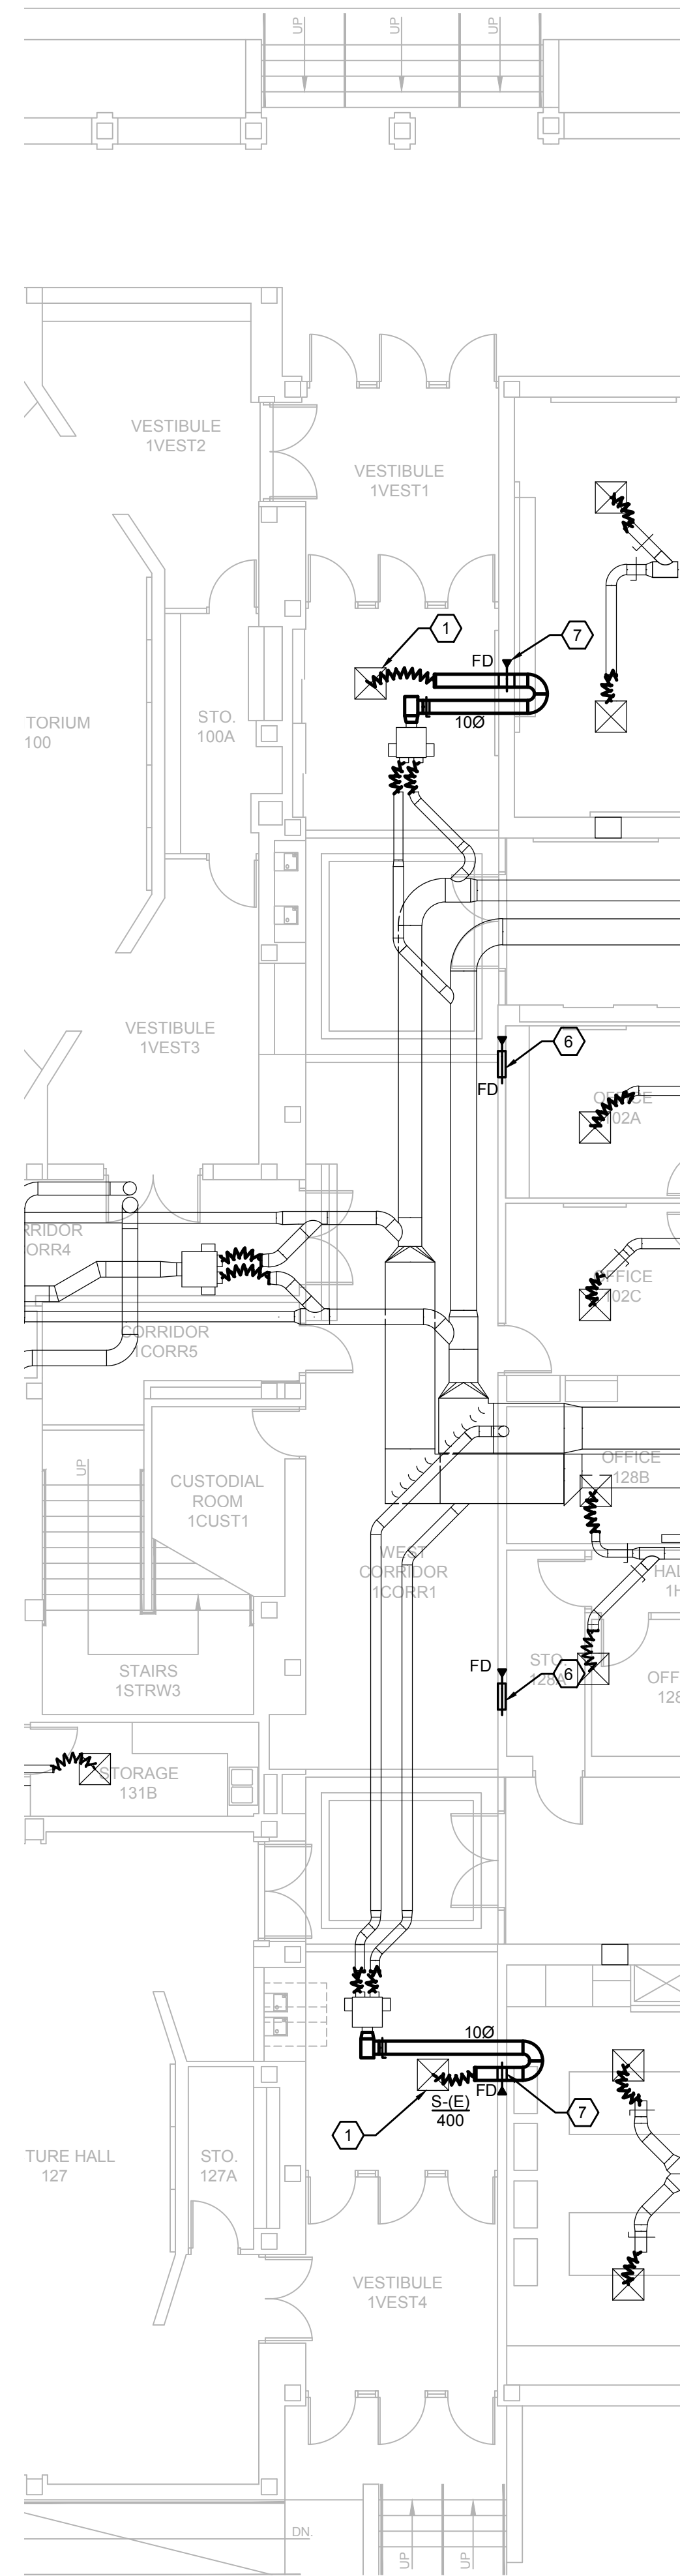

 3
B-M101 SCALE: 1/8" = 1'-0"

**BOLIN SCIENCE HALL - FIRST FLOOR - AREA 1C
MECHANICAL DEMOLITION PLAN**

GENERAL NOTES


(NOT ALL NOTES APPLY TO EACH SHEET)

- REFER TO SYMBOL LEGEND AND GENERAL NOTES.
- REFER TO SPECIFICATIONS.
- REFER TO ARCHITECTURAL OVERALL FLOOR PLANS FOR LOCATIONS SCOPE OF WORK AREAS WITHIN THE BUILDING.

KEY NOTES

(NOT ALL NOTES APPLY TO EACH SHEET)

- RELOCATE SUPPLY DIFFUSER AND BALANCE AS SHOWN ON PLAN. INSTALL NEW DIFFUSER IF THE ONE REMOVED FROM DEMOLITION IS DAMAGED. REFER TO DEMOLITION NOTES. COORDINATE LOCATION OF DIFFUSER WITH CEILING PLANS AND OTHER TRADES. REBALANCE EXISTING DUAL DUCT MIXING BOX AS REQUIRED.
- RELOCATE RETURN AIR GRILLE. INSTALL NEW RETURN GRILLE IF THE ONE REMOVED FROM DEMOLITION IS DAMAGED. REFER TO DEMOLITION NOTES. COORDINATE LOCATION OF GRILLE WITH CEILING PLANS AND OTHER TRADES.
- NEW RETURN AIR GRILLE, COORDINATE LOCATION WITH CEILING PLANS AND OTHER TRADES. ENSURE RETURN AIR HAS A FREE PATH OUT OF THE NEW ROOM, IF NOT PROVIDE RETURN AIR BOOT AS REQUIRED.
- REBALANCE EXISTING SUPPLY DIFFUSER SHOWN ON PLAN.
- NEW SUPPLY DIFFUSER, BALANCE AS SHOWN ON PLAN. COORDINATE LOCATION OF DIFFUSER WITH CEILING PLANS AND OTHER TRADES. RE-BALANCE EXISTING DUAL DUCT MIX BOX AS NEEDED.
- INSTALL NEW FIRE DAMPER IN RETURN AIR DUCT, SIMILAR TO RUSKIN DIBD20G, 20X10. AND RETURN GRILLE SIMILAR TO TITUS 359RL, 20X10. PROVIDE ACCESS DOOR TO FIRE DAMPER IF INSTALLED IN A HARD CEILING AREA.
- INSTALL 10" ROUND FIRE DAMPER SIMILAR TO RUSKIN FDR25 WITH ACCESS DOOR SIMILAR TO RUSKIN MODEL ADR1 FOR RESETTING THE FIRE DAMPER. PROVIDE ACCESS DOOR TO DUCTWORK IF FIRE DAMPER IS INSTALL IN A HARD CEILING AREA.

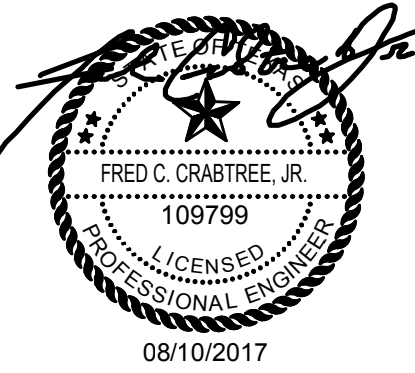

DATE SIGNED:



CAMPOS
ENGINEERING, Inc.
Consulting Engineers
1331 River Bend Drive
Dallas, Texas 75247
(214) 696-6291
campos@camposengineering.com
Registration No. F-001731
CEI Project Number D17-1263.00

TAS/ADA - FIRE MARSHAL DEFERRED MAINTENANCE PROJECTS FOR
MIDWESTERN STATE UNIVERSITY
3410 TAFT BOULEVARD
WICHITA FALLS, TEXAS



DRAWN BY:

DATE: 15 MAY 2017

REVISIONS

NO.	DESCRIPTION	DATE
1	ADDENDUM 2	08/10/17

16782.00

© 2017 HARPER PERKINS ARCHITECTS

B-M101

ELEVATOR SUMP PUMP SYSTEM

GENERAL

THE CONTRACTOR SHALL FURNISH AND INSTALL A PARKUSA ELEVATOR MODEL ELV-100 COMPLETE PUMP, SEPARATOR, AND CONTROL AND ALARM SYSTEM AS SHOWN ON THE DRAWINGS. PUMP(S) SHALL BE PROVIDED FOR EACH ELEVATOR HOISTWAY.

THE SYSTEM SHALL BE CAPABLE OF PUMPING ALL WATER & FLUIDS AUTOMATICALLY FROM THE ELEVATOR PIT AS REQUIRED BY TOLR (TEXAS DEPARTMENT OF LICENSING AND REGULATION) ELEVATOR RULES AND ASME A17.1/CSA B44 SAFETY CODE FOR ELEVATORS AND ESCALATORS, 2007, SECTION 2.2.2.5. THE SYSTEM SHALL FUNCTION AUTOMATICALLY TO REMOVE WATER AND FLUIDS FROM THE PIT AUTOMATICALLY WITHOUT ANY HUMAN INTERVENTION. SYSTEMS THAT DO NOT REMOVE ALL THE FLUID INCLUDING OIL ARE NOT COMPLIANT AND WILL NOT BE ACCEPTED.

AN OIL-WATER SEPARATOR OR EQUIVALENT PROTECTION SHALL BE USED TO TREAT OILY WASTEWATER AUTOMATICALLY FROM THE ELEVATOR PIT PRIOR TO DISCHARGE INTO THE PUBLIC SANITARY SEWER AS REQUIRED BY THE TEXAS COMMISSION ON ENVIRONMENTAL QUALITY (TCEQ) AND LOCAL PLUMBING CODES. PUMPING INTO THE STORM SEWER IS NOT PERMITTED. SYSTEMS THAT DO NOT REMOVE THE OIL WILL NOT BE ACCEPTED.

SUMP PUMP

A SUBMERSIBLE SUMP PUMP IS LOCATED IN THE SUMP AREA OF THE ELEVATOR (REFER TO PLAN DRAWINGS). THE SUMP PUMP SHALL BE AS SPECIFIED ON THE SCHEDULE. HEAVY DUTY SUBMERSIBLE TYPE, CAPABLE OF PUMPING WATER, WATER/OIL AND OIL AT A MINIMUM CAPACITY OF 50 GPM @ 23' TDH, 3000 GPH AS PER ASME A17.1 SECTION 2.2.2.5 (2007). THE PUMP SHALL BE CONSTRUCTED AND TESTED TO MEET UL 778 STANDARDS AND SHALL INCLUDE THERMAL OVERLOAD PROTECTION. REFER TO THE SCHEDULE FOR CAPACITY AND ELECTRICAL REQUIREMENTS. THE PUMP SHALL BE CAPABLE OF OPERATING WITH THE WATER LEVEL COVERING ONLY 50% OF THE MOTOR CASING AND SHALL OPERATE AUTOMATICALLY EITHER CONTINUOUSLY OR INTERMITTENTLY AS REQUIRED BY THE ON-OFF FLOAT SWITCH CONTROL. THE PUMP SHALL HAVE A SIZE 1-1/4" MINIMUM DISCHARGE CONNECTION. THE MOTOR HOUSING AND FASTENING BOLTS SHALL BE CONSTRUCTED OF 304 STAINLESS STEEL AND HAVE CARBON CERAMIC SEALS. THE PUMP SHALL HAVE A SELF-OPEN, NON-CLOGGING VORTEX IMPELLER AND SHALL BE DESIGNED FOR FLOOR MOUNTING COMPLETE WITH SUPPORT LEGS. A STAINLESS CHAIN SHALL BE PROVIDED FOR EASY MAINTENANCE.

OIL/WATER SEPARATOR

THE SEPARATOR IS LOCATED EITHER FREESTANDING, OR RECESSED ON FLOOR NEAR THE SHAFT, OR LOCATED OUTDOORS BURIED BELOW GRADE. REFER TO THE SCHEDULE FOR CAPACITY AND SIZE REQUIREMENTS. THE SEPARATOR UNIT IS RATED FROM 50 TO 200 GPM DEPENDING ON THE QUANTITY OF ELEVATOR SHAFTS TO BE SERVED, 50 GPM OR 3000 GPH AS PER ASME A17.1 SECTION 2.2.2.5 (2007). THE OIL/WATER SEPARATOR SHALL BE A PRE-ENGINEERED ENHANCED GRAVITY SEPARATOR CAPABLE OF TREATING WASTEWATER DISCHARGE FREE OF PETROLEUM HYDROCARBONS, CONCENTRATION OF LESS THAN 100 PARTS PER MILLION. OPERATING RANGE OF THE INFLUENT IS 40°F TO 180°F AND AMBIENT AIR TEMPERATURE FROM 0°F TO 140°F. THE SPECIFIC GRAVITY OF THE OILS AT THESE OPERATING TEMPERATURES IS .70 TO .95. THE SEPARATOR SHALL BE DESIGNED TO WITHSTAND STATIC AND DYNAMIC HYDRAULIC LOADINGS WHILE EMPTY AND DURING OPERATION. THE TANK SHALL BE CONSTRUCTED OF 4500 PSI PRECAST CONCRETE CONFORMING TO ASTM C-913 FOR TANKS, WEIRS, FLOW DISTRIBUTORS, AND ENERGY DISSIPATER DEVICES. ALL INTERNAL COMPONENTS SHALL CONSIST OF CORROSION RESISTANT MATERIALS OR BE EPOXY COATED. ALL WELDING SHALL BE ACCORDANCE WITH AWS D11.1 TO PROVIDE WATER/TIGHT VESSELS THAT WILL NOT WARP OR DEFORM EXCESSIVELY UNDER LOAD. MANWAY ACCESS COVER SHALL BE H-20 TRAFFIC DUTY, BOLTED AND GASKETED. THE SEPARATOR SHALL UTILIZE COALESCING MEDIA FABRICATED OF CALCIUM CARBONATE-FILLED CLEOPHILIC POLYPROPYLENE PLASTIC MATERIAL AND ASSEMBLED INTO MODULES WITH 304 STAINLESS STEEL MATERIALS. MEDIA ASSEMBLY SHALL BE SELF-CLEANING AND REMOVABLE.

CONTROL SYSTEM

THE CONTROL SYSTEM SHALL CONSIST OF FLOAT SENSORS AND A SINGLE CONTROL PANEL (NEMA 4X WEATHERPROOF) THAT IS WALL MOUNTED NEAR THE ELEVATOR SHAFT. THE CONTROL PANEL SHALL BE CONSTRUCTED AND TESTED TO MEET UL50A STANDARDS AND SHALL BE HOUSED IN A WEATHERPROOF NEMA 4X ELECTRICAL ENCLOSURE WITH A WIRING TERMINAL STRIP FOR FIELD WIRING TO THE J-BOX IN THE HOISTWAY.

THE CONTROL PANEL SHALL HAVE THE FOLLOWING FUNCTIONS:



- OPERATES THE SUMP PUMP, "ON/OFF" DEPENDING ON SHAFT WATER LEVELS. THE PANEL SHALL HAVE A "HAND-OFF-AUTO" SWITCH, A "PUMP RUN" LIGHT, AND AUXILIARY CONTACTS FOR A BAS SYSTEM.
- INDICATES "SUMP HIGH LEVEL" OF THE ELEVATOR SHAFT. IN THE EVENT OF PUMP MALFUNCTION, THE PANEL SHALL HAVE A "SUMP HIGH LEVEL" ILLUMINATED RED LIGHT AND HIGH DECIBEL WARNING HORN, A "SILENCE" SWITCH, AND AUXILIARY DRY CONTACTS FOR BAS SYSTEM.
- INDICATES "HIGH OIL LEVEL" OF THE SEPARATOR. IN THE EVENT OF A HIGH ACCUMULATION OF OIL IN THE SEPARATOR, THE PANEL SHALL HAVE A "SEPARATOR HIGH LEVEL" ILLUMINATED RED LIGHT & HIGH DECIBEL WARNING HORN, A "SILENCE" SWITCH, AND AUXILIARY DRY CONTACTS FOR BAS SYSTEM. NOTE: THE PRESENCE OF OIL DOES NOT PREVENT THE PUMP FROM OPERATING.

THE PANEL ALSO INCLUDES A SEPARATE OVER-CURRENT RELAY AND FIELD ADJUSTABLE MOTOR OVERLOAD HAVING A RANGE OF 5 TO 15 AMPS, FACTORY SET AT 8 AMPS FOR THIS PUMP APPLICATION. THE CONTROL PANEL SHALL HAVE A COMBINATION MANUAL "RESET/PUSH" TO TEST SWITCH FOR MOTOR OVERLOAD WITH BOTH AUTOMATIC, MANUAL, RESET AND CONTROL DIAGNOSTICS. THE CONTROL SYSTEM MUST BE FACTORY SET FOR AUTOMATIC OVERLOAD RESTART.

THE CONTROL SYSTEM SHALL INCLUDE THREE FIELD ADJUSTABLE FLOAT SWITCHES LOCATED IN THE SUMP, PUMP OFF, PUMP ON, AND HIGH LEVEL. PROVIDE A FACTORY PREWIRED NEMA 6P WATER TIGHT JUNCTION BOX WITH A DIN RAIL MOUNTED WIRING TERMINAL STRIP. PROVIDE FACTORY INSTALLED WIRING OF PUMP AND FLOATS INTO A NEMA 6P JUNCTION BOX. ALL CABLES BETWEEN THE PUMP AND JUNCTION BOX SHALL BE A MAXIMUM OF 6' LONG PER NEC 2008. THE CABLE SHALL BE HEAVY USAGE, WATER TIGHT AND OIL RESISTANT. THE FLOATS AND OIL SENSING PROBE SHALL BE FACTORY MOUNTED ON THE PUMP HOUSING. ALL CABLE ENTRIES INTO THE J-BOX FROM THE PUMP PIT SHALL HAVE NEMA 6P WATER TIGHT CORD GRIPS. THE OIL SENSING PROBE IS TO BE FACTORY MOUNTED AND POSITIONED WITHIN THE SEPARATOR AND FACTORY TESTED AS A COMPLETE SYSTEM.

ACCEPTABLE MANUFACTURERS:

PARKUSA ELEVATOR SYSTEM, OR ENGINEERED PRE-APPROVED EQUAL, PROVIDED ALL OF THE SPECIFICATIONS ARE MET.

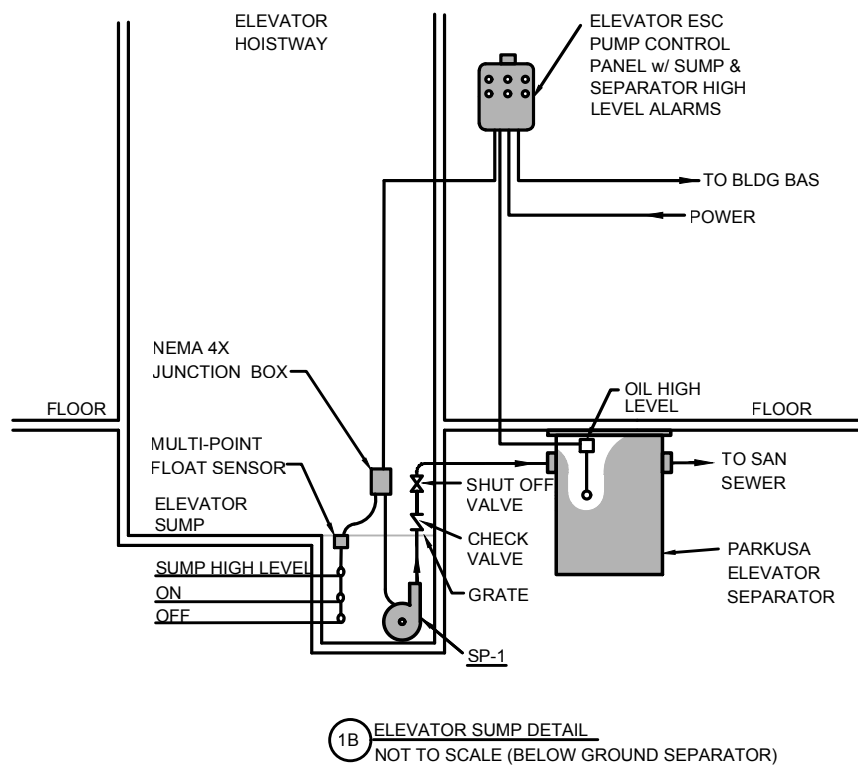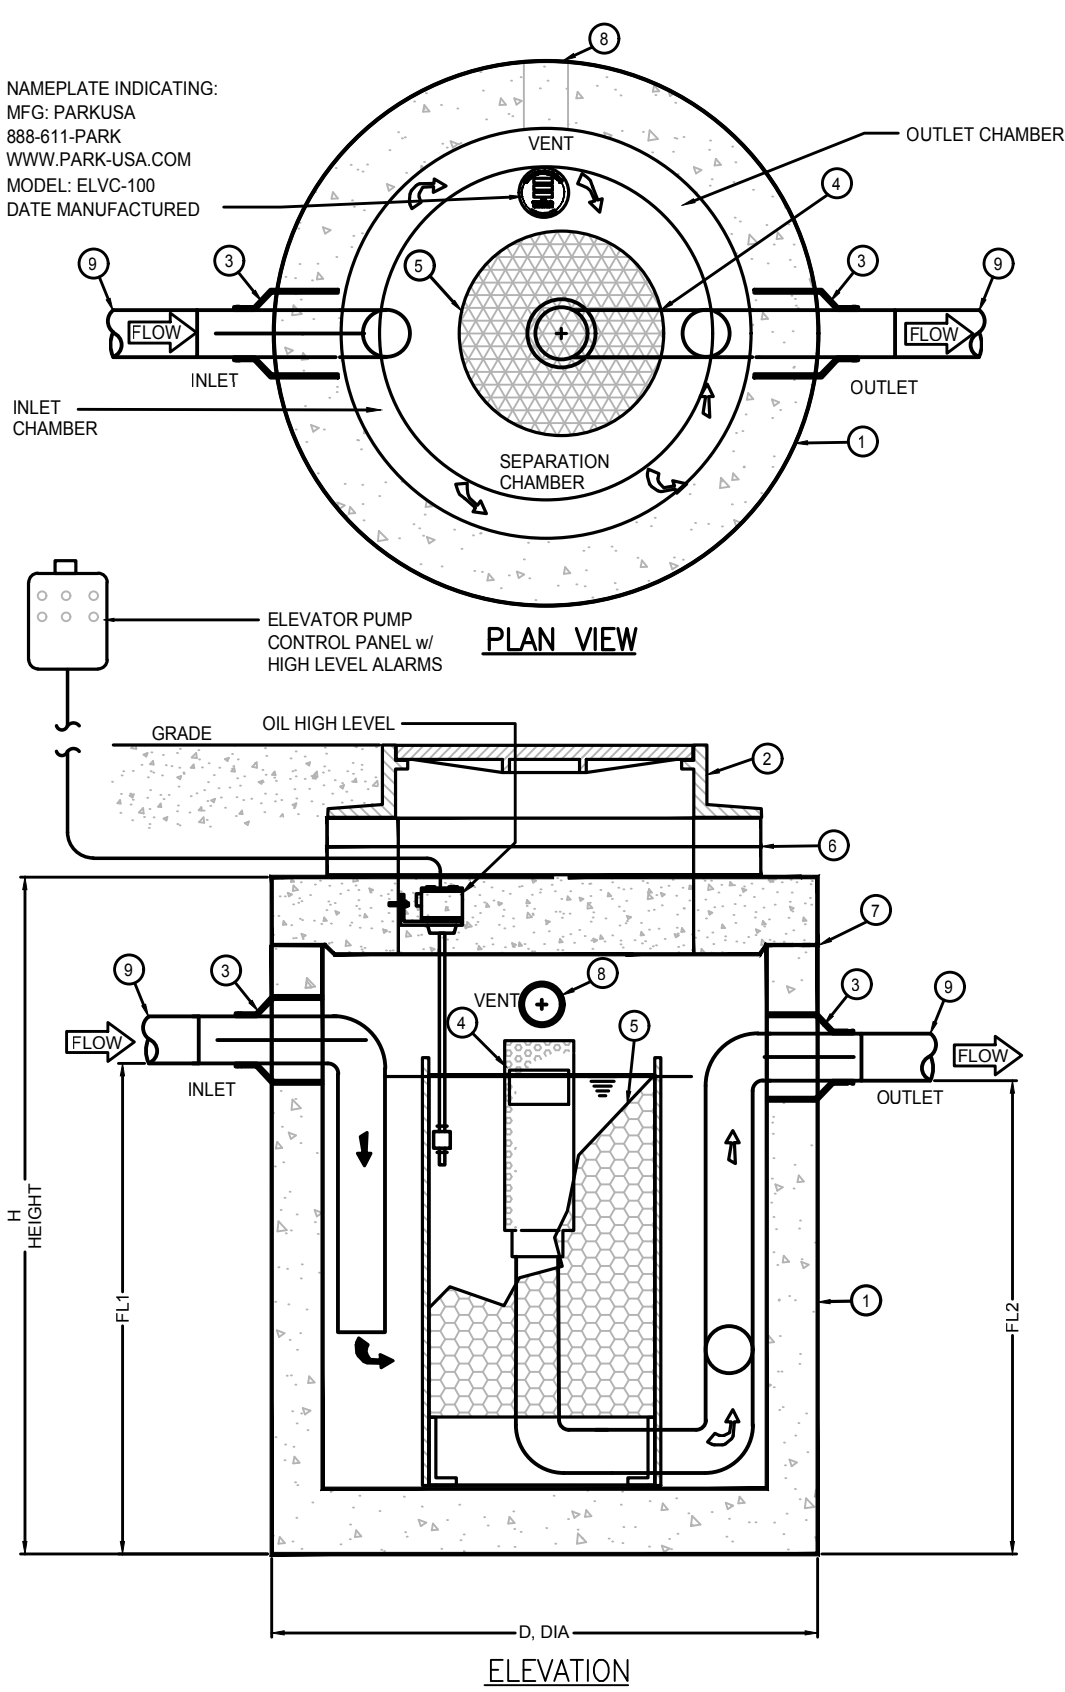

NOTES


- SEPARATOR BASIN, PRECAST CONCRETE INTERIOR EPOXY LINER & EXTERIOR VAPOR BARRIER
- CASTITE, HINGED, DUCTILE IRON ACCESS COVER WITH NEOPRENE GASKET, H-20 TRAFFIC RATED
- RESILIENT RUBBER CONNECTION
- OIL/STOP-FLOW AUTOMATIC SHUT-OFF VALVE AT OUTLET PIPING
- CLEOPHILIC COALESCING PLATE PACK TO SEPARATE OIL & SOLIDS
- EXTENSION RINGS AS REQUIRED
- JOINTS SEALED WATER-TIGHT WITH OIL RESISTANT GASKET
- VENT - NPT HALF CPLG
- PIPING BY OTHERS

2 ELEVATOR SUMP PUMP SEPARATOR DETAIL
SCALE: NONE

ELEVATOR SUMP SYSTEM SCHEDULE																
SYSTEM MODEL		SEPARATOR DATA							SUBMERSIBLE PUMP DATA (SP-1)							
SYSTEM SIZE	ELEVATORS	SEPARATOR MODEL	FLOW CAP. GPM	TOTAL CAPACITY	OIL SPILL CAPACITY	INLET DIA.	HEIGHT FT.	INLET P.S.I.	OUTLET P.S.I.	FLOW CAP. GPM	TDH	REQ. SIZE	RPM	HP	VOLTPH	MANUF. MODEL
ELVC-100	1	EC-100	50	100 GALL	50 GAL	44"	34"	39"	36"	50	12'	1 1/4"	1750	50	1151	ZOELLER 153
NOTES:																
1. REFERENCE STRUCTURAL DRAWINGS FOR ELEVATOR SUMP BASIN SIZE.																

PLUMBING EQUIPMENT SCHEDULE				
SYMBOL	DESCRIPTION	MANUFACTURER	MODEL NUMBER	SPECIFICATION
GCO	GROUND CLEANOUT	JOSAM	S-7008-Z-CL	COATED CAST IRON FLOOR CLEANOUT. INTERNAL GASKETED ABS CLEANOUT PLUG. NO HUB CONNECTION AND ADJUSTABLE. ABS HOUSING WITH SPECIAL, DUTY, SCOREMATED SECURED ROUND CAST IRON TOP.
FS-1	FLOOR SINK	JOSAM	49300	CAST IRON WITH ACID RESISTING INTERIOR, DOUBLE DRAINAGE FLANGE, WEEP HOLES, BOTTOM OUTLET. SQUARE TOP ALUMINUM INTERNAL DOME STRAINER AND CAST IRON NON TRAFFIC-ACID RESISTING-ANTI-TILTING HALF (1/2) GRATE. PROVIDE WITH TRAP GUARD.
HD-1	HUB DRAIN	-	-	CAST IRON SOIL PIPE INCREASER FITTING. HUB TO BE ONE SIZE LARGER THAN SPIGOT END. PROVIDE WITH AIR GAP JOSAM 889000 AND TRAP GUARD.
DS-1	DOWNSPOUT NOZZLE	J.R. SMITH	FIG. #1770	DOWNSPOUT NOZZLE CAST BRONZE BODY AND FLANGE, MOUNT 12 INCHES ABOVE THE FINISH GRADE. PROVIDE CONCRETE SPLASH BLOCK IF NEEDED.
RD/OD	ROOF DRAIN/ OVERFLOW DRAIN	J.R. SMITH	FIG. #1800	DUJO CAST IRON BODIES WITH COMBINED FLASHING CLAMP AND GRAVEL STOPS FOR ROOF DRAIN, AND COMBINED FLASHING CLAMP AND GRAVEL STOPS WITH 3.5" HIGH INTERNAL WATER DAM STANDPIPE FOR OVERFLOW DRAIN. DECK PLATE WITH SECURITY HOLES. BOTH DRAINS WITH CAST IRON DOMES.
NFB-1	NON-FREEZE ROOF HOSE BIB	WOODFORD	MODEL SRH-MS	NON-FREEZE ROOF POST HYDRANT TYPE WITH GALVANIZED CASING AND ADJUSTABLE FLOW LEVEL LOCK HANDLE WITH DECK FLANGE AND UNDER DECK CLAMP. 3/4" HOSE ADAPTER PROVIDE WITH INTEGRAL BACKFLOW PREVENTER.

PLUMBING FIXTURE SCHEDULE						FIXTURE CONNECTIONS		
SYMBOL	DESCRIPTION	MANUFACTURER	MODEL NUMBER	SPECIFICATION	W	H	WASTE	VENT
WC-1	WATER CLOSET	AMERICAN STANDARD	AFWALL EL #227.001	1-28 GALLON PER FLUSH ELONGATED BOWL, TOP SPUD VITREOUS CHINA WATER CLOSET WITH OPEN FRONT WHITE SEAT CHARGE MODEL 8600 SSC. FURNISH WATER CLOSET COMPLETE WITH SLOAN VALVE ROVAL 11-1/28 MANUAL FLUSH VALVE. EXPOSED FLUSH VALVE. PROVIDE JOSAM FLOOR MOUNTED CAST IRON SUPPORT.	-	-	4"	2"
WC-1H	WATER CLOSET (ADA COMPLIANT)	AMERICAN STANDARD	AFWALL EL #227.001	1-28 GALLON PER FLUSH ELONGATED BOWL, TOP SPUD VITREOUS CHINA WATER CLOSET WITH OPEN FRONT WHITE SEAT CHARGE MODEL 8600 SSC. FURNISH WATER CLOSET COMPLETE WITH SLOAN VALVE ROVAL 11-1/28 MANUAL FLUSH VALVE. EXPOSED FLUSH VALVE. PROVIDE JOSAM FLOOR MOUNTED CAST IRON SUPPORT. MOUNT AT HANDICAPPED HEIGHT AS REQUIRED BY TEXAS ACCESSIBILITY STANDARDS AND ADA REQUIREMENTS.	-	-	4"	2"
UR-1	URINAL	AMERICAN STANDARD	WASHBOOK 559.125	VITREOUS CHINA WASHOUT LOW CONSUMPTION 1.125 GALLON PER FLUSH URINAL WITH 3/4 INCH TOP SPUD, 2 INCH FEMALE THREADED OUTLET. TWO WALL HANGERS MOUNTED ON STRUCTURAL STEEL SUPPORTS ANCHORED TO FLOOR. FURNISH URINAL COMPLETE WITH SLOAN REGAL 186-4 1/2 EXPOSED FLUSH VALVE AND FLOOR MOUNTED CAST IRON SUPPORTS SIMILAR TO JOSAM PRO-SET UPRIGHTS.	-	-	2"	1 1/2"
UR-1H	URINAL (ADA COMPLIANT)	AMERICAN STANDARD	WASHBOOK 559.125	VITREOUS CHINA WASHOUT LOW CONSUMPTION 0.5 GPF URINAL WITH 3/4 INCH TOP SPUD, 2 INCH FEMALE THREADED OUTLET. TWO WALL HANGERS MOUNTED ON STRUCTURAL STEEL SUPPORTS ANCHORED TO FLOOR. FURNISH URINAL COMPLETE WITH SLOAN REGAL 186-4 1/2 EXPOSED FLUSH VALVE AND FLOOR MOUNTED CAST IRON SUPPORTS SIMILAR TO JOSAM PRO-SET UPRIGHTS. MOUNT AT HANDICAPPED HEIGHT AS REQUIRED BY TEXAS ACCESSIBILITY STANDARDS AND ADA REQUIREMENTS.	-	-	2"	1 1/2"
L-1	LAVATORY (ADA COMPLIANT)	AMERICAN STANDARD	LUCERNE 0355.01	SINGLE BOWL LAVATORY. WALL HUNG, 20-1/2" X 18-1/4". WHITE VITREOUS CHINA. FAUCET HOLES 4" ON CENTER. FRONT OVERFLOW. PROVIDE WITH DELTA FAUCET MODEL 585 LF, 0.5 GPM AERATOR. SINGLE HANDLE. PROVIDE LAVATORY WITH STRAINER MAGUIRE 159W, P-TRAP MAGUIRE 8872 SUPPLIES MAGUIRE 2165 LK. PROVIDE WITH THERMOSTATIC MIXING VALVE ZURN ZWIBOLT OR EQUAL. CARRIER SIMILAR TO WADE. INSULATE MOUNT AT HANDICAPPED HEIGHT AS REQUIRED BY TEXAS ACCESSIBILITY STANDARDS AND ADA REQUIREMENTS.	-	12"	1 1/2"	1 1/2"
L-1H	LAVATORY (ADA COMPLIANT)	AMERICAN STANDARD	LUCERNE 0355.01	SINGLE BOWL LAVATORY. WALL HUNG, 20-1/2" X 18-1/4". WHITE VITREOUS CHINA. FAUCET HOLES 4" ON CENTER. FRONT OVERFLOW. PROVIDE WITH DELTA FAUCET MODEL 585 LF, 0.5 GPM AERATOR. SINGLE HANDLE. PROVIDE LAVATORY WITH STRAINER MAGUIRE 159W, P-TRAP MAGUIRE 8872 SUPPLIES MAGUIRE 2165 LK. PROVIDE WITH THERMOSTATIC MIXING VALVE ZURN ZWIBOLT OR EQUAL. CARRIER SIMILAR TO WADE. INSULATE MOUNT AT HANDICAPPED HEIGHT AS REQUIRED BY TEXAS ACCESSIBILITY STANDARDS AND ADA REQUIREMENTS.	-	12"	1 1/2"	1 1/2"
L-2H	LAVATORY (ADA COMPLIANT)	AMERICAN STANDARD	PIAZZA 3478.803	WHITE VITREOUS CHINA COUNTERTOP LAVATORY WITH OVAL BASIN. FAUCET HOLES 4" ON CENTER AND FRONT OVERFLOW. PROVIDE WITH DELTA FAUCET MODEL 585 LF, 0.5 GPM AERATOR. SINGLE HANDLE. GRID DRAIN, P-TRAP AND STOPS. MOUNT AT HANDICAPPED HEIGHT AS REQUIRED BY TEXAS ACCESSIBILITY STANDARDS AND ADA REQUIREMENTS.	-	-	1 1/2"	1 1/2"
EW-1	ELECTRIC WATER COOLER (ADA COMPLIANT)	ELKAY	SWRFLD E3PBM11TRAC	FREE WATERWAYS. WATERSENTRY FILTER SYSTEM. ANTIMICROBIAL SAFETY BUBBLER. FRONT PUSH BUTTON. PROVIDE STOP AND P-TRAP. INSULATE WASTE PIPING WITH 1/2" FLEXIBLE ELASTOMERIC INSULATION.	12"	-	1 1/2"	1 1/2"
EW-2	ELECTRIC WATER COOLER	ELKAY	E2H60 LZ58N5LP	BOTTLE FILLING STATION AND SINGLE COOLER. WATER FILTER SYSTEM. ANTIMICROBIAL SAFETY BUBBLER. FRONT PUSH BUTTON. PROVIDE STOP AND P-TRAP. INSULATE WASTE PIPING WITH 1/2" FLEXIBLE ELASTOMERIC INSULATION. MOUNT AT NORMAL HEIGHT.	12"	-	1 1/2"	1 1/2"
EW-3	ELECTRIC WATER COOLER (ADA COMPLIANT)	ELKAY	E2H60 LZ58N5LP	BOTTLE FILLING STATION AND SINGLE COOLER. WATER FILTER SYSTEM. ANTIMICROBIAL SAFETY BUBBLER. FRONT PUSH BUTTON. PROVIDE STOP AND P-TRAP. INSULATE WASTE PIPING WITH 1/2" FLEXIBLE ELASTOMERIC INSULATION. MOUNT AT HANDICAPPED HEIGHT AS REQUIRED BY TEXAS ACCESSIBILITY STANDARDS AND ADA REQUIREMENTS.	12"	-	1 1/2"	1 1/2"
SH-1H	SINGLE SHOWER/STALL ADA	-	REFER TO ARCHITECTURAL PLANS	PROVIDE SHOWER STALL WITH VALVE DELTA R1000JN6K, TRIM VALVE DELTA T1770T AND HAND HELD SHOWER HEAD DELTA RPW304HP-1.5 AT 1.5 GPM. 60" FLEXIBLE STAINLESS STEEL HOSE WITH DUAL CHECK VALVES FOR BACKFLOW PROTECTION. SHOWER STALL TO COMPLY WITH TEXAS ACCESSIBILITY STANDARDS AND ADA REQUIREMENTS.	12"	12"	2"	2"

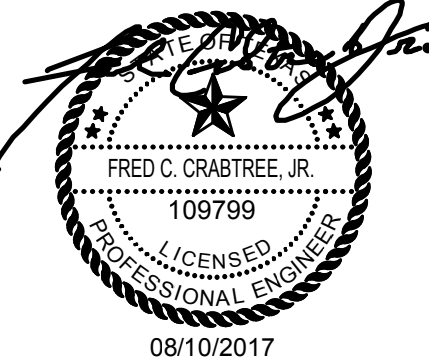

DATE SIGNED:



TASADA - FIRE MARSHAL DEFERRED MAINTENANCE PROJECTS FOR
MIDWESTERN STATE UNIVERSITY
WICHITA FALLS, TEXAS
3410 TAFT BOULEVARD



DRAWN BY:

DATE: 15 MAY 2017

REVISIONS

NO.	DESCRIPTION	DATE
1	ADDENDUM 2	08/10/17

16782.00

© 2017 HARPER PERKINS ARCHITECTS

P003

FIRE PROTECTION SYMBOL LEGEND																																																																																																											
GRAPHIC SYMBOLS	PIPE & FITTING SYMBOLS	VALVE SYMBOLS																																																																																																									
<div><div><div><div><div><div></div><div>N</div></div><div><div></div><div>1</div></div></div><div><div><div>DRAWING TITLE</div><div>TOP TITLE</div><div>BOTTOM TITLE</div></div><div><div>SCALE: 1/8" = 1'-0"</div><div>SCALE OF FLOOR PLAN, SECTION OR DETAIL</div><div>DETAIL NO. AND SHEET NO.</div></div></div><div><div><div>AREA OF ENLARGED PLAN OR DETAIL</div><div>1</div><div>P3.01</div></div><div><div>DETAIL NUMBER</div><div>SHEET NO. ON WHICH ENLARGED DETAIL IS DRAWN</div></div></div><div><div><div>SECTION NO.</div><div>A</div><div>P5.01</div></div><div><div>DIRECTION OF CUTTING PLANE</div><div>SHEET NO. ON WHICH THE SECTION IS DRAWN</div></div></div></div></div><div><div><div>4"</div><div>4" F</div><div>- OR -</div><div>4" F</div></div><div><div>SYSTEM SERVICE ABBREVIATION</div><div>NOMINAL PIPE SIZE (IN INCHES)</div></div></div></div>	<table><tr><th>DOUBLE LINE</th><th>SINGLE LINE</th><th>DESCRIPTION</th></tr><tr><td></td><td></td><td>PIPE</td></tr><tr><td></td><td></td><td>DIRECTION OF FLOW / SLOPE</td></tr><tr><td></td><td></td><td>PIPING WITH INSULATION (WHEN SHOWN FOR CLARITY)</td></tr><tr><td></td><td></td><td>UNION</td></tr><tr><td></td><td></td><td>GENERIC FLEXIBLE COUPLING (REFER TO SPECIFICATIONS)</td></tr><tr><td></td><td></td><td>ELBOW, 45 DEGREE (LONG RADIUS UON)</td></tr><tr><td></td><td></td><td>ELBOW, 90 DEGREE (LONG RADIUS UON)</td></tr><tr><td></td><td></td><td>ELBOW, 90 DEGREE - CHANGE IN DIRECTION TOWARD VIEWER</td></tr><tr><td></td><td></td><td>ELBOW, 90 DEGREE - CHANGE IN DIRECTION AWAY FROM VIEWER</td></tr><tr><td></td><td></td><td>TEE FITTING</td></tr><tr><td></td><td></td><td>TEE FITTING, BRANCH TOWARD VIEWER</td></tr><tr><td></td><td></td><td>TEE FITTING, BRANCH AWAY FROM VIEWER</td></tr><tr><td></td><td></td><td>LATERAL</td></tr><tr><td></td><td></td><td>REDUCER - CONCENTRIC</td></tr><tr><td></td><td></td><td>REDUCER - ECCENTRIC</td></tr><tr><td></td><td></td><td>CAP</td></tr><tr><td></td><td></td><td>ANCHOR</td></tr><tr><td></td><td></td><td>STRAINER - "Y" TYPE WITH BLOW DOWN</td></tr><tr><td></td><td></td><td>PRESSURE GAUGE WITH GAUGE COCK</td></tr><tr><td></td><td></td><td>PUMP, ARROW INDICATES FLOW</td></tr></table> <p>NOTE: WELDED FITTINGS ARE SHOWN FOR DOUBLE LINE PIPING. FITTINGS WITH OTHER END CONDITIONS ARE SIMILAR.</p>	DOUBLE LINE	SINGLE LINE	DESCRIPTION			PIPE			DIRECTION OF FLOW / SLOPE			PIPING WITH INSULATION (WHEN SHOWN FOR CLARITY)			UNION			GENERIC FLEXIBLE COUPLING (REFER TO SPECIFICATIONS)			ELBOW, 45 DEGREE (LONG RADIUS UON)			ELBOW, 90 DEGREE (LONG RADIUS UON)			ELBOW, 90 DEGREE - CHANGE IN DIRECTION TOWARD VIEWER			ELBOW, 90 DEGREE - CHANGE IN DIRECTION AWAY FROM VIEWER			TEE FITTING			TEE FITTING, BRANCH TOWARD VIEWER			TEE FITTING, BRANCH AWAY FROM VIEWER			LATERAL			REDUCER - CONCENTRIC			REDUCER - ECCENTRIC			CAP			ANCHOR			STRAINER - "Y" TYPE WITH BLOW DOWN			PRESSURE GAUGE WITH GAUGE COCK			PUMP, ARROW INDICATES FLOW	<table><tr><th>DOUBLE LINE</th><th>SINGLE LINE</th><th>DESCRIPTION</th></tr><tr><td></td><td></td><td>OS&Y GATE VALVE</td></tr><tr><td></td><td></td><td>BUTTERFLY VALVE</td></tr><tr><td></td><td></td><td>BALL VALVE</td></tr><tr><td></td><td></td><td>CHECK VALVE</td></tr><tr><td></td><td></td><td>BACKFLOW PREVENTER</td></tr><tr><td></td><td></td><td>PRESSURE REDUCING VALVE</td></tr><tr><td></td><td></td><td>PREACTION VALVE</td></tr><tr><td></td><td></td><td>DELUGE VALVE</td></tr><tr><td></td><td></td><td>ALARM CHECK VALVE</td></tr><tr><td></td><td></td><td>DRY PIPE VALVE</td></tr><tr><td></td><td></td><td>CONTROL VALVE W/ TAMPER SWITCH</td></tr><tr><td></td><td></td><td>TAMPER SWITCH</td></tr><tr><td></td><td></td><td>FLOW SWITCH</td></tr></table> <p>NOTE: WELDED FITTINGS ARE SHOWN FOR DOUBLE LINE PIPING. FITTINGS WITH OTHER END CONDITIONS ARE SIMILAR.</p>	DOUBLE LINE	SINGLE LINE	DESCRIPTION			OS&Y GATE VALVE			BUTTERFLY VALVE			BALL VALVE			CHECK VALVE			BACKFLOW PREVENTER			PRESSURE REDUCING VALVE			PREACTION VALVE			DELUGE VALVE			ALARM CHECK VALVE			DRY PIPE VALVE			CONTROL VALVE W/ TAMPER SWITCH			TAMPER SWITCH			FLOW SWITCH
DOUBLE LINE	SINGLE LINE	DESCRIPTION																																																																																																									
		PIPE																																																																																																									
		DIRECTION OF FLOW / SLOPE																																																																																																									
		PIPING WITH INSULATION (WHEN SHOWN FOR CLARITY)																																																																																																									
		UNION																																																																																																									
		GENERIC FLEXIBLE COUPLING (REFER TO SPECIFICATIONS)																																																																																																									
		ELBOW, 45 DEGREE (LONG RADIUS UON)																																																																																																									
		ELBOW, 90 DEGREE (LONG RADIUS UON)																																																																																																									
		ELBOW, 90 DEGREE - CHANGE IN DIRECTION TOWARD VIEWER																																																																																																									
		ELBOW, 90 DEGREE - CHANGE IN DIRECTION AWAY FROM VIEWER																																																																																																									
		TEE FITTING																																																																																																									
		TEE FITTING, BRANCH TOWARD VIEWER																																																																																																									
		TEE FITTING, BRANCH AWAY FROM VIEWER																																																																																																									
		LATERAL																																																																																																									
		REDUCER - CONCENTRIC																																																																																																									
		REDUCER - ECCENTRIC																																																																																																									
		CAP																																																																																																									
		ANCHOR																																																																																																									
		STRAINER - "Y" TYPE WITH BLOW DOWN																																																																																																									
		PRESSURE GAUGE WITH GAUGE COCK																																																																																																									
		PUMP, ARROW INDICATES FLOW																																																																																																									
DOUBLE LINE	SINGLE LINE	DESCRIPTION																																																																																																									
		OS&Y GATE VALVE																																																																																																									
		BUTTERFLY VALVE																																																																																																									
		BALL VALVE																																																																																																									
		CHECK VALVE																																																																																																									
		BACKFLOW PREVENTER																																																																																																									
		PRESSURE REDUCING VALVE																																																																																																									
		PREACTION VALVE																																																																																																									
		DELUGE VALVE																																																																																																									
		ALARM CHECK VALVE																																																																																																									
		DRY PIPE VALVE																																																																																																									
		CONTROL VALVE W/ TAMPER SWITCH																																																																																																									
		TAMPER SWITCH																																																																																																									
		FLOW SWITCH																																																																																																									
PIPING DESIGNATIONS	SPRINKLERS																																																																																																										
<div><div><div>4"</div><div>4" F</div><div>- OR -</div><div>4" F</div></div><div><div>SYSTEM SERVICE ABBREVIATION</div><div>NOMINAL PIPE SIZE (IN INCHES)</div></div></div>	<div><div><div>○</div><div>UPRIGHT</div></div><div><div>⊙</div><div>CONCEALED</div></div><div><div>●</div><div>PENDENT</div></div><div><div>⦿</div><div>PENDENT RECESSED</div></div><div><div>⦿</div><div>PENDENT EXTENDED COVERAGE</div></div><div><div>▽</div><div>HORIZONTAL SIDEWALL</div></div></div>																																																																																																										
MISCELLANEOUS SYMBOLS	HATCH DESIGNATIONS																																																																																																										
<div><div><div>XXX-1</div><div>EQUIPMENT DESIGNATION</div></div><div><div></div><div>SINGLE LINE PIPE BREAK</div></div><div><div></div><div>DOUBLE LINE PIPE BREAK</div></div><div><div></div><div>STANDARD BREAK</div></div><div><div></div><div>KEYED NOTE</div></div><div><div></div><div>REVISION DELTA</div></div><div><div></div><div>POINT OF DISCONNECTION</div></div><div><div></div><div>POINT OF CONNECTION (NEW TO EXISTING)</div></div><div><div></div><div>NEW ITEMS (PIPING/EQUIPMENT)</div></div><div><div></div><div>EXISTING ITEMS TO REMAIN</div></div><div><div></div><div>EXISTING ITEMS TO BE DEMOLISHED</div></div><div><div></div><div>LIMIT OF EXISTING ITEMS TO BE REMOVED</div></div><div><div></div><div>NEW CONNECTION TO EXISTING ITEM</div></div><div><div><div>(N)</div><div>NEW ITEM (NOTATION SHOWN AS NECESSARY FOR CLARIFICATION)</div></div><div><div>(E)</div><div>EXISTING ITEM TO REMAIN (NOTATION SHOWN AS NECESSARY FOR CLARIFICATION)</div></div><div><div>(F)</div><div>FUTURE ITEM (NOTATION SHOWN AS NECESSARY FOR CLARIFICATION)</div></div><div><div>(R)</div><div>EXISTING ITEM TO BE <u>RELOCATED</u> (NOTATION SHOWN AS NECESSARY FOR CLARIFICATION)</div></div><div><div>(D)</div><div>EXISTING ITEM TO BE <u>DEMOLISHED</u> (NOTATION SHOWN AS NECESSARY FOR CLARIFICATION)</div></div></div></div>	<div><div><div>REFER TO PLANS FOR ADDITIONAL INFORMATION</div><div><div></div><div>WET PIPE SPRINKLER SYSTEM</div></div><div><div></div><div>DRY SPRINKLER SYSTEM</div></div><div><div></div><div>CLEAN AGENT SYSTEM</div></div><div><div></div><div>PREACTION SYSTEM</div></div></div></div>																																																																																																										
EQUIPMENT																																																																																																											
<div><div><div>FDC</div><div></div><div>SIAMESE FIRE DEPARTMENT CONNECTION (ON BUILDING)</div></div><div><div>FDC</div><div></div><div>SIAMESE FIRE DEPARTMENT CONNECTION (FREESTANDING)</div></div><div><div>PIV</div><div></div><div>POST INDICATOR VALVE</div></div><div><div></div><div>WET FIRE SPRINKLER SYSTEM RISER</div></div></div>																																																																																																											
THIS IS A STANDARD LEGEND SHEET. SOME INFORMATION ON THIS SHEET MAY NOT NECESSARILY APPLY TO THIS PROJECT.																																																																																																											

FIRE PROTECTION GENERAL NOTES	
<div><div><div>1. PRIOR TO SUBMITTING A BID, THE FIRE PROTECTION SYSTEM CONTRACTOR SHALL VISIT THE JOB SITE AND VERIFY EXACT LOCATIONS OF UTILITIES IN FIELD. ALL EXISTING BUILDING CONDITIONS AND THAT NO WORK WILL BE REQUIRED OUTSIDE OF THE AREAS OF WORK SHOWN ON THE DRAWINGS.</div><div>2. THE FIRE PROTECTION SYSTEM CONTRACTOR SHALL BE RESPONSIBLE FOR OBTAINING AND VERIFYING A CURRENT WATER FLOW TEST AND PRESSURE DATA. THE DESIGN OF SHOP DRAWINGS AND, IF REQUIRED, PERFORMING HYDRAULIC CALCULATIONS. CONTRACTOR SHALL PROVIDE ALL WORK CUSTOMARILY INCLUDED IF NOT SPECIFICALLY CALLED FOR ON THE PLANS. PROVIDE ALL NECESSARY INFORMATION REGARDING THE EXISTING FIRE PROTECTION SYSTEM ON THE PLANS TO MAKE ALL CONDITIONS CLEAR. THE INSTALLATION AND DESIGN SHALL COMPLY WITH NFPA 13, LATEST EDITION AND ALL OTHER CITY, COUNTY AND STATE REGULATIONS.</div><div>3. THE FIRE PROTECTION SYSTEM CONTRACTOR SHALL SUBMIT THE SHOP DRAWINGS (WHICH SHALL INDICATE DESIGN CRITERIA USED TO ESTABLISH DESIGN DENSITIES I.E. OCCUPANCY USE, OCCUPANCY CLASSIFICATION, TYPE OF COMMODITY, COMMODITY CLASSIFICATION, STORAGE CONFIGURATION, MAXIMUM AVAILABLE HEIGHT FOR STORAGE, AND APPROPRIATE CODE REFERENCES), MANUFACTURER'S SPECIFICATIONS AND HYDRAULIC CALCULATIONS, IF REQUIRED, TO THE LOCAL AUTHORITY HAVING JURISDICTION FOR REVIEW, APPROVAL AND PERMITTING PRIOR TO INSTALLATION OR MODIFICATION OF THE AUTOMATIC SPRINKLER SYSTEM. ALL DRAWINGS AND CALCULATIONS SHALL BE SIGNED AND SEALED BY THE FIRE PROTECTION SYSTEM CONTRACTOR'S REGISTERED FIRE PROTECTION ENGINEER. THE ARCHITECT SHALL RECEIVE TWO COPIES OF THE SHOP DRAWINGS, MANUFACTURER'S SPECIFICATIONS AND REQUIRED HYDRAULIC CALCULATIONS FOR THEIR RECORDS.</div><div>4. THE FIRE PROTECTION SYSTEM CONTRACTOR SHALL VERIFY INSTALLATIONS AND OBSTRUCTIONS OF ALL TRADES AND SHALL COORDINATE ALL FIRE PROTECTION WORK WITH OTHER TRADES, NEW AND EXISTING, AND ROUTE PIPING TO AVOID INTERFERENCES.</div><div>5. THE FIRE PROTECTION SYSTEM CONTRACTOR SHALL BE RESPONSIBLE FOR ALL FEES, PERMITS AND INSPECTIONS REQUIRED TO PERFORM THE WORK DESCRIBED IN THE CONTRACT DOCUMENTS AND SHOP DRAWINGS.</div><div>6. THE FIRE PROTECTION SYSTEM CONTRACTOR, PER NFPA 13, LATEST EDITION, SHALL PERFORM ALL REQUIRED ACCEPTANCE TESTS, COMPLETE THE CONTRACTOR'S MATERIAL AND TEST CERTIFICATES, AND FORWARD THE CERTIFICATES TO THE AUTHORITY HAVING JURISDICTION PRIOR TO ASKING FOR APPROVAL OF THE INSTALLATION.</div><div>7. THE FIRE PROTECTION SYSTEM CONTRACTOR, AFTER EXAMINATION OF ALL EXISTING CONDITIONS, PLANS AND SPECIFICATIONS, SHALL INCLUDE ALL COSTS NECESSARY FOR ALTERATION, MODIFICATIONS, AND/OR ADDITIONS TO THE FIRE SPRINKLER SYSTEM NECESSARY TO MAKE THE COMPLETE AND FINISHED INSTALLATION IN ALL ASPECTS. IT IS THE INTENT THAT ALL COSTS FOR THE WORK REQUIRED BE IN THE BID OF THIS TRADE.</div><div>8. ALL MATERIAL (SPRINKLER HEADS, PIPING, FITTINGS, ETC.) SHALL BE IN CONFORMANCE WITH NFPA 13, LATEST EDITION, AND ALL OTHER APPLICABLE CODES.</div><div>9. ALL SHUTDOWNS OF THE EXISTING FIRE SPRINKLER SYSTEM TO PERFORM THE WORK UNDER THIS CONTRACT SHALL BE COORDINATED WITH THE BUILDING OWNER/ENGINEERING DEPARTMENT TO MINIMIZE OR AVOID INCONVENIENCE TO THE BUILDING TENANTS.</div><div>10. THE SPRINKLER HEADS SHOWN ON THE DRAWING ARE FOR REFERENCE ONLY. MORE HEADS MAY BE NECESSARY FOR THE DESIGN TO COMPLY WITH ALL CODES AND STANDARDS. ALL SPRINKLER HEADS SHALL BE CENTERED IN BOTH DIRECTIONS OF THE ACOUSTICAL TILE. PROVIDE ARMOVERS OR SWING JOINTS AS REQUIRED.</div><div>11. THE METHODS OF HANGING PIPE, HEADERS AND BRANCHES SHALL BE APPROVED BY NFPA 13, LATEST EDITION. ALL PIPING SHALL BE FIRMLY ANCHORED AND SUPPORTED TO PREVENT SWAY AND VIBRATION THE ENTIRE LENGTH. PROVIDE DETAIL AND INDICATE TYPE OF HANGER TO BE INSTALLED FOR THE FIRE PROTECTION SYSTEM PIPING.</div><div>12. PROVIDE FIRE RATED SLEEVES AND UL LISTED FIRESTOPPING AT ALL PENETRATIONS OF SMOKE/FIRE WALLS, CEILINGS, ROOFS, ETC. FLASH AND COUNTER FLASH ROOF PENETRATIONS.</div><div>13. INDICATE CENTER TO CENTER DIMENSIONS, PIPE CUT LENGTHS AND NOMINAL PIPE DIAMETERS ON ALL PIPING.</div><div>14. REFER TO AND COORDINATE WITH THE ARCHITECTURAL REFLECTED CEILING PLANS FOR CEILING TYPES, HEIGHTS AND OTHER CEILING MOUNTED DEVICES. THE OWNER AND THE ARCHITECT RESERVE THE RIGHT TO MODIFY HEAD LOCATIONS TO CREATE AN AESTHETIC DESIGN.</div><div>15. ROUTE ALL PIPING CONCEALED ABOVE CEILINGS, WITHIN WALLS, IN MECHANICAL ROOMS, OR IN CHASES EXCEPT AS SPECIFICALLY NOTED.</div><div>16. COORDINATE LOCATION OF ANY NEW OR RELOCATED SIAMESE CONNECTIONS WITH ARCHITECT, SITE LAYOUT, AND FIRE DEPARTMENT. PROVIDE REMOTE SIAMESE CONNECTIONS AS REQUIRED FOR FIRE DEPARTMENT ACCESS FROM DRIVE.</div></div></div>	<div><div><div>17. LOCATION OF NEW OR RELOCATED INSPECTORS TEST STATIONS, ISOLATION VALVES AND DRAIN DOWN VALVES SHALL BE COORDINATED AS TO MINIMIZE PLACEMENT OF THESE DEVICES INSIDE TENANT SPACES. PROVIDE DRAIN DOWN VALVES FOR ANY AND ALL TRAPPED SECTION OF PIPING PER NFPA 13, LATEST EDITION. WHERE VALVES ARE REQUIRED IN TENANT SPACES, LOCATE IN A SERVICE OR STORAGE AREA. EACH SPRINKLER ZONE IS TO HAVE DRAIN DOWN VALVES CONFIGURED SO AS TO ALLOW ATTACHMENT OF A DRAIN HOSE. ALL DISCHARGE SHALL BE ARRANGED TO MINIMIZE DAMAGE TO THE BUILDING. ALL DRAIN PIPING SHALL BE GALVANIZED. PROVIDE ACCESS PANELS TO ANY VALVES ABOVE NON-ACCESSIBLE CEILING AND IN CHASES. ALL DRAIN DOWN VALVES AND INSPECTOR'S TEST STATION VALVES SHALL BE CHAINED AND PADLOCKED.</div><div>18. ALL ISOLATION VALVES SHALL BE SUPERVISED. PROVIDE TAMPER SWITCHES ON ALL CONTROL VALVES. COORDINATE WITH FIRE ALARM CONTRACTOR.</div><div>19. SPRINKLER HEADS MOUNTED LESS THAN 7 FEET ABOVE FINISHED FLOOR SHALL BE PROTECTED WITH A WIRE CAGE TYPE GUARD.</div><div>20. SPRINKLER CONTRACTOR SHALL INSTALL AND ACTIVATE THE ENTIRE SPRINKLER SYSTEM PRIOR TO THE ISSUANCE OF THE SUBSTANTIAL COMPLETION.</div><div>21. ALL FIRE PROTECTION SYSTEMS SHALL BE TESTED AS REQUIRED PER NFPA 13, LATEST EDITION AND LOCAL AUTHORITY HAVING JURISDICTION BEFORE ANY SYSTEMS ARE CONCEALED.</div><div>22. CONTRACTOR SHALL CONDUCT HYDROSTATIC TESTS IN COMPLIANCE WITH NFPA 13, LATEST EDITION (TWO HOUR AT 200 PSI OR 100 PSI OVER NORMAL SYSTEM PRESSURE MINIMUM), PIPING SUBJECT TO FREEZING DURING TEST PERIOD SHALL BE TESTED WITH COMPRESSED AIR.</div><div>23. CERTIFICATES OF APPROVAL OF INSTALLATION SHALL BE OBTAINED FROM THE AUTHORITY HAVING JURISDICTION AND FORWARDED TO THE OWNER.</div><div>24. THE FINAL INSPECTION AND APPROVAL OF THE FIRE PROTECTION SYSTEM SHALL BE BY THE LOCAL FIRE MARSHAL.</div><div>25. AFTER TESTS ARE CONDUCTED AND ANY REPAIRS COMPLETED, COMPLETELY FLUSH THE PIPING SYSTEMS WITH WATER UNTIL DISCHARGE SHOWS NO DISCOLORATION.</div><div>26. ALL BRANCH PIPING CONNECTIONS SHALL BE MADE AT THE TOP OR SIDE OF THE MAIN. BOTTOM CONNECTIONS ARE NOT ACCEPTABLE.</div><div>27. CONTRACTOR SHALL COORDINATE WITH GENERAL CONTRACTOR FOR REMOVAL OF HVAC DIFFUSERS/GRILLES, LIGHTING, FIRE ALARM, ETC. TYPE DEVICES TO ALLOW FOR INSTALLATION OF FIRE PROTECTION SYSTEM.</div></div></div>

<div><div><div><div><div></div><div>NIPPLE</div></div><div><div></div><div>REDUCER</div></div></div><div><div><div>1'-3/4"</div><div>CEILING</div><div>SURFACE MOUNTED ESCUTCHEON PLATE</div><div>PENDENT SPRINKLER</div></div></div></div></div>	<div><div><div><div><div></div><div>CEILING</div></div><div><div></div><div>4" TO 6"</div></div></div><div><div><div>SIDEWALL DEFLECTOR</div><div>SIDEWALL SPRINKLER</div></div><div><div>2-1/2"</div><div>WALL</div></div></div></div><div><div><div>ESCUTCHEON PLATE</div><div>REDUCER</div><div>NIPPLE</div></div></div></div>
<div><div><div>PENDENT SPRINKLER DETAIL</div><div>NOT TO SCALE</div></div></div>	<div><div><div>SIDEWALL SPRINKLER DETAIL</div><div>NOT TO SCALE</div></div></div>

DATE SIGNED:

HARPER PERKINS ARCHITECTS, INC.
4724 OLD JACKSBORO HIGHWAY
WICHITA FALLS, TEXAS 76302-3599
VOICE: 940.787.1421 Fax: 940.397.0273
E-MAIL: office@harperperkins.com WEB: www.harperperkins.com

CAMPOS
ENGINEERING, Inc.
Consulting Engineers
1331 River Bend Drive
Dallas, Texas 75247
(214) 696-6291
campos@camposengineering.com
Registration No. F-001731
CEI Project Number D17-1263.00

TASADA - FIRE MARSHAL DEFERRED MAINTENANCE PROJECTS FOR

MIDWESTERN STATE UNIVERSITY

3410 TAFT BOULEVARD
WICHITA FALLS, TEXAS

DRAWN BY:

DATE: 15 MAY 2017



REVISIONS

NO.	DESCRIPTION	DATE
1	ADDENDUM 2	08/10/17

16782.00

© 2017 HARPER PERKINS ARCHITECTS

FP001

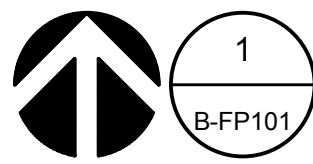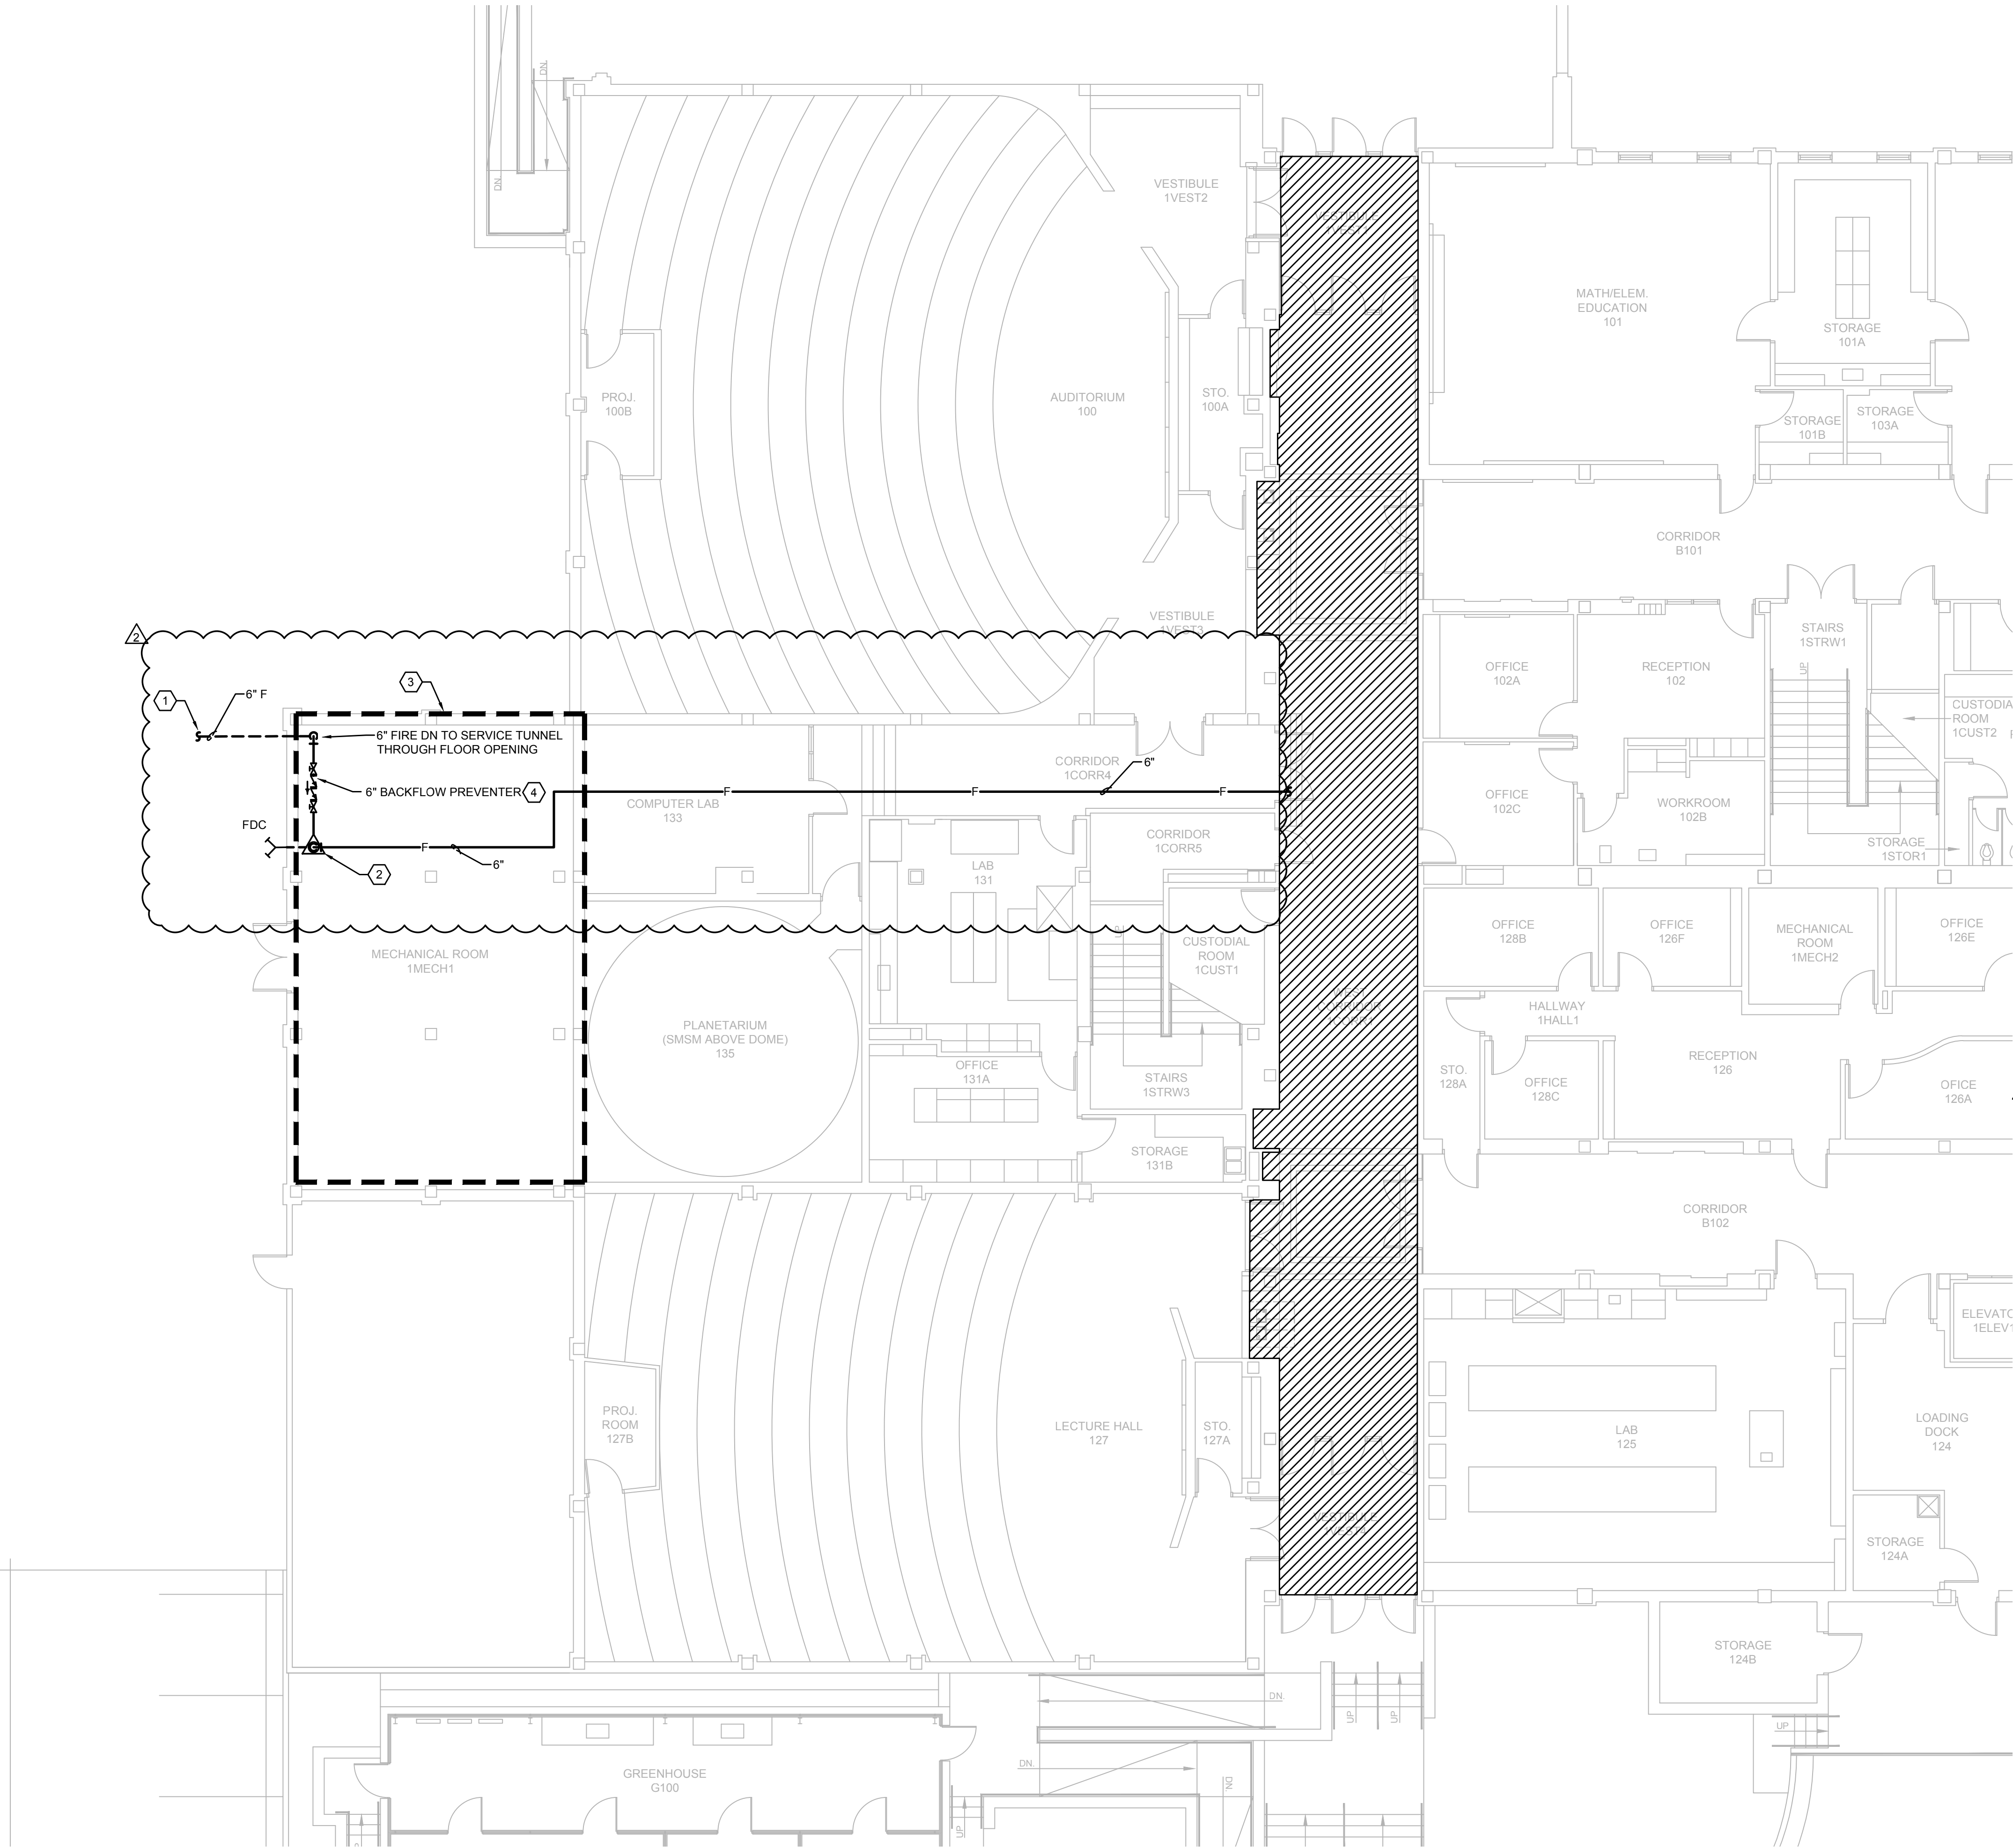

BOLIN SCIENCE HALL - FIRST FLOOR - AREA 1C
FIRE PROTECTION PLAN

SCALE: 1/8" = 1'-0"

GENERAL NOTES


(NOT ALL NOTES APPLY TO EACH SHEET)

- REFER TO SYMBOL LEGEND AND GENERAL NOTES.
- REFER TO SPECIFICATIONS.
- REFER TO ARCHITECTURAL OVERALL FLOOR PLANS FOR LOCATIONS SCOPE OF WORK AREAS WITHIN THE BUILDING.


KEY NOTES

(NOT ALL NOTES APPLY TO EACH SHEET)

- CONNECT NEW 6" FIRE LINE TO MAIN WATER SERVICE LINE. INSULATE THIS NEW FIRE LINE WITH 2" ARMAFLEX CLOSED CELL FOAM INSULATION INSIDE THE SERVICE TUNNEL, APPROXIMATELY 100 FT. REFER TO SHEET B-E101 FOR ELECTRICAL INFORMATION. FIELD VERIFY EXACT LOCATION OF THE EXISTING WATER MAIN. CONTRACTOR TO COORDINATE EXACT LOCATION OF TIE-INS WITH MSU STAFF.
- NEW FIRE 6" RISER TO SERVE CORRIDOR 1CORR1 AND FUTURE EXPANSION OF THE FIRE SPRINKLER COVERAGE IN THE BUILDING. REFER TO DETAIL 2/B-FP101. THE LOCATION OF THE FIRE RISER IN THIS SPACE IS DIAGRAMMATIC IN NATURE AND CONTRACTOR HAS OPTION TO ALTER FIRE RISER LOCATION IN THIS SPACE AS NEEDED.
- PER FIRE PROTECTION GENERAL NOTES ON SHEET FP001, CONTRACTOR TO COORDINATE FIRE PROTECTION PIPE ROUTING WITH EXISTING FIELD CONDITIONS (EQUIPMENT, DUCTS, PIPE, SPACE RESTRICTIONS, ETC). THE PIPE ROUTING IN THIS SPACE IS DIAGRAMMATIC IN NATURE AND CONTRACTOR HAS OPTION TO ALTER ROUTING IN THIS SPACE AS NEEDED.
- HORIZONTAL BACKFLOW PREVENTOR SHOWN FOR DIAGRAMMATIC PURPOSES. RECOMMEND USING VERTICAL BACKFLOW PREVENTOR DUE TO SPACE CONSTRAINTS.

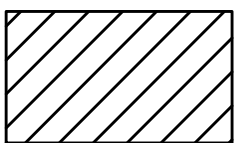


WET TYPE SPRINKLER SYSTEM.

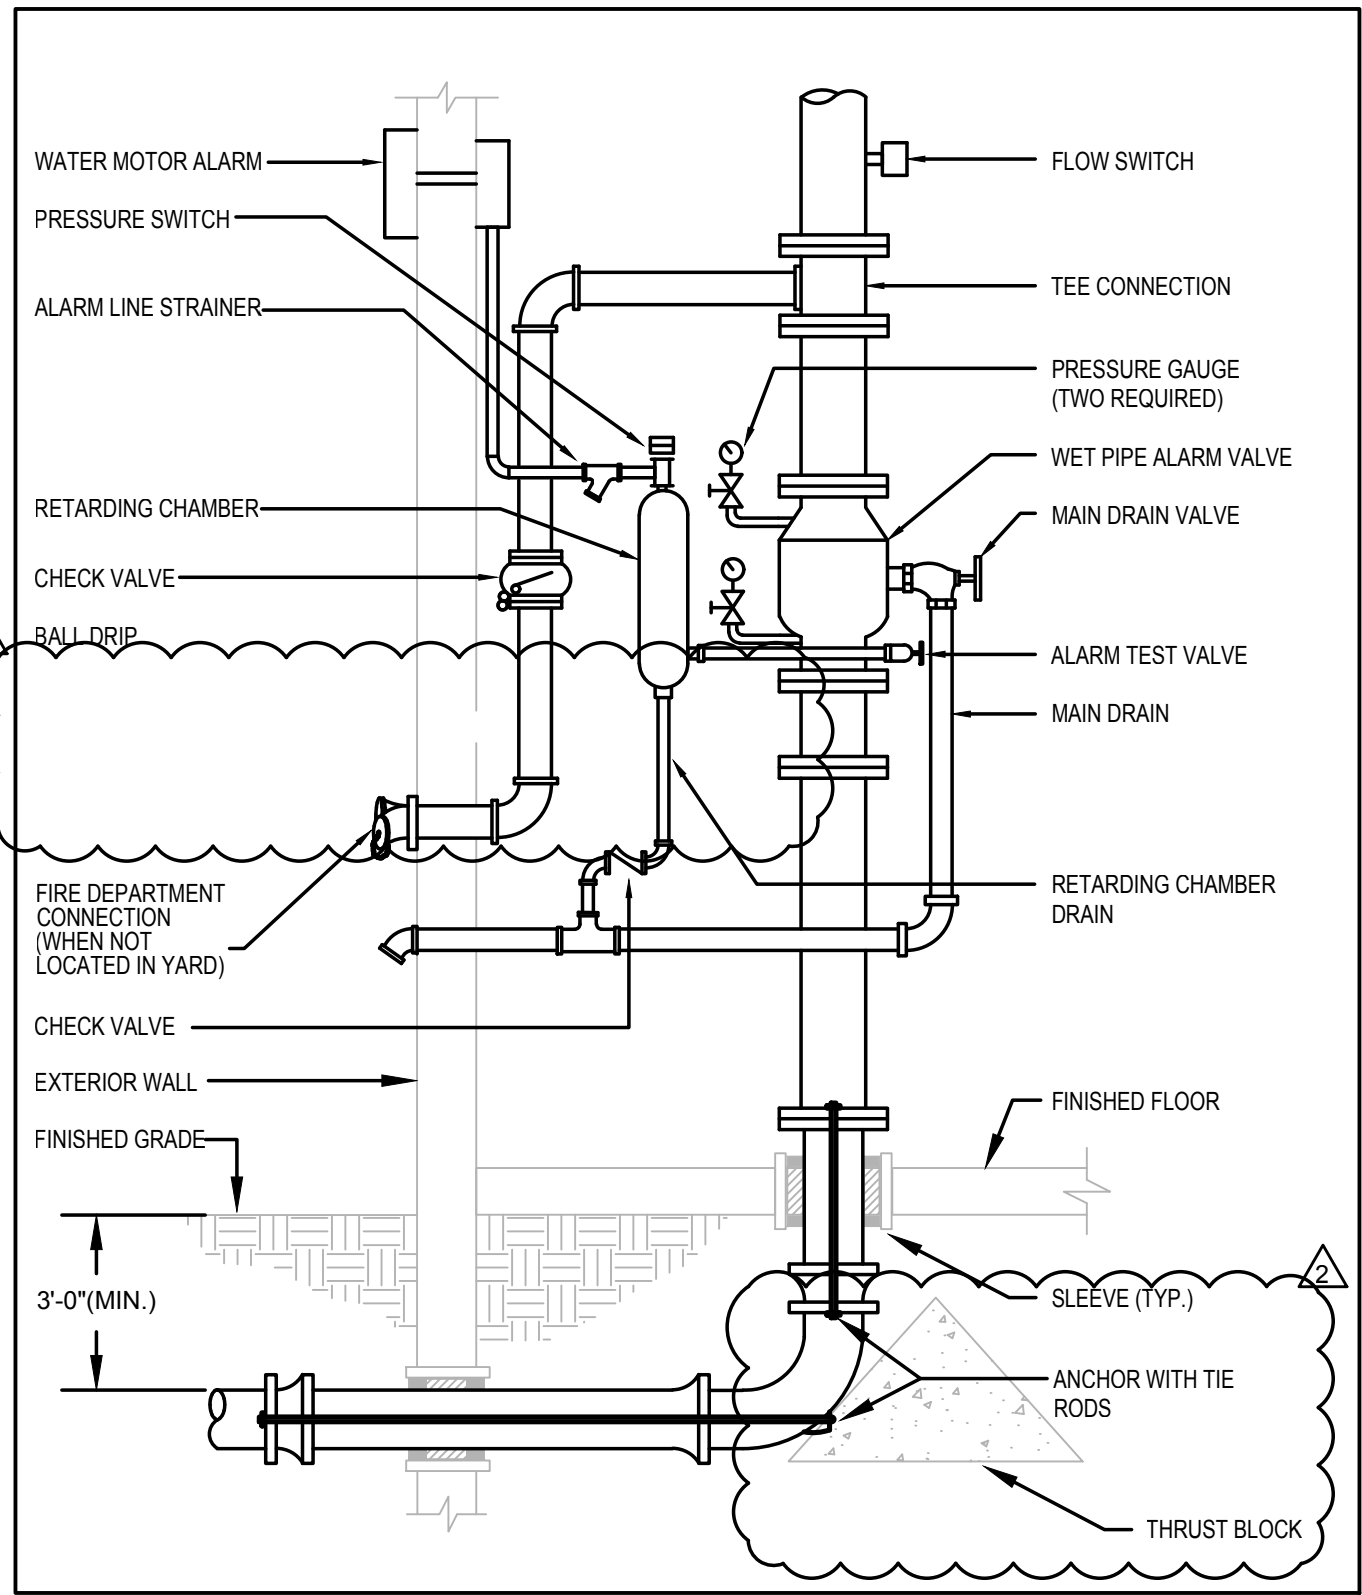

2 TYPICAL FIRE RISER DETAIL

SCALE: NONE

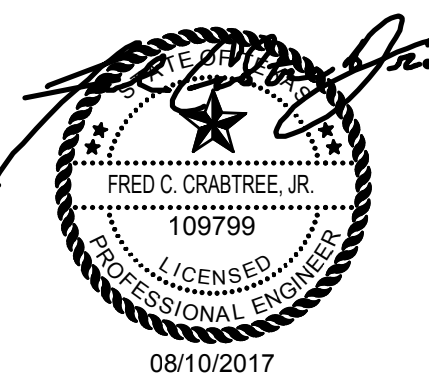

DATE SIGNED:



ARCHITECTS - PROGRAMMERS - PLANNERS
HARPER PERKINS ARCHITECTS, INC.
4724 OLD JACKSBORO HIGHWAY
WICHITA FALLS, TEXAS 76302-3599
VOICE: 940.787.1421 FAX: 940.397.0273
E-MAIL: office@harperperkins.com WEB: www.harperperkins.com

CAMPOS
ENGINEERING, Inc.
Consulting Engineers



1331 River Bend Drive
Dallas, Texas 75247
campos@camposengineering.com
Registration No. F-001731
CEI Project Number D17-1263.00

TASADA - FIRE MARSHAL DEFERRED MAINTENANCE PROJECTS FOR
MIDWESTERN STATE

UNIVERSITY

WICHITA FALLS, TEXAS

3410 TAFT BOULEVARD



DRAWN BY:

DATE: 15 MAY 2017


REVISIONS


NO.	DESCRIPTION	DATE
1	ADDENDUM 1	08/02/17
2	ADDENDUM 2	08/10/17

16782.00

© 2017 HARPER PERKINS ARCHITECTS

B-FP101

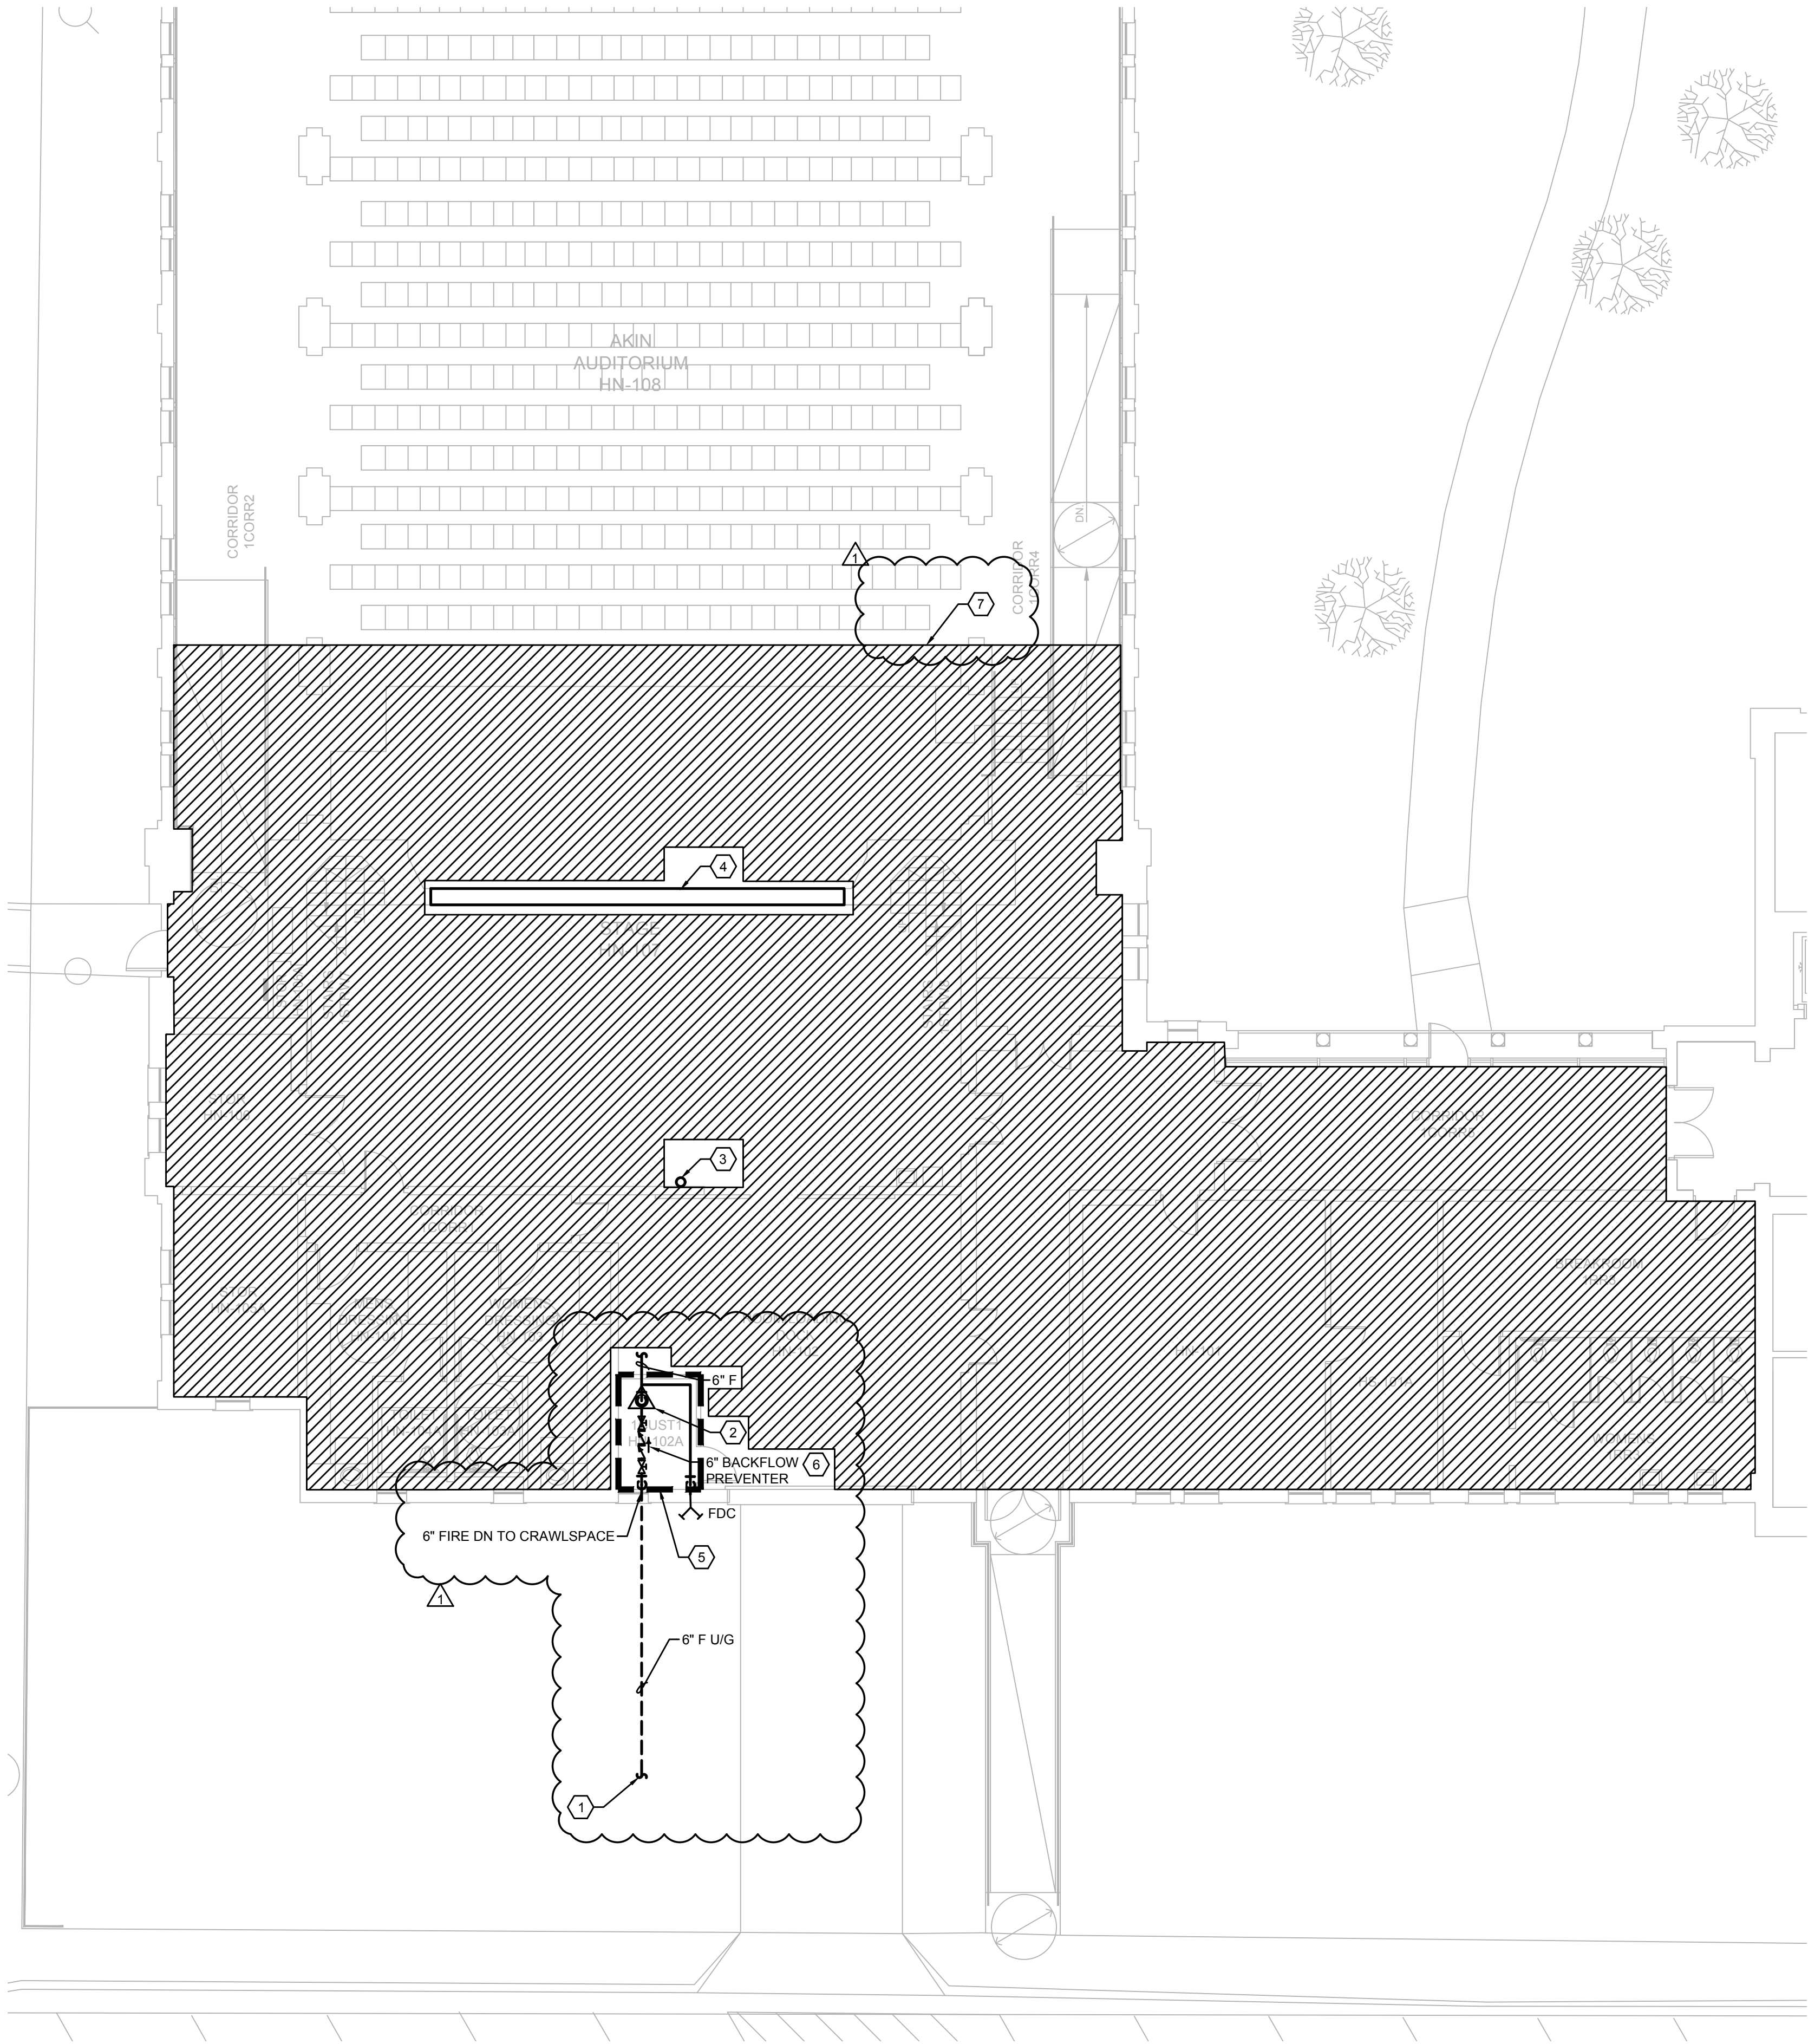



1

H-FP101

SCALE: 1/8" = 1'-0"

HARDIN ADMIN BUILDING - FIRST FLOOR - AREA 1A

FIRE PROTECTION PLAN

GENERAL NOTES

(NOT ALL NOTES APPLY TO EACH SHEET)

A. REFER TO SYMBOL LEGEND AND GENERAL NOTES.

B. REFER TO SPECIFICATIONS.

C. REFER TO ARCHITECTURAL OVERALL FLOOR PLANS FOR LOCATIONS SCOPE OF WORK AREAS WITHIN THE BUILDING.

KEY NOTES

(NOT ALL NOTES APPLY TO EACH SHEET)

1. CONNECT NEW 6" FIRE LINE TO MAIN WATER SERVICE LINE. FIELD VERIFY EXACT LOCATION OF SAID EXISTING WATER MAIN. CONTRACTOR TO COORDINATE EXACT LOCATION OF TIE-INS WITH MSU STAFF.

2. NEW FIRE 6" RISER TO SERVE AREA NOTED. REFER TO DETAIL 2/B-FP101. THE FIRE RISER LOCATION IN THIS SPACE IS DIAGRAMMATIC IN NATURE AND CONTRACTOR HAS OPTION TO ALTER LOCATION OF THE FIRE RISER IN THIS SPACE AS NEEDED.


3. 2 1/2" FIRE DOWN FOR SERVE HOSE BOX. CONNECT TO FIRE SPRINKLER PIPE SERVING THAT AREA. CONTRACTOR TO CONSULT WITH LOCAL FIRE DEPARTMENT FOR REQUIRED HOSE BOX TYPE AND APPROVED MANUFACTURERS.

4. INSTALL NEW WATERFALL CURTAIN AT PROSCENIUM OPENING.


5. PER FIRE PROTECTION GENERAL NOTES ON SHEET FP001, CONTRACTOR TO COORDINATE FIRE PROTECTION PIPE ROUTING WITH EXISTING FIELD CONDITIONS (EQUIPMENT, DUCTS, PIPE, SPACE RESTRICTIONS ETC). THE PIPE ROUTING IN THIS SPACE IS DIAGRAMMATIC IN NATURE AND CONTRACTOR HAS OPTION TO ALTER ROUTING IN THIS SPACE AS NEEDED.

6. HORIZONTAL BACKFLOW PREVENTOR SHOWN FOR DIAGRAMMATIC PURPOSES. RECOMMEND USING VERTICAL BACKFLOW PREVENTOR DUE TO SPACE CONSTRAINTS.

7. PROVIDE FIRE SPRINKLER SYSTEM FOR AREA UNDERNEATH THE STAGE AS PART OF **ALTERNATE #2**.



DATE SIGNED:



ARCHITECTS PROGRAMMERS PLANNERS


HARPER PERKINS ARCHITECTS, INC.

4724 OLD JACKSBORO HIGHWAY

WICHITA FALLS, TEXAS 76302-3599

VOICE: 940.787.1421 FAX: 940.387.0273

E-MAIL: office@harpereperkins.com WEB: www.harpereperkins.com



CAMPOS ENGINEERING, Inc.

Consulting Engineers

1331 River Bend Drive

Dallas, Texas 75247

(214) 696-6291

campos@camposengineering.com

Registration No. F-001731

CEI Project Number D17-1263.00

TAS/ADA - FIRE MARSHAL DEFERRED MAINTENANCE PROJECTS FOR

MIDWESTERN STATE UNIVERSITY

3410 TAFT BOULEVARD

WICHITA FALLS, TEXAS

DRAWN BY:		
DATE: 15 MAY 2017		
REVISIONS		
NO.	DESCRIPTION	DATE
Δ	ADDENDUM 2	08/10/17

16782.00

© 2017 HARPER PERKINS ARCHITECTS

H-FP101